
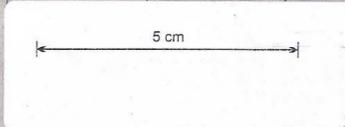


ABERF\_733

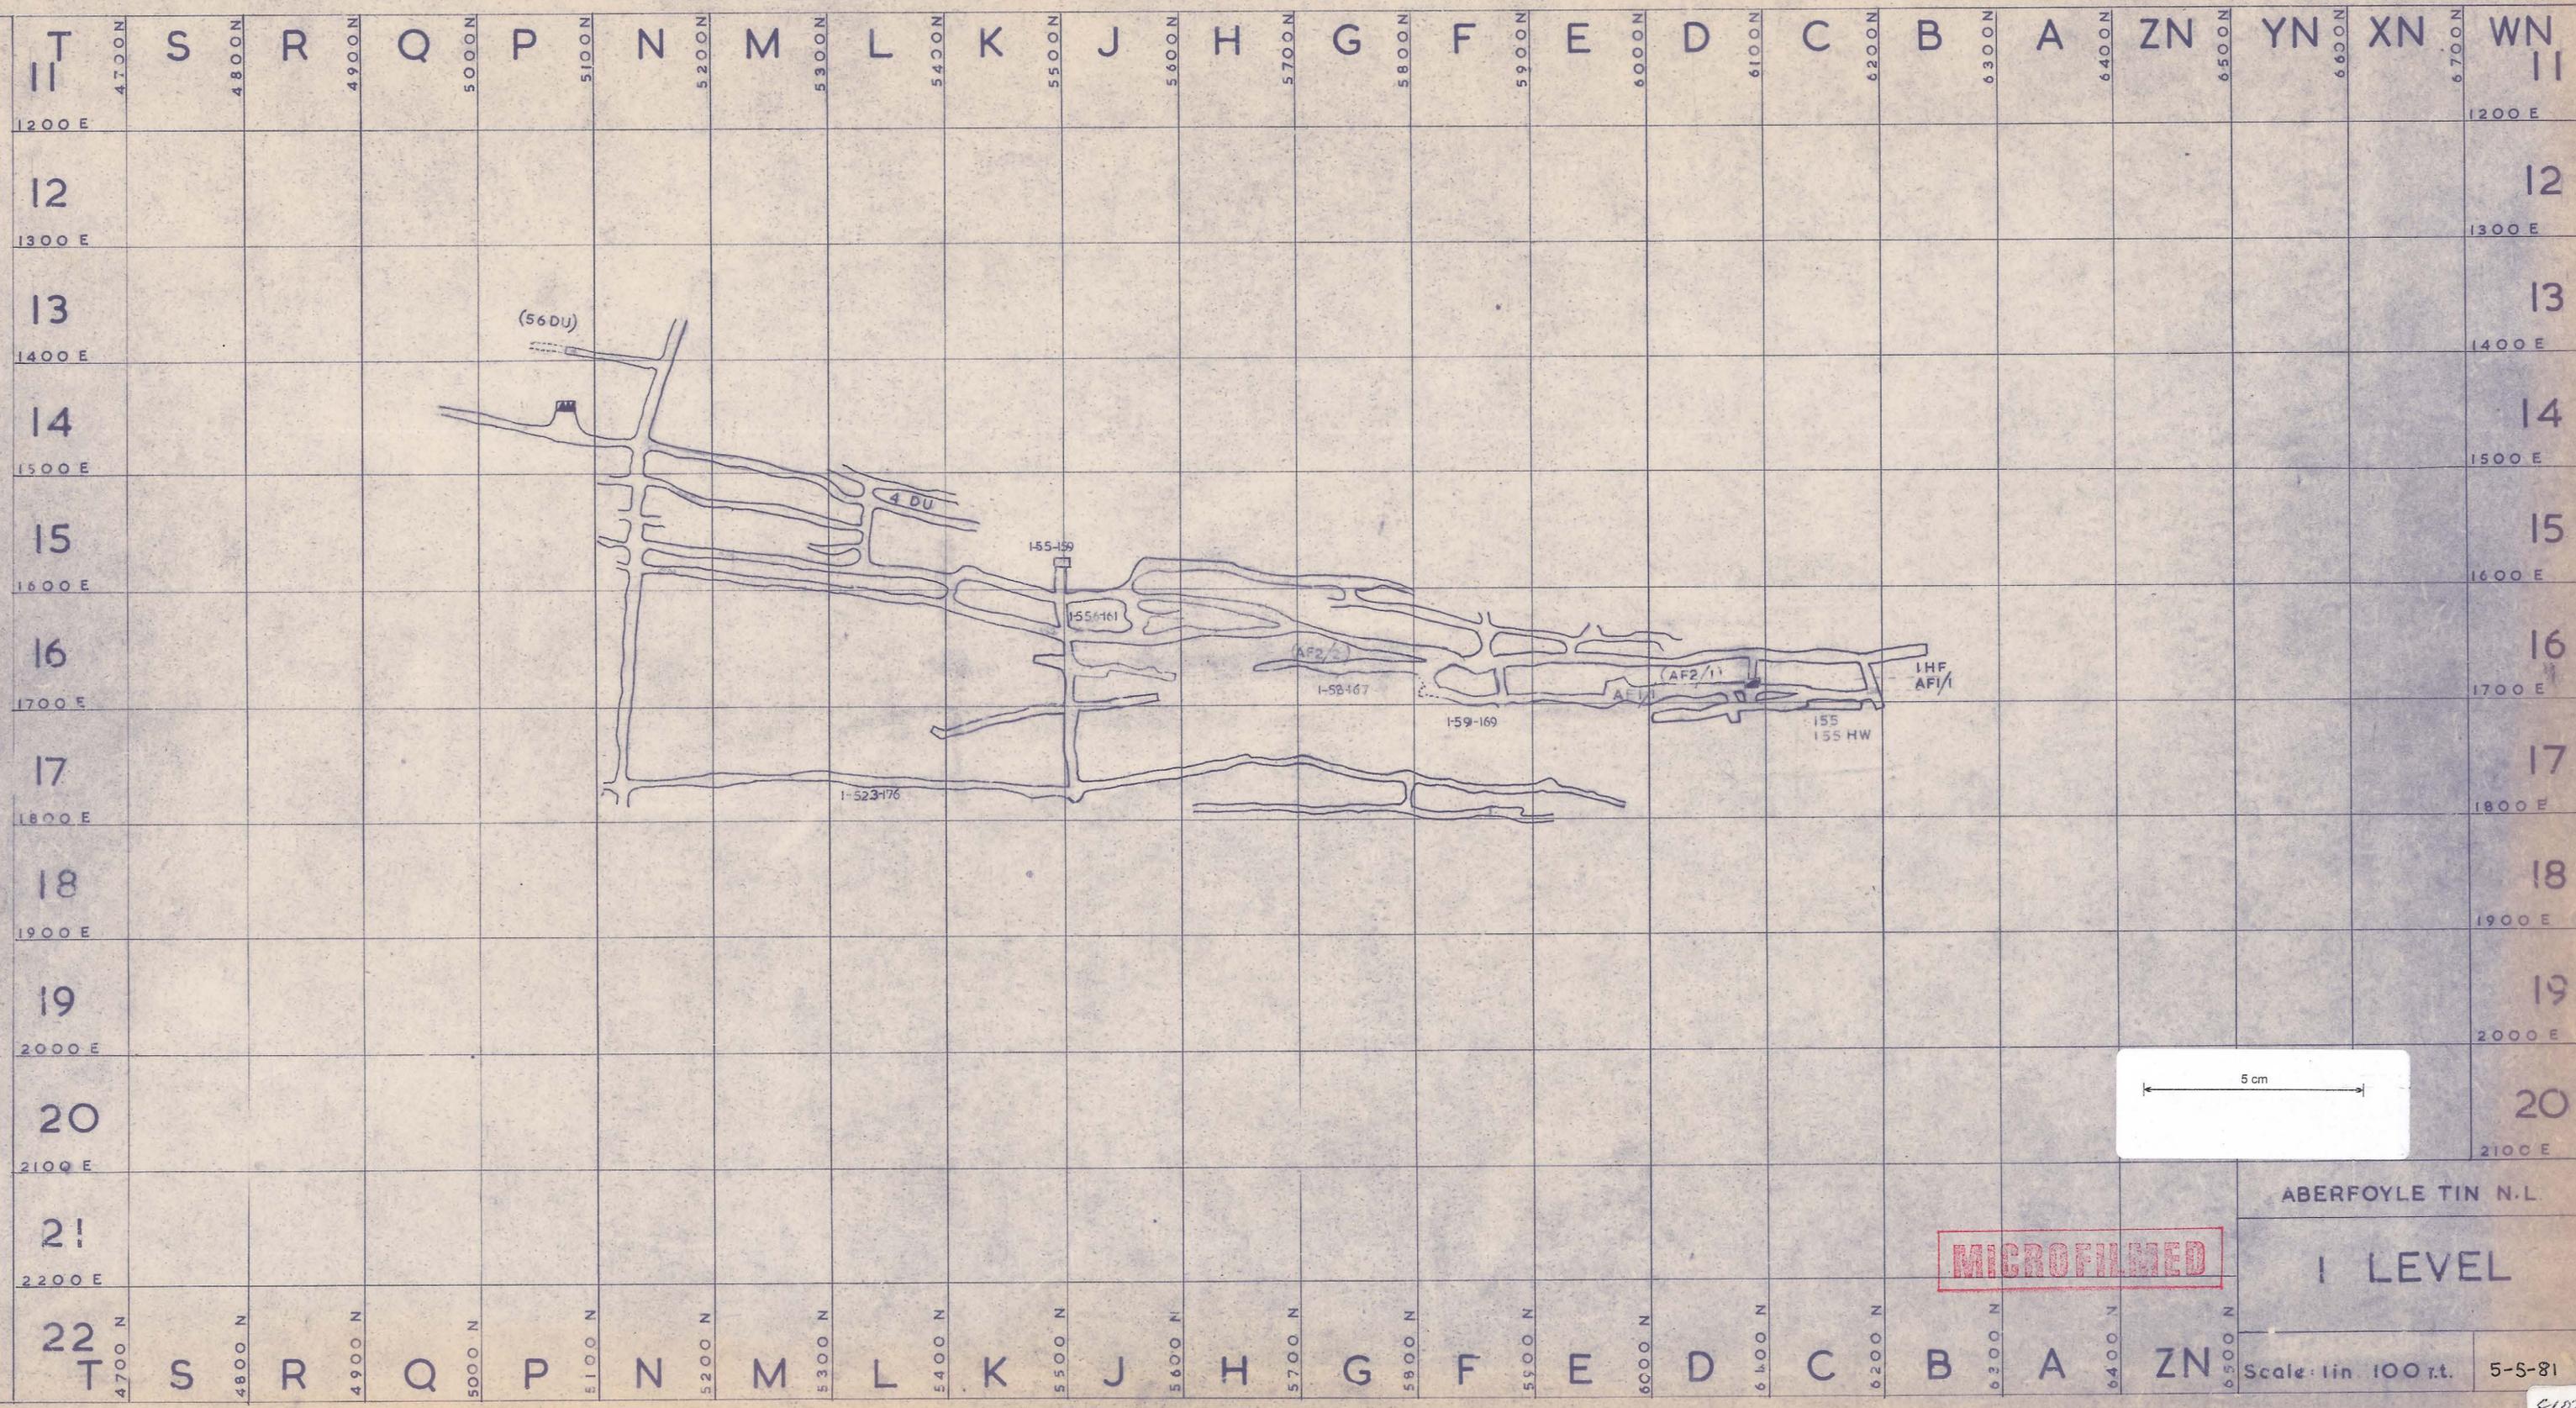

**MICROFILMED**

ABERFOYLE TIN N.L.

I LEVEL

Scale: 1 in 100 ft.

5-5-81

81070