
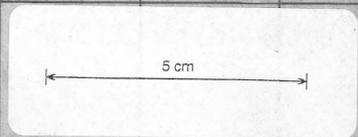


ABERF_737

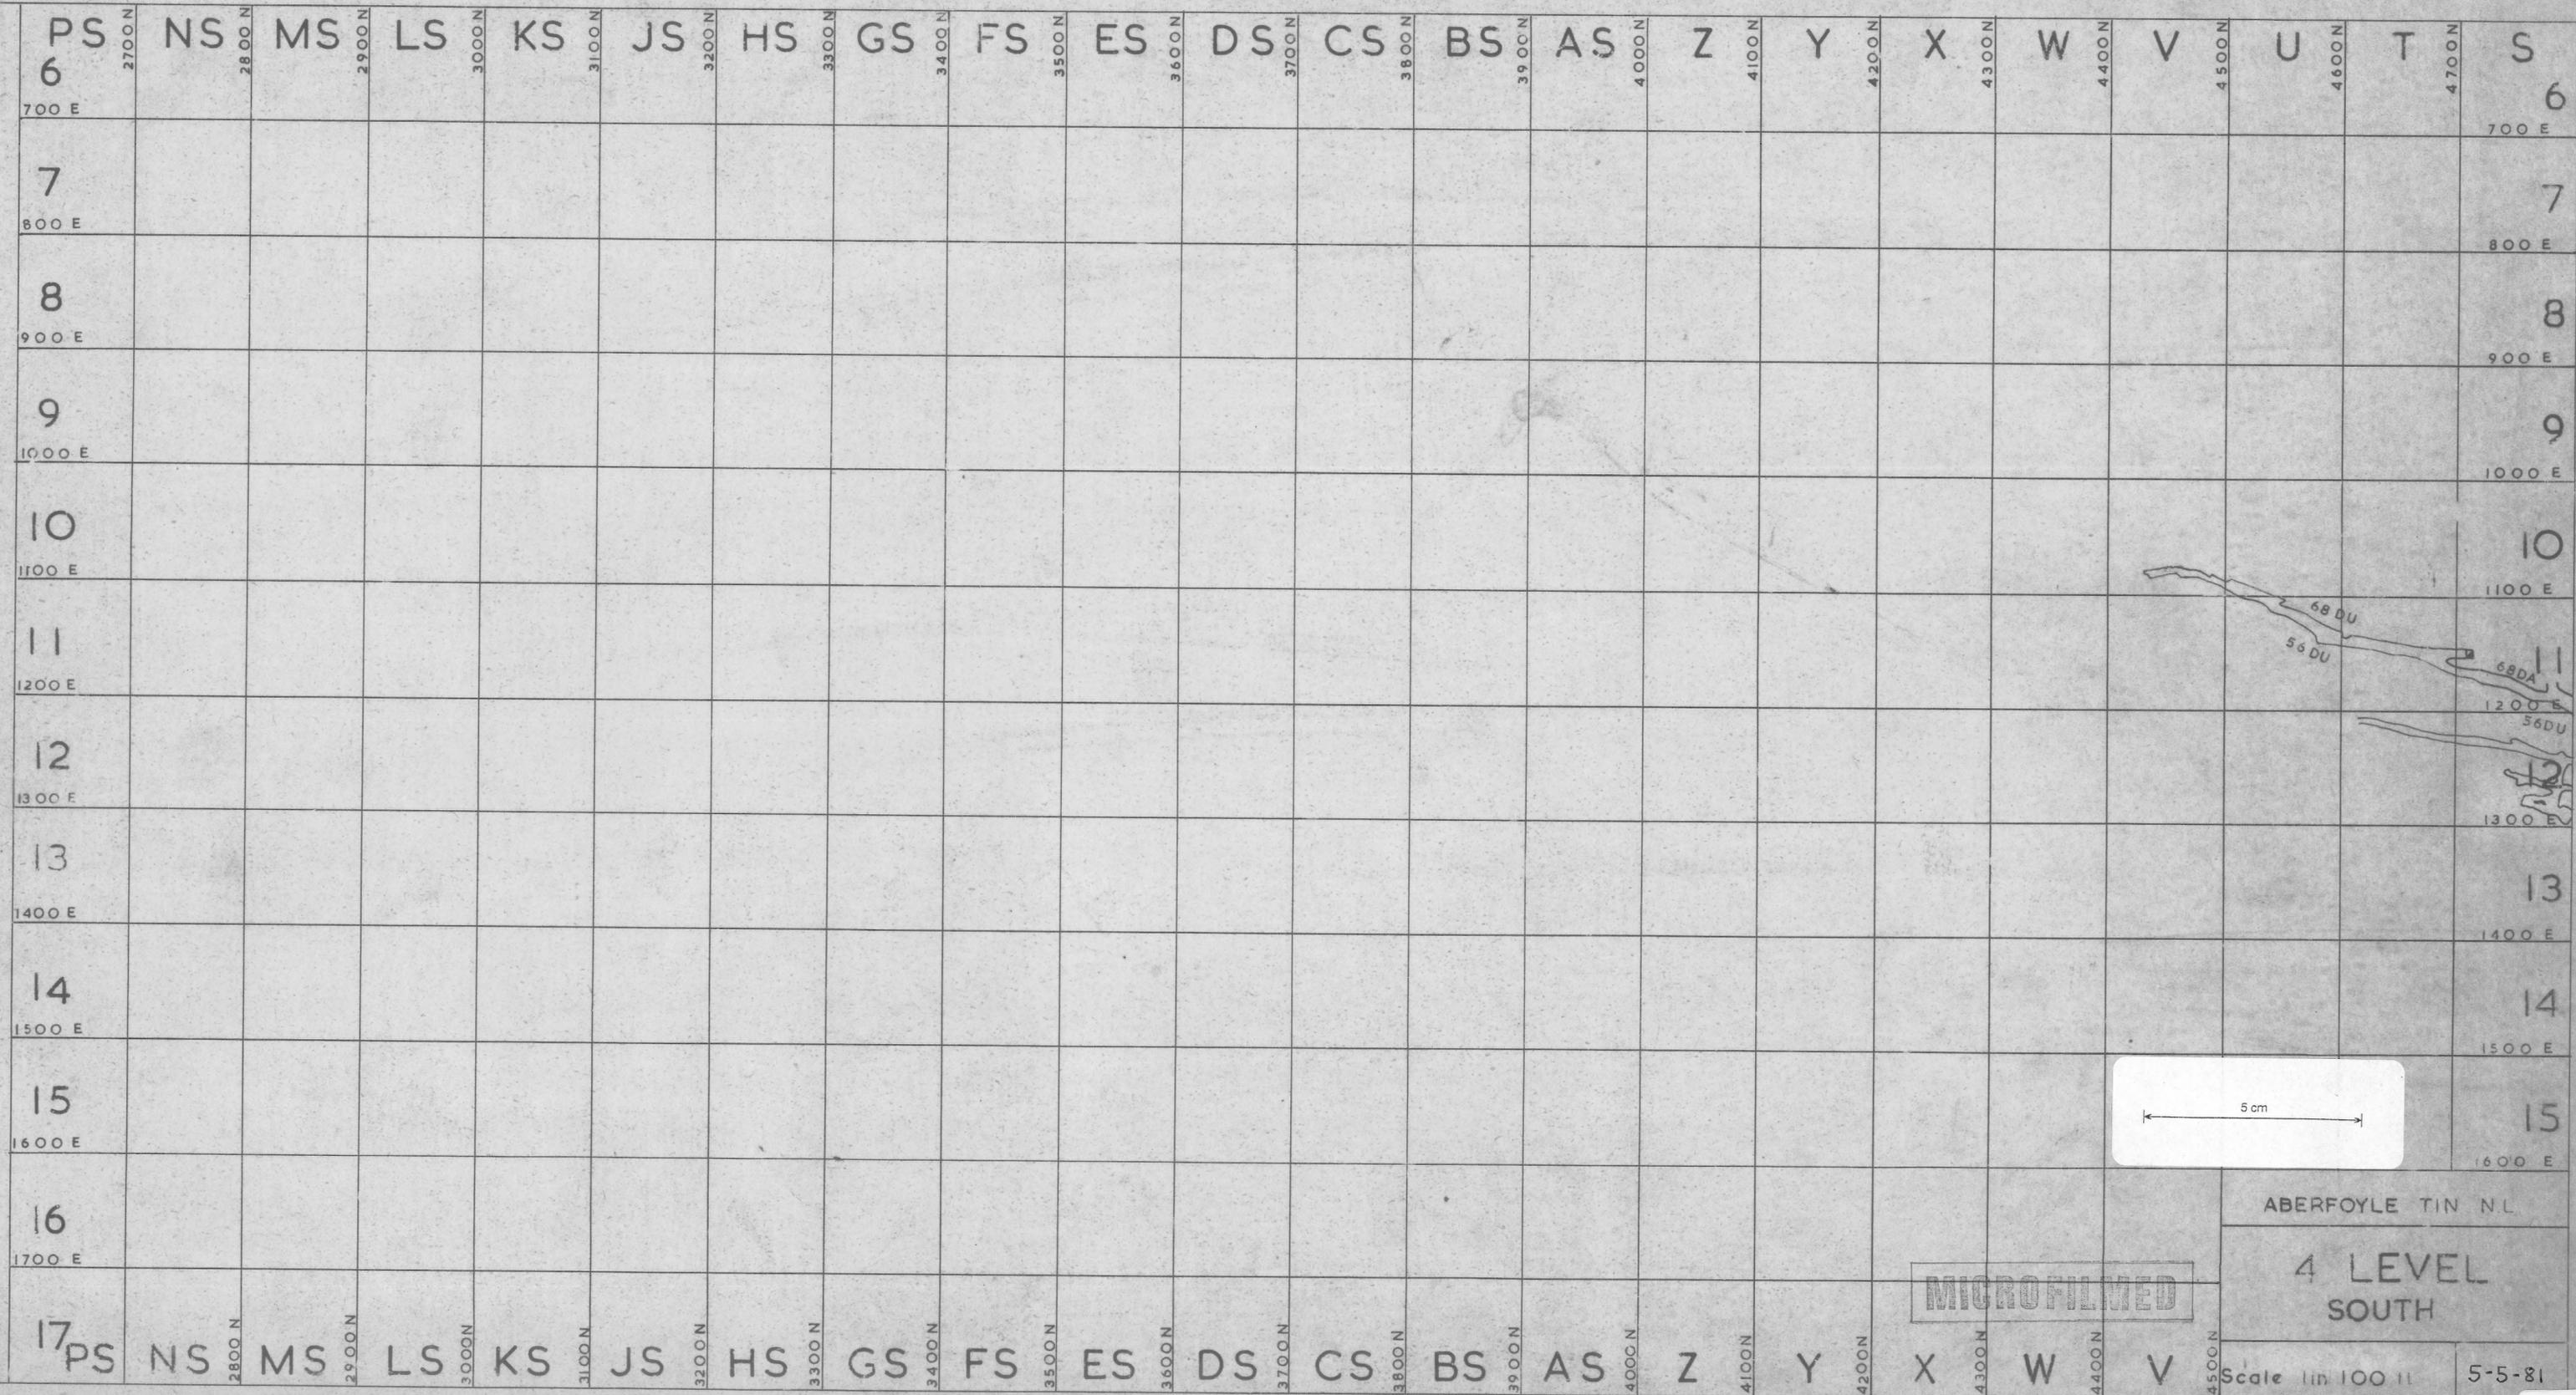

MICROFILMED

ABERFOYLE TIN N.L.
4 LEVEL
SOUTH

Scale 1 in 100 ft 5-5-81

81024