
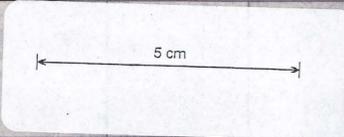


ABERF\_739

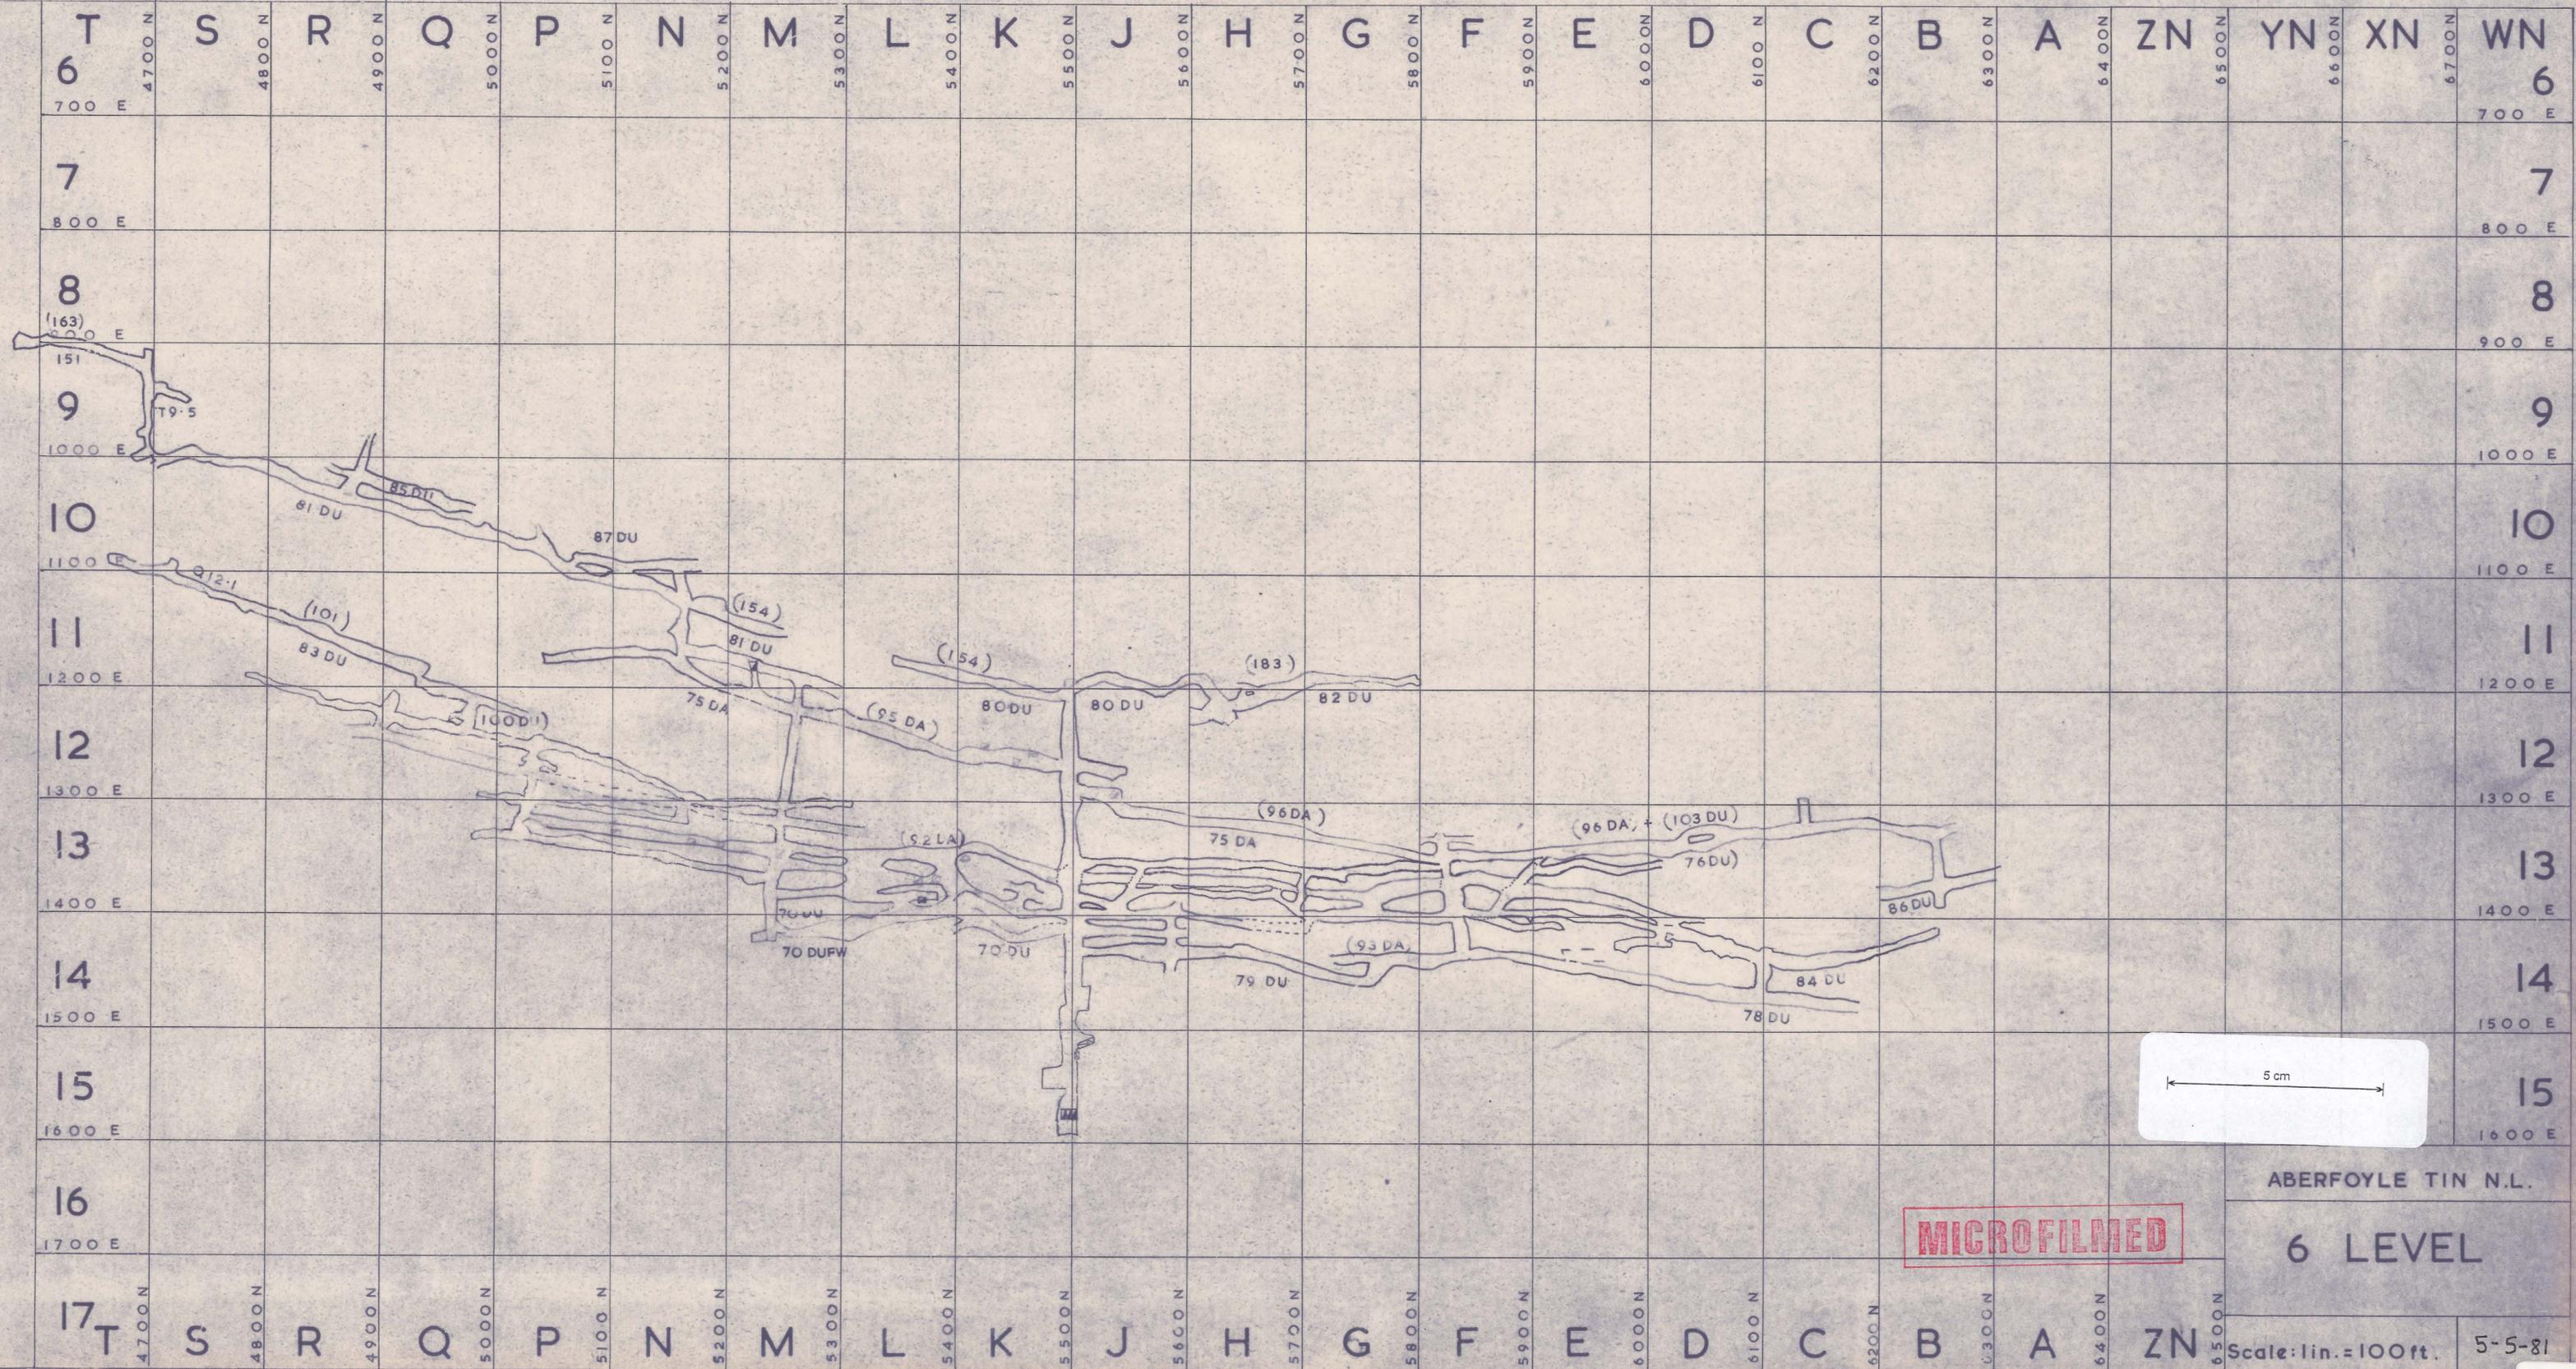

**MICROFILMED**

ABERFOYLE TIN N.L.

6 LEVEL

Scale: 1 in. = 100 ft.

5-5-81

81026