
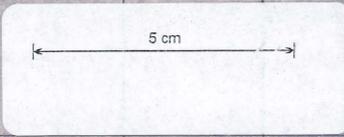


ABERF\_741

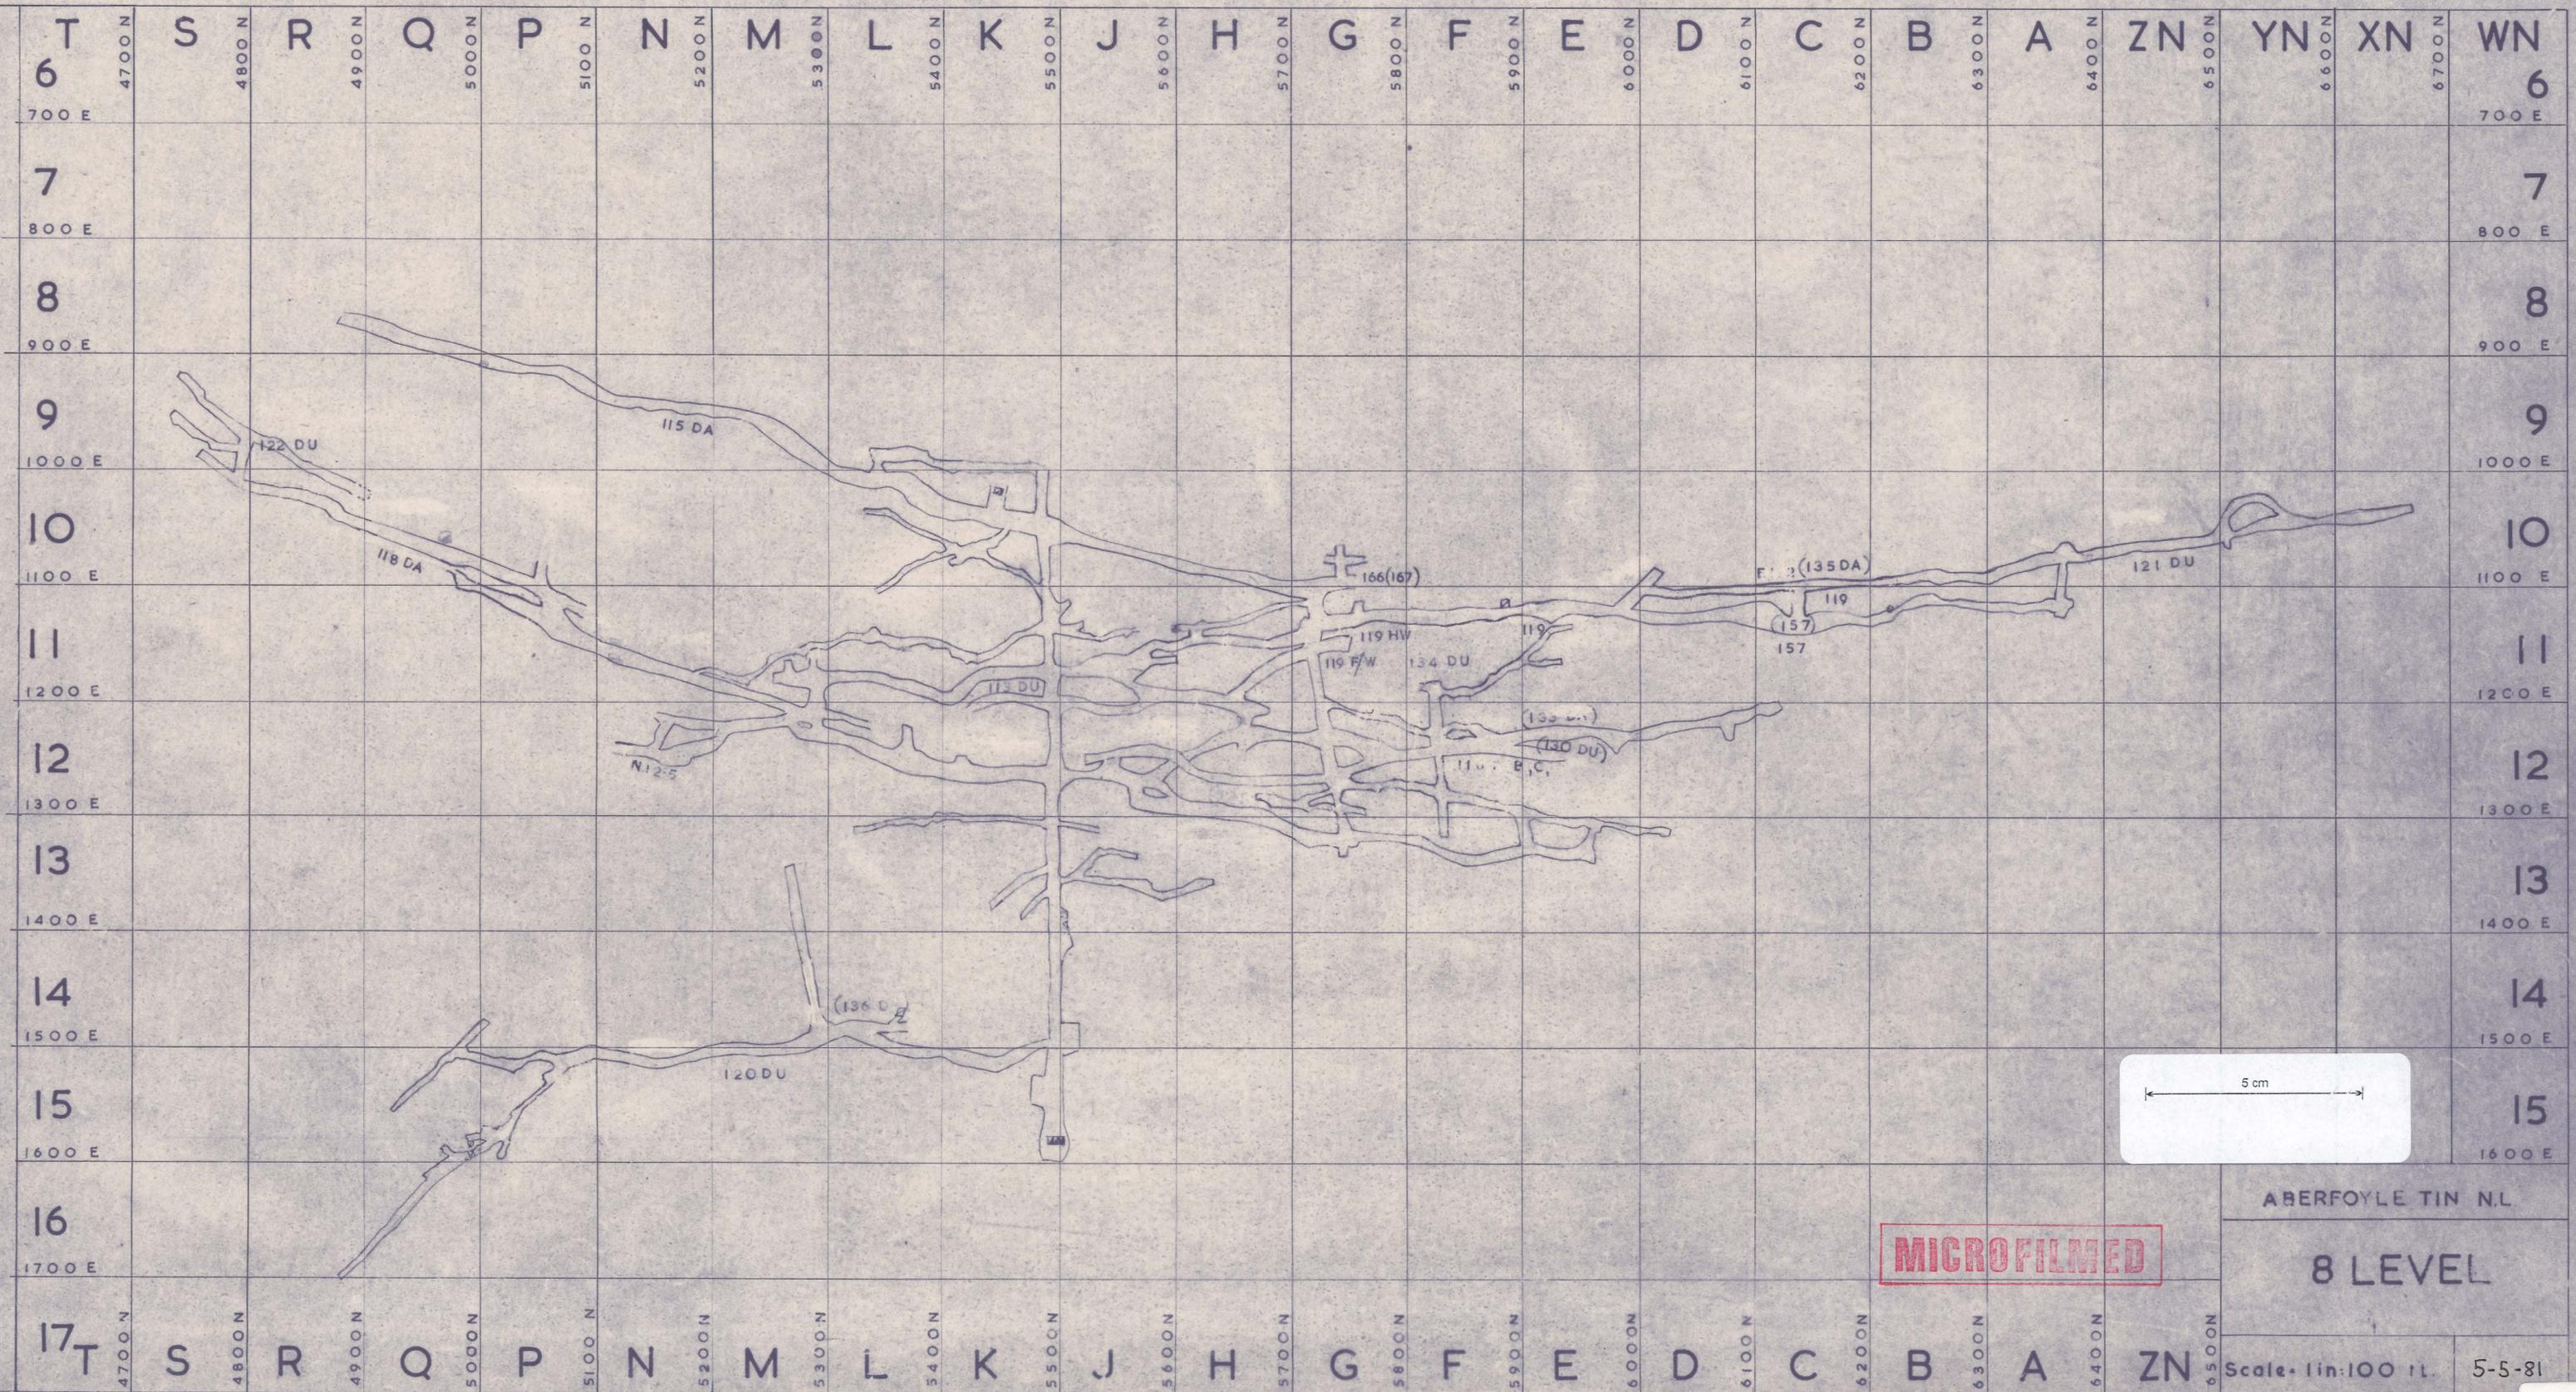

**MICROFILMED**

ABERFOYLE TIN N.L.

8 LEVEL

Scale 1 in: 100 ft.

5-5-81

81028