
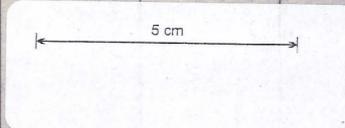


ABERF_742

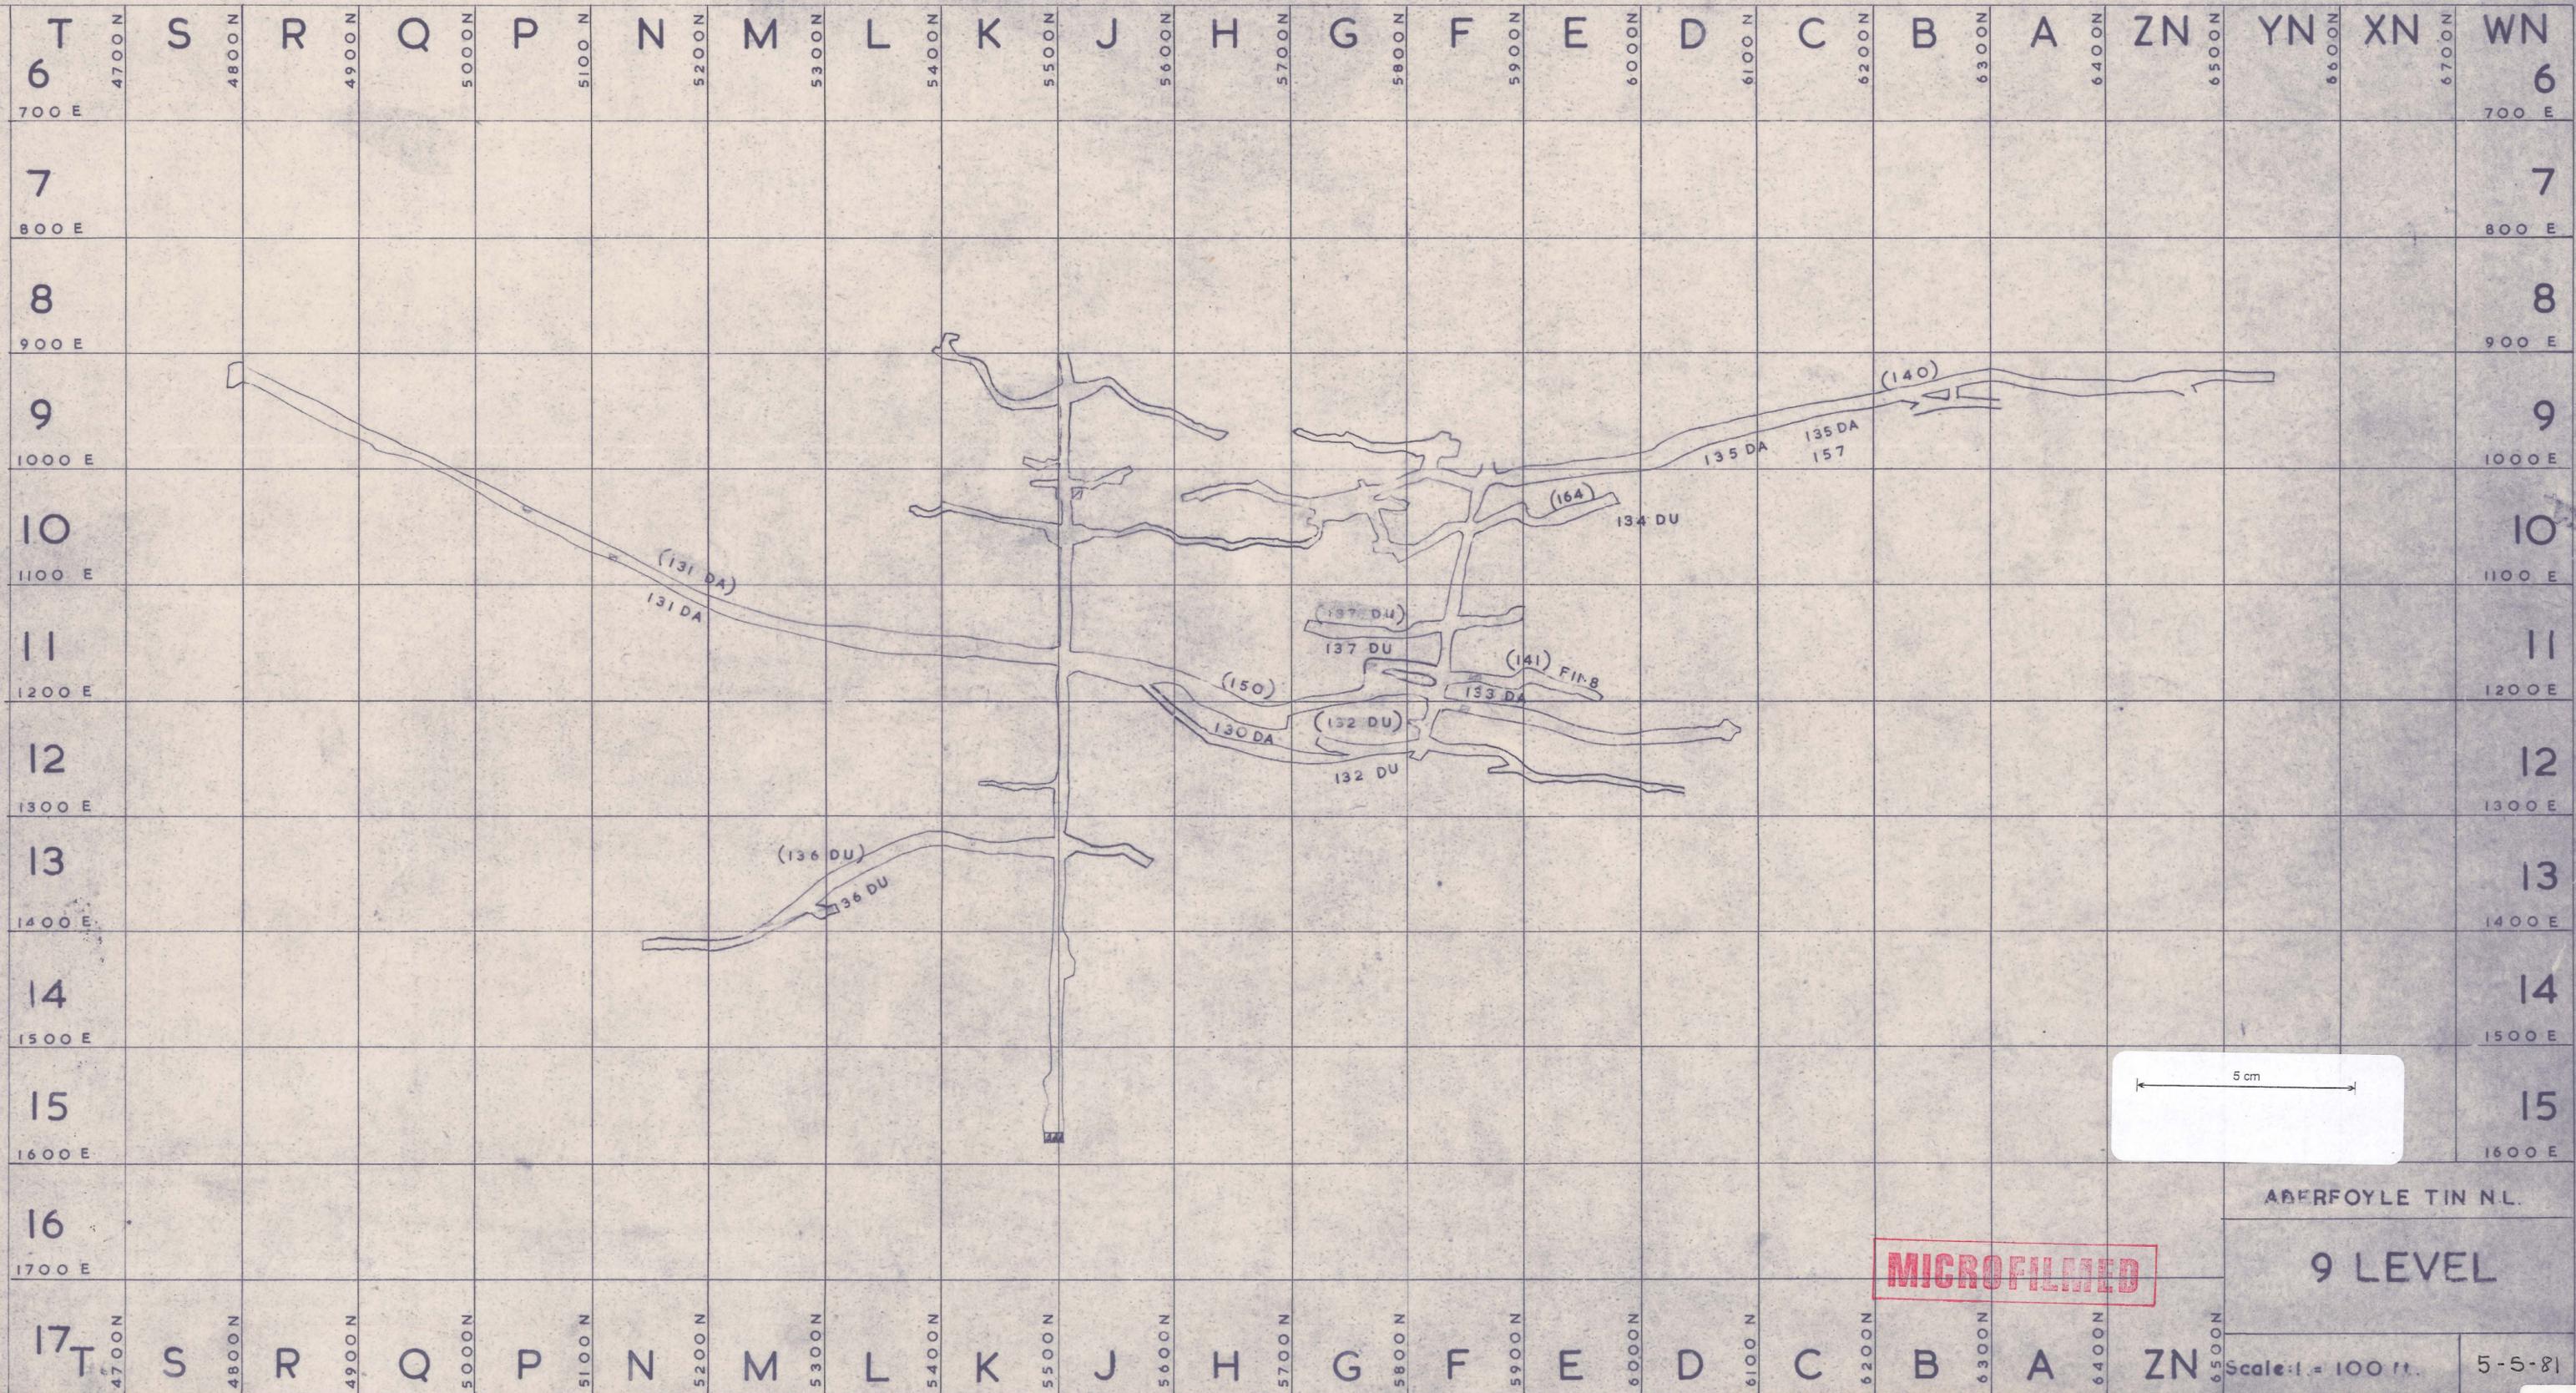

MICROFILMED

ABERFOYLE TIN N.L.

9 LEVEL

Scale: 1 = 100 ft.

5-5-81

81029