


ABERF_743

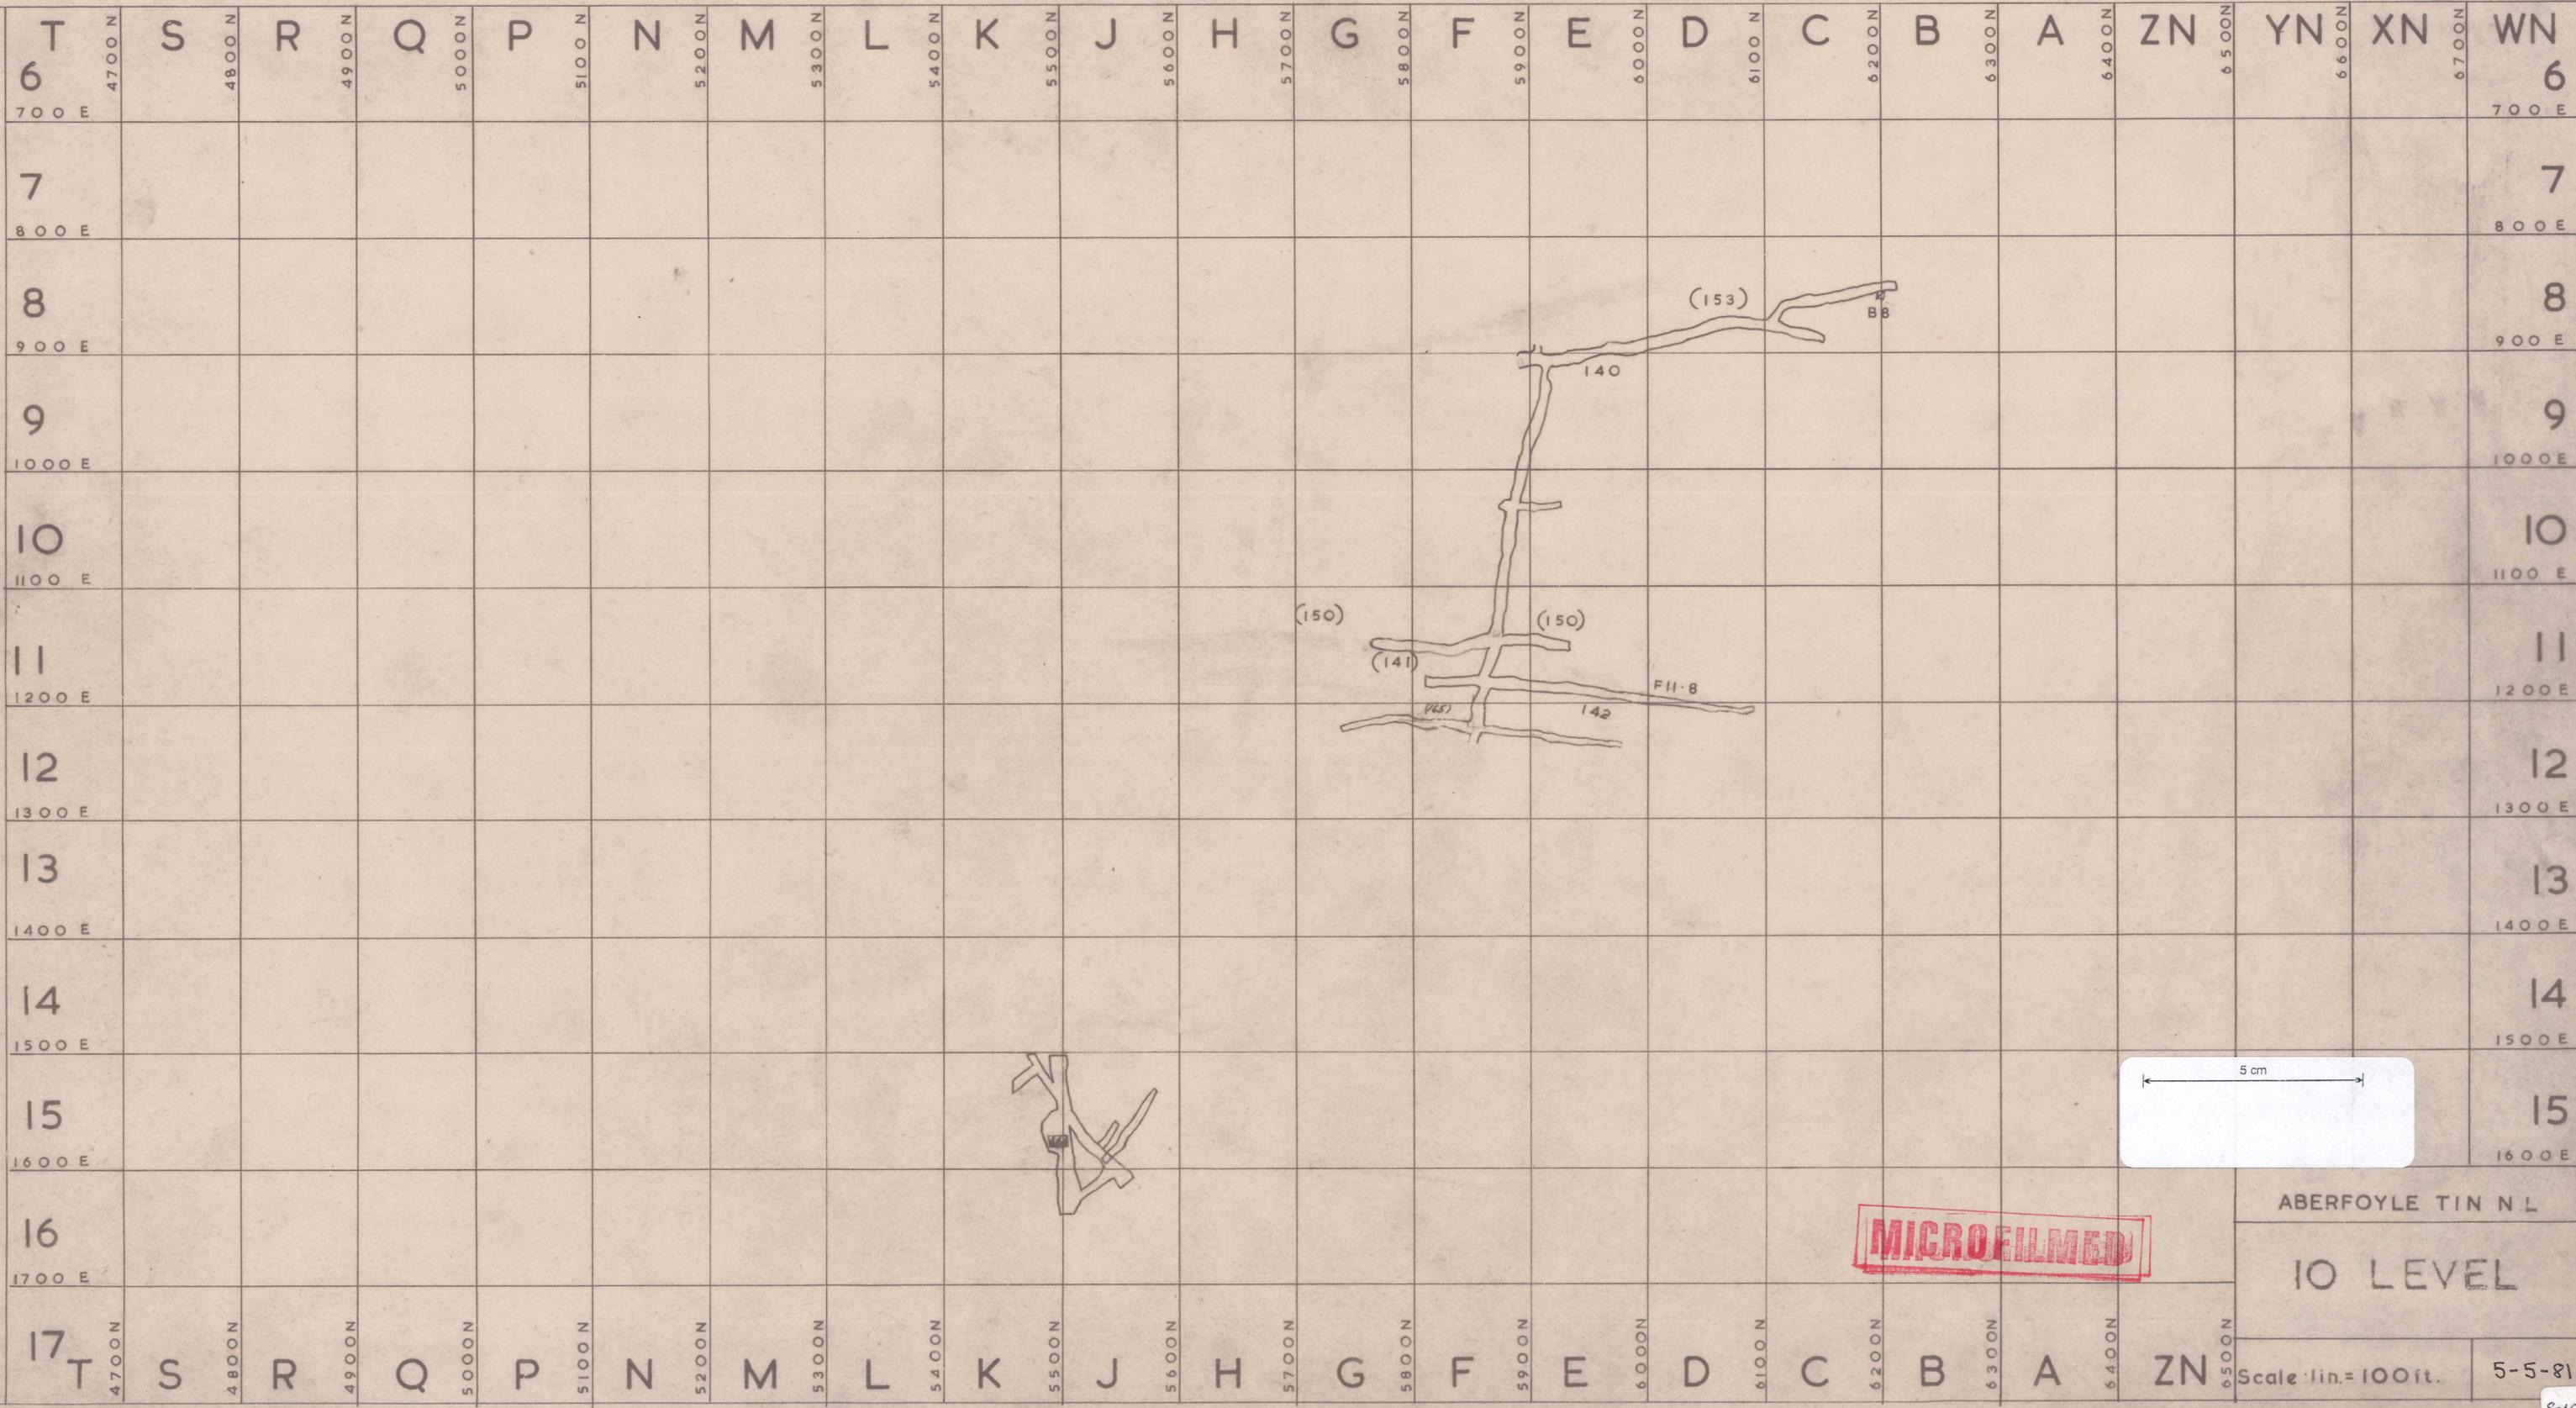

ABERFOYLE TIN N.L.

10 LEVEL

Scale 1 in. = 100 ft.

5-5-81

81030