


ABERF_746

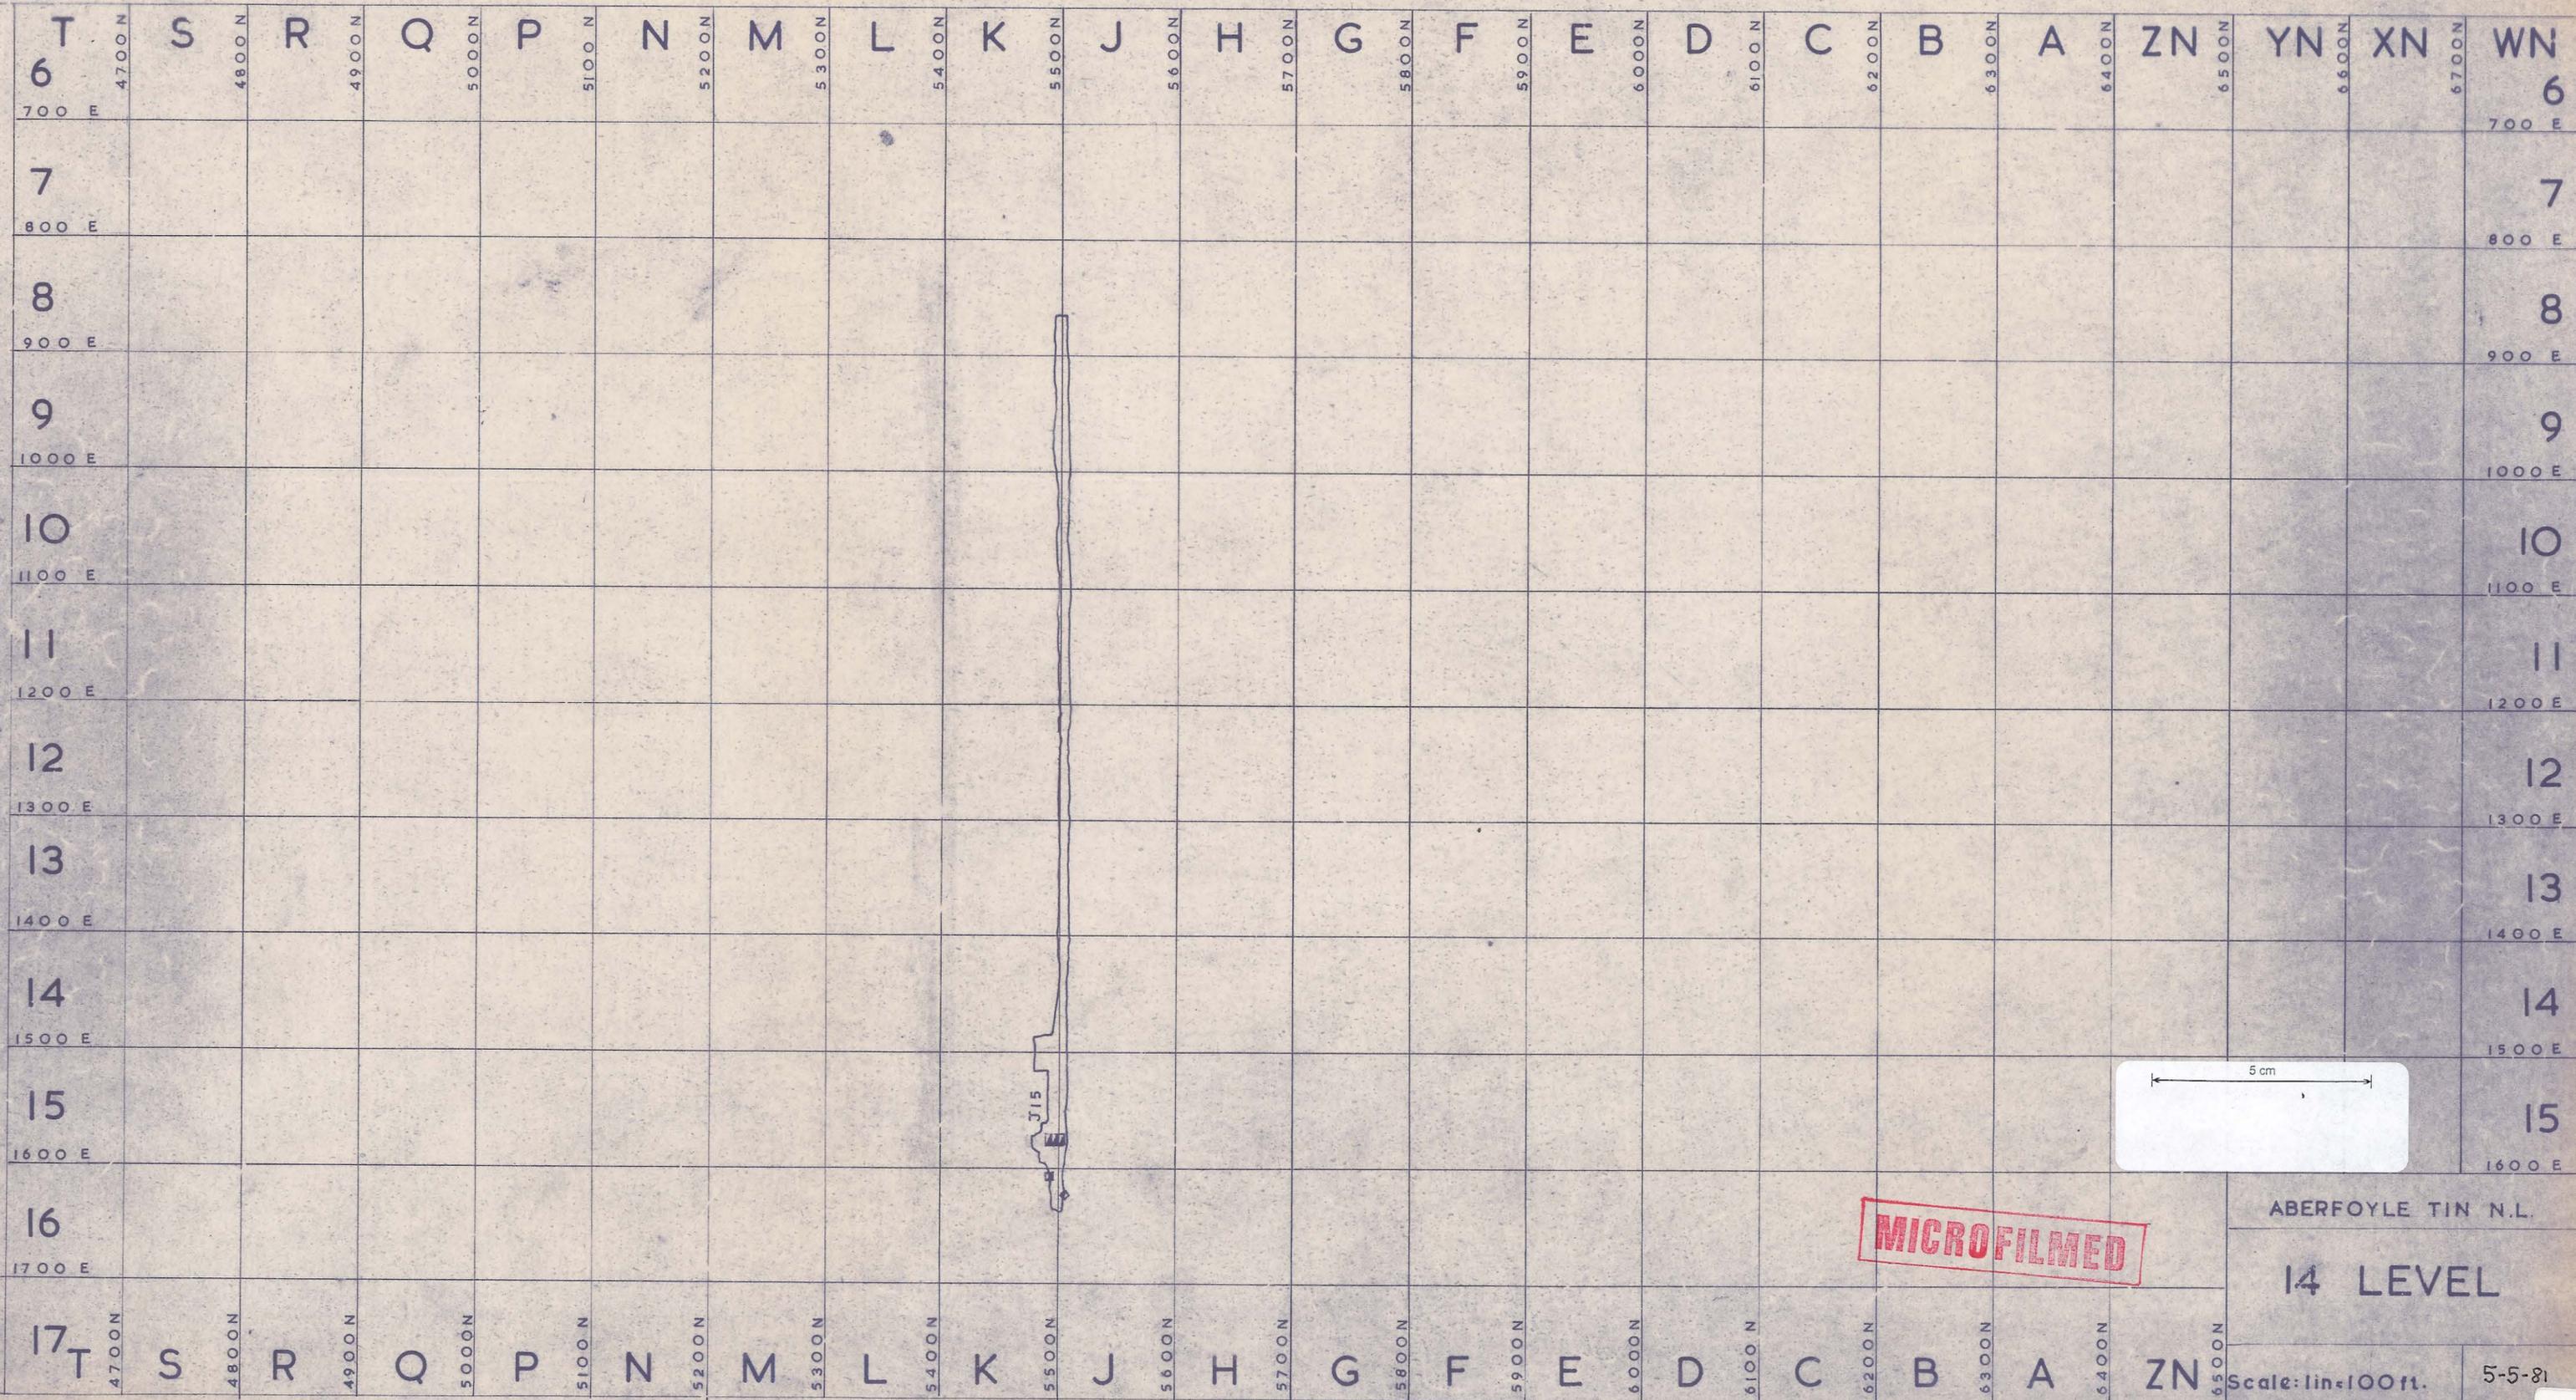

MICROFILMED

ABERFOYLE TIN N.L.

14 LEVEL

Scale: 1in=100ft.

5-5-81

81033