


ABERF_747

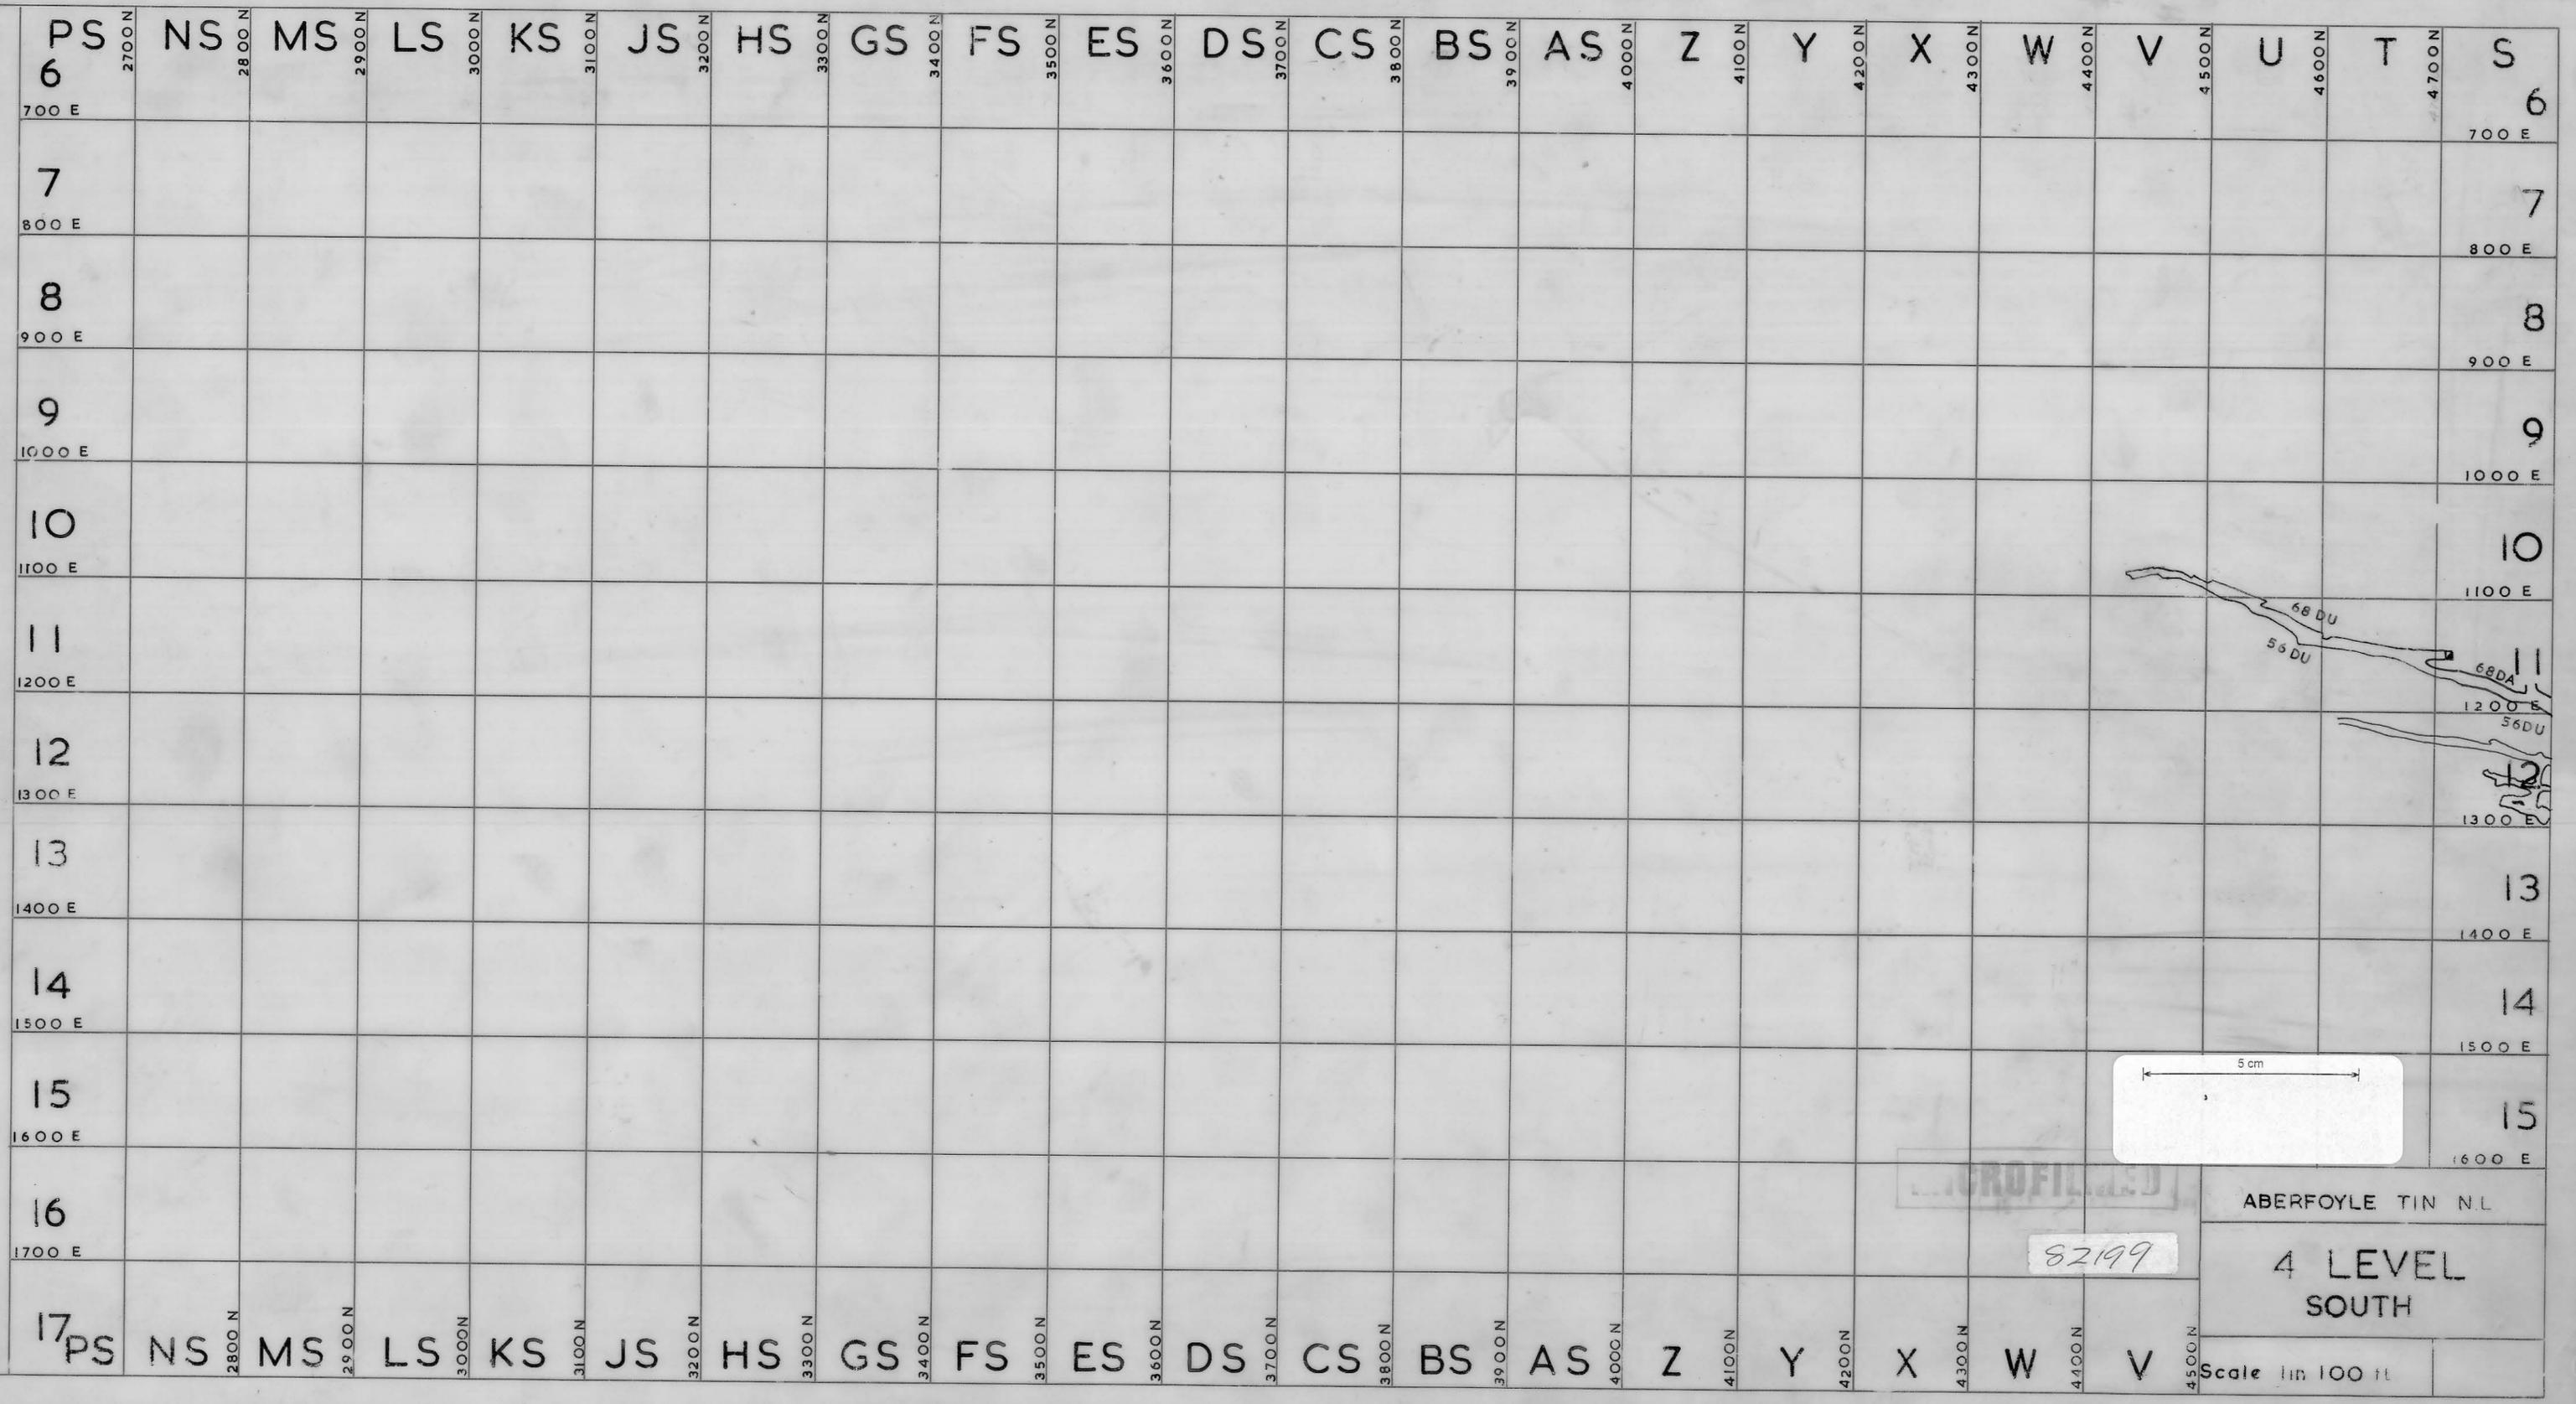

PS 2700 N NS 2800 N MS 2900 N LS 3000 N KS 3100 N JS 3200 N HS 3300 N GS 3400 N FS 3500 N ES 3600 N DS 3700 N CS 3800 N BS 3900 N AS 4000 N Z 4100 N Y 4200 N X 4300 N W 4400 N V 4500 N U 4600 N T 4700 N S

6 700 E 7 800 E 8 900 E 9 1000 E 10 1100 E 11 1200 E 12 1300 E 13 1400 E 14 1500 E 15 1600 E 16 1700 E

17 PS 2800 N NS 2900 N MS 3000 N LS 3100 N KS 3200 N JS 3300 N HS 3400 N GS 3500 N FS 3600 N DS 3700 N CS 3800 N BS 3900 N AS 4000 N Z 4100 N Y 4200 N X 4300 N W 4400 N V 4500 N

82199
 ABERFOYLE TIN N.L.
 4 LEVEL SOUTH
 Scale 1 in 100 ft