


ABERF_749

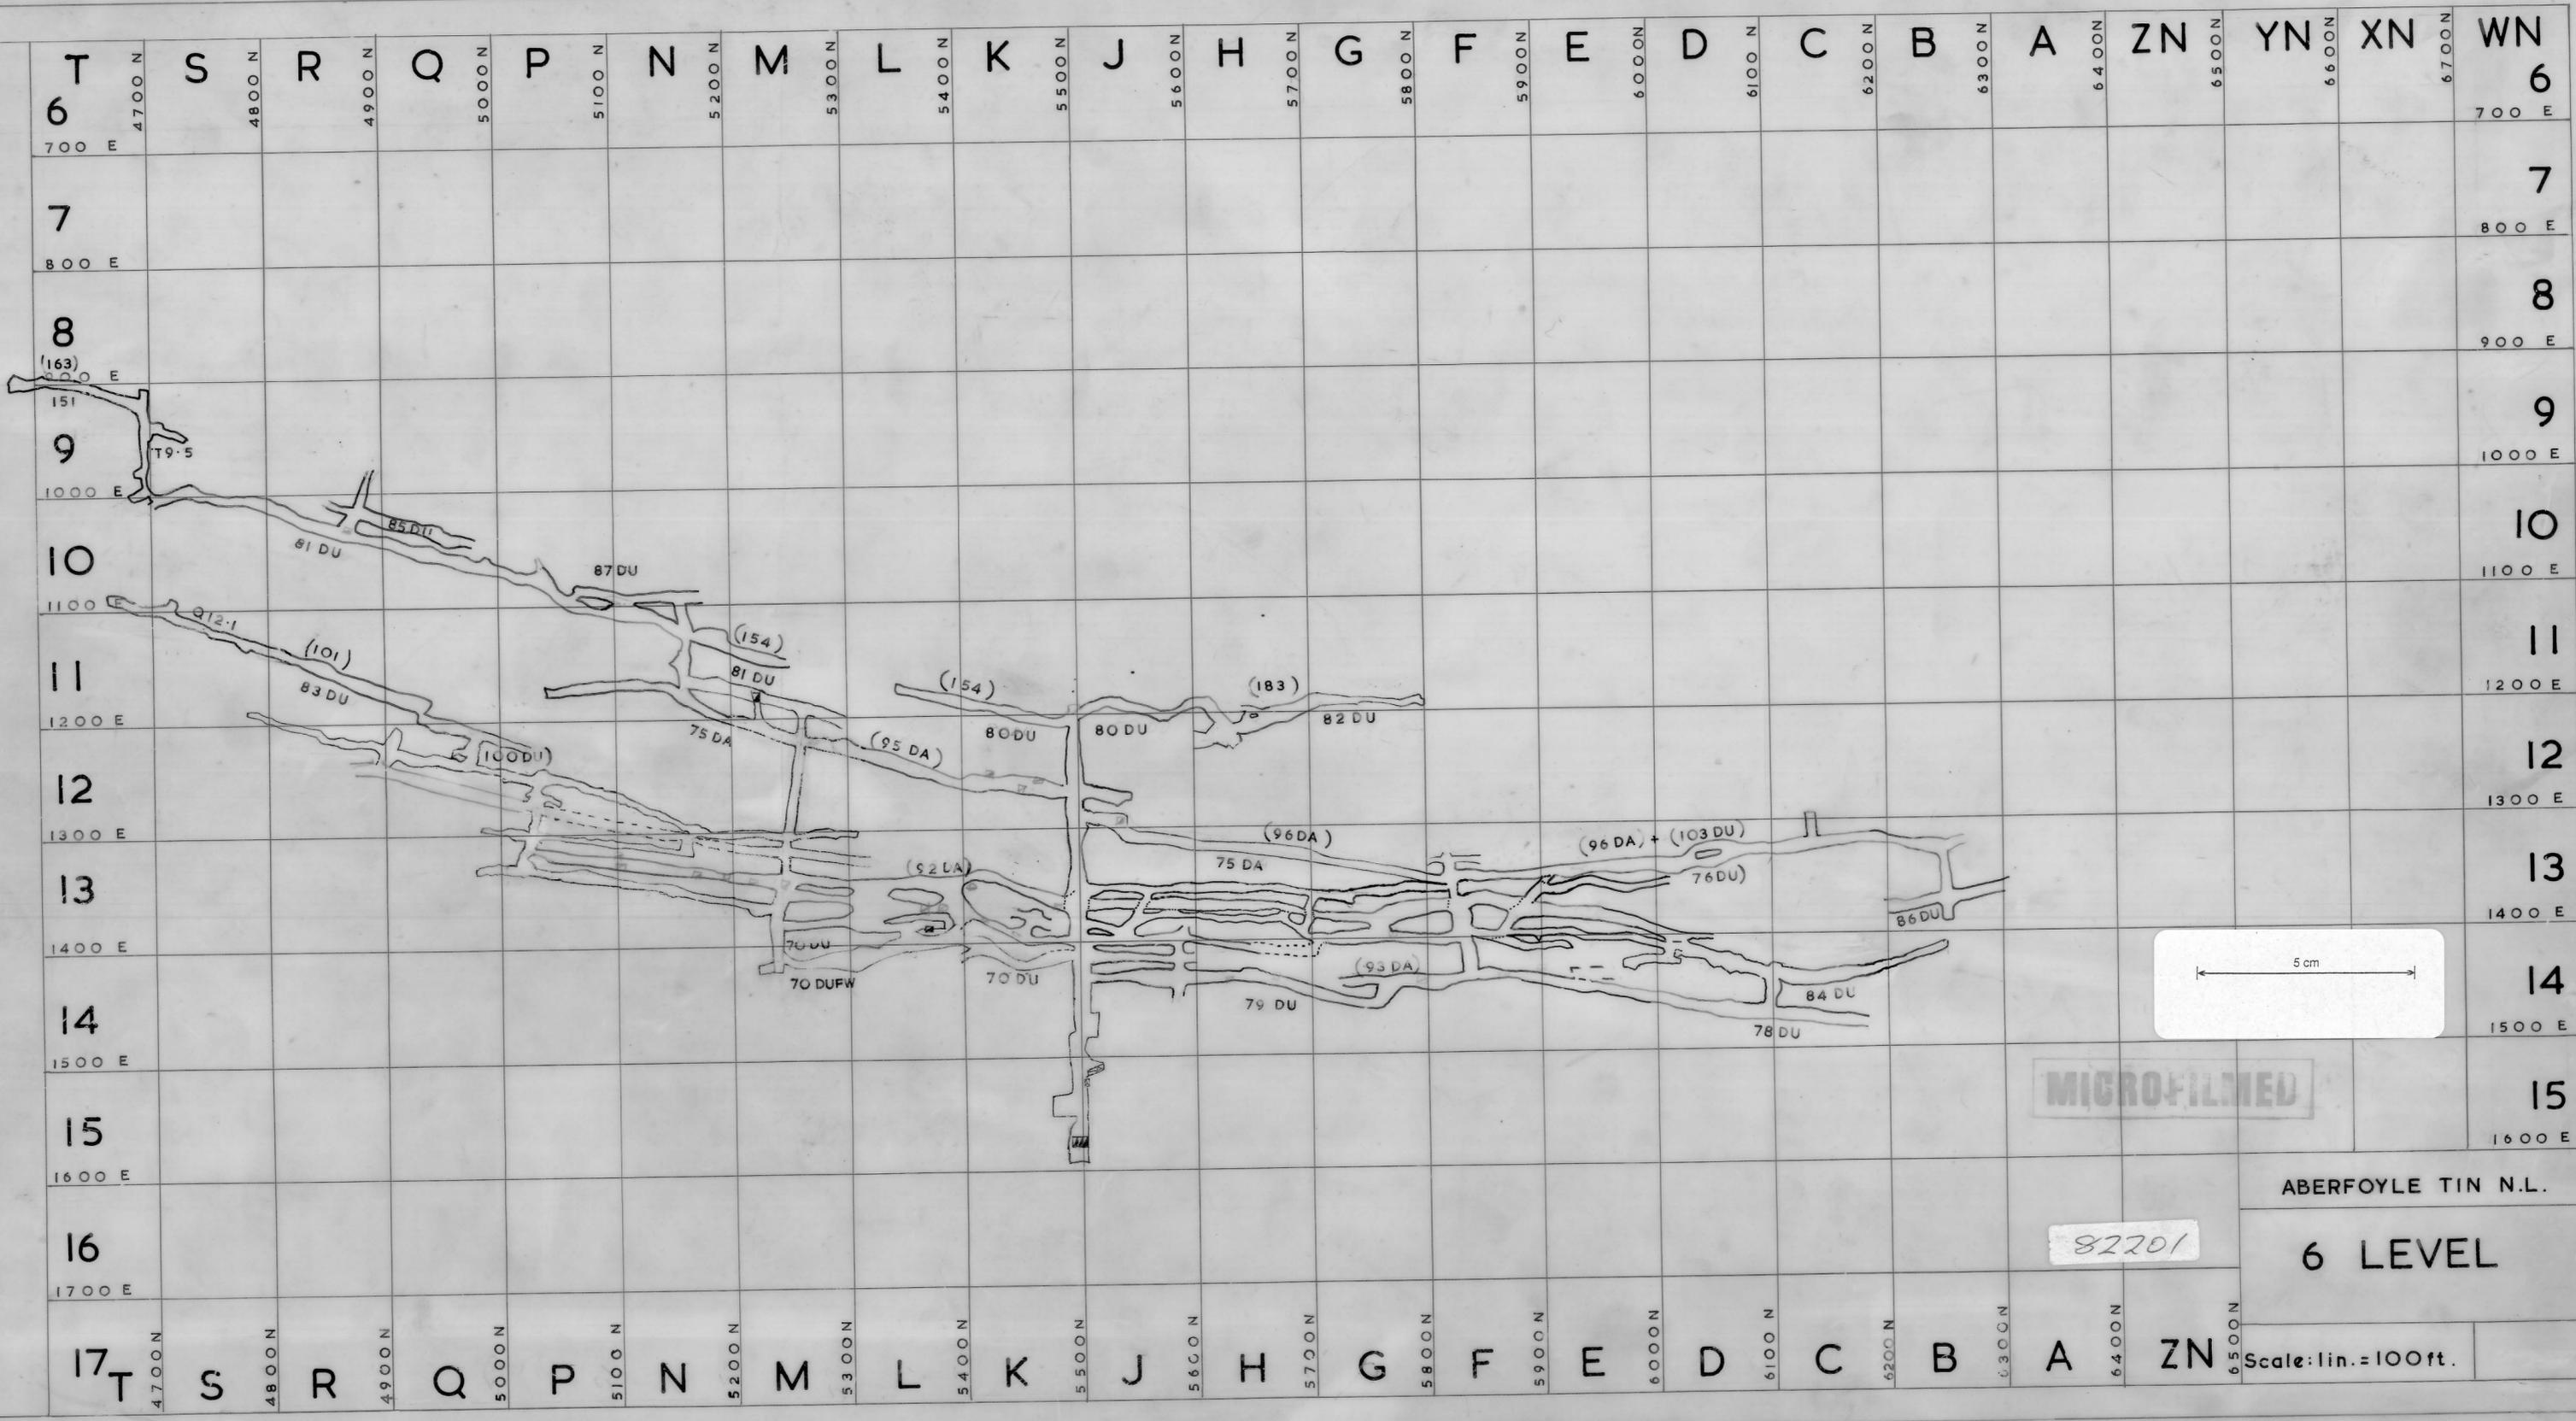

MICROFILMED

82201

ABERFOYLE TIN N.L.

6 LEVEL

Scale: lin. = 100ft.