
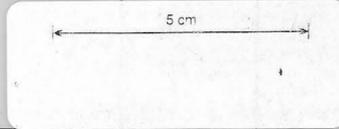


ABERF_752

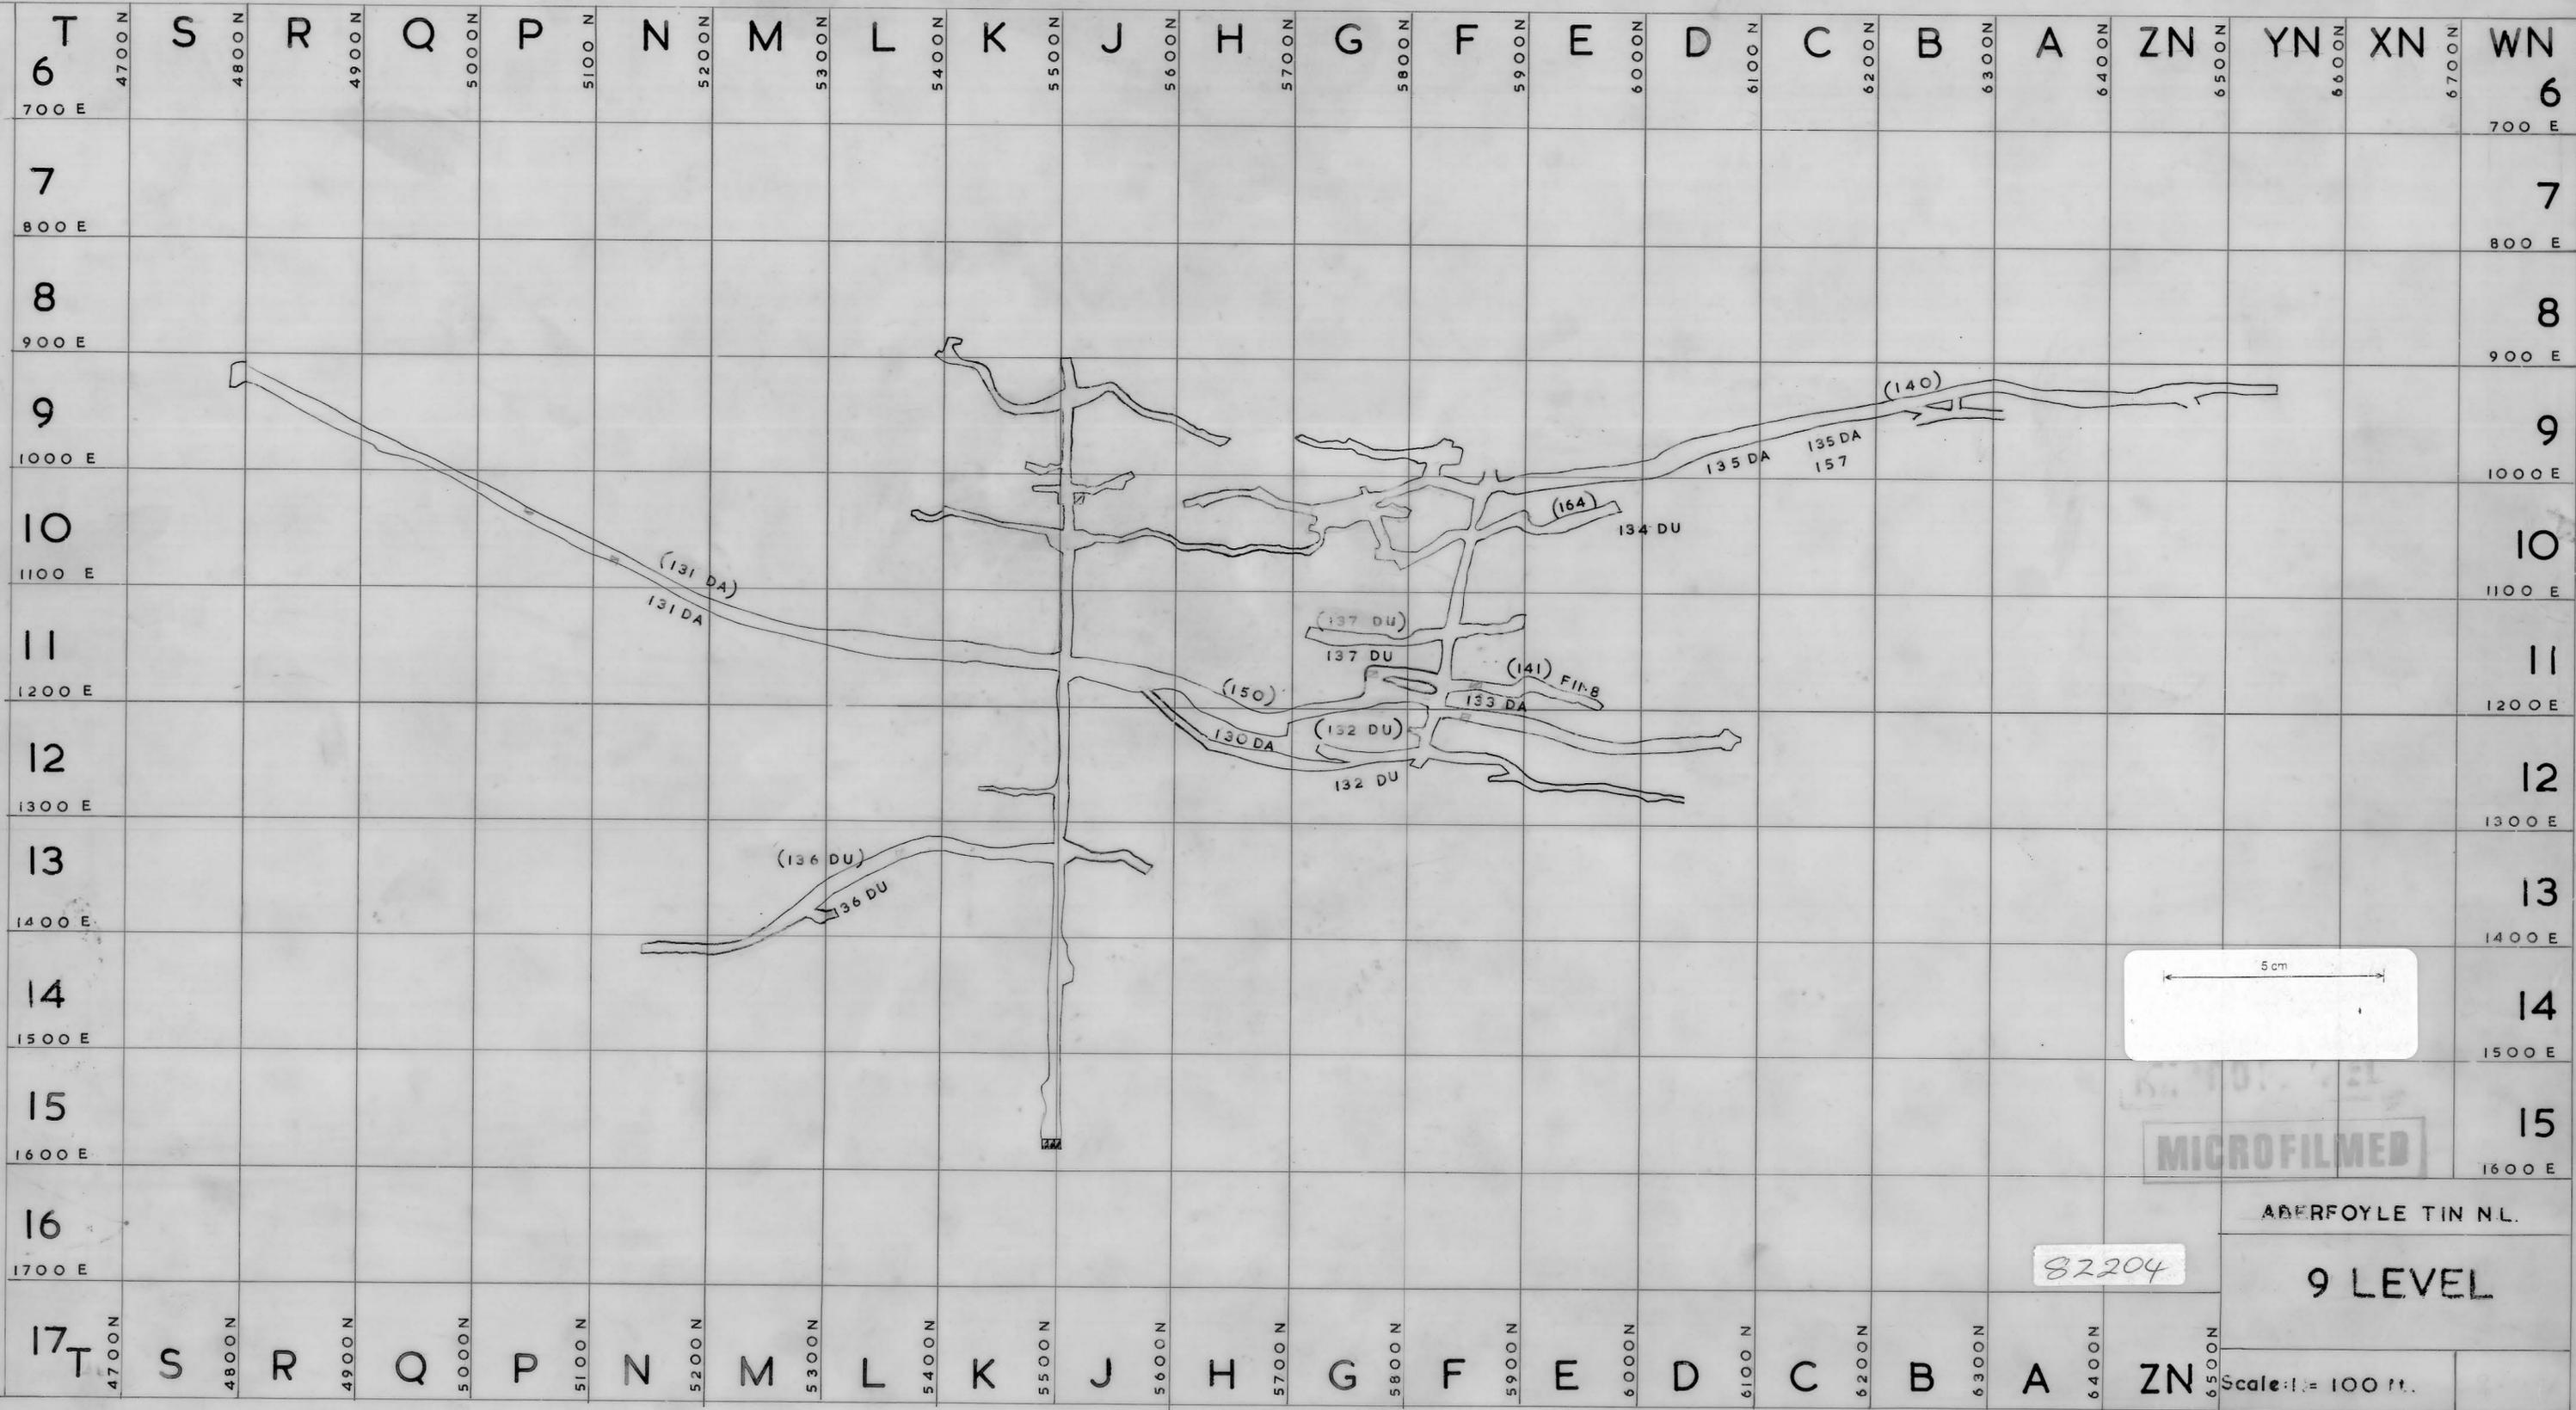

MICROFILMED

ABERFOYLE TIN N.L.

82204

9 LEVEL

Scale: 1" = 100 ft.