
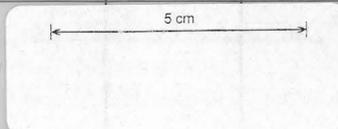


ABERF_753

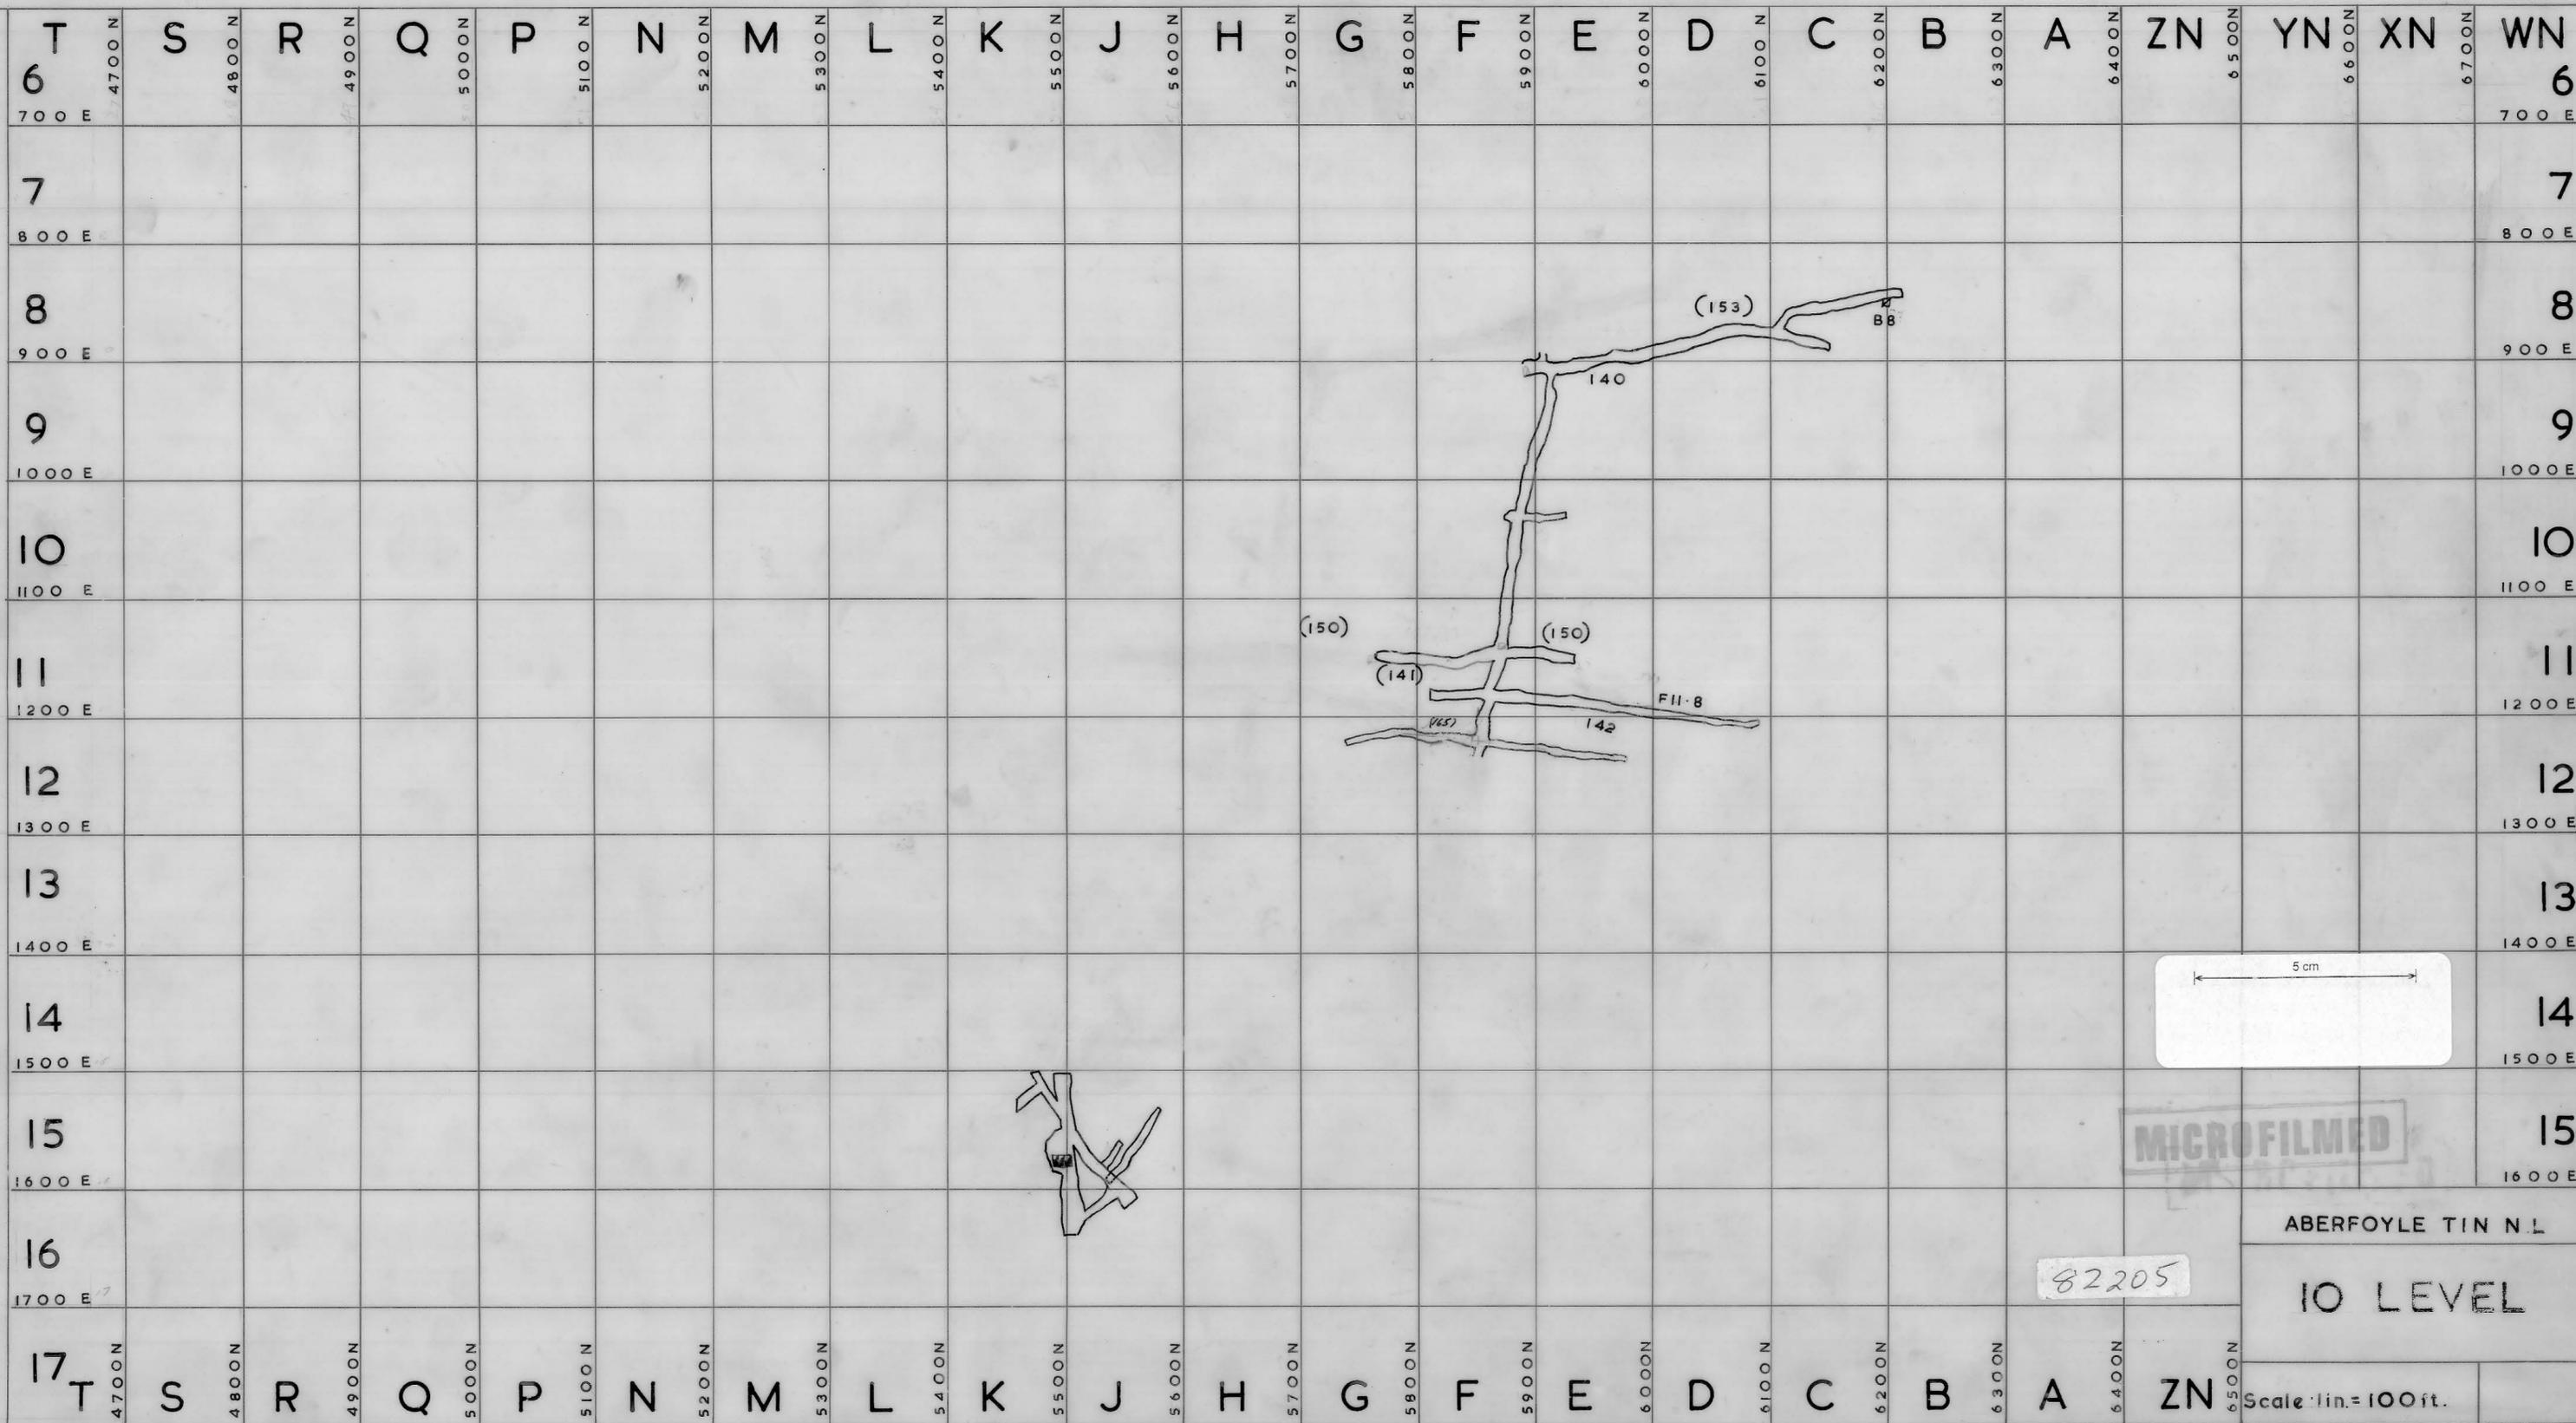

MICROFILMED

82205

ABERFOYLE TIN N.L.

10 LEVEL

Scale 1 in. = 100 ft.