
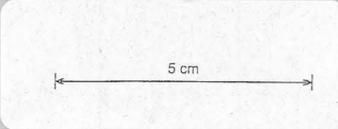


ABERF_754

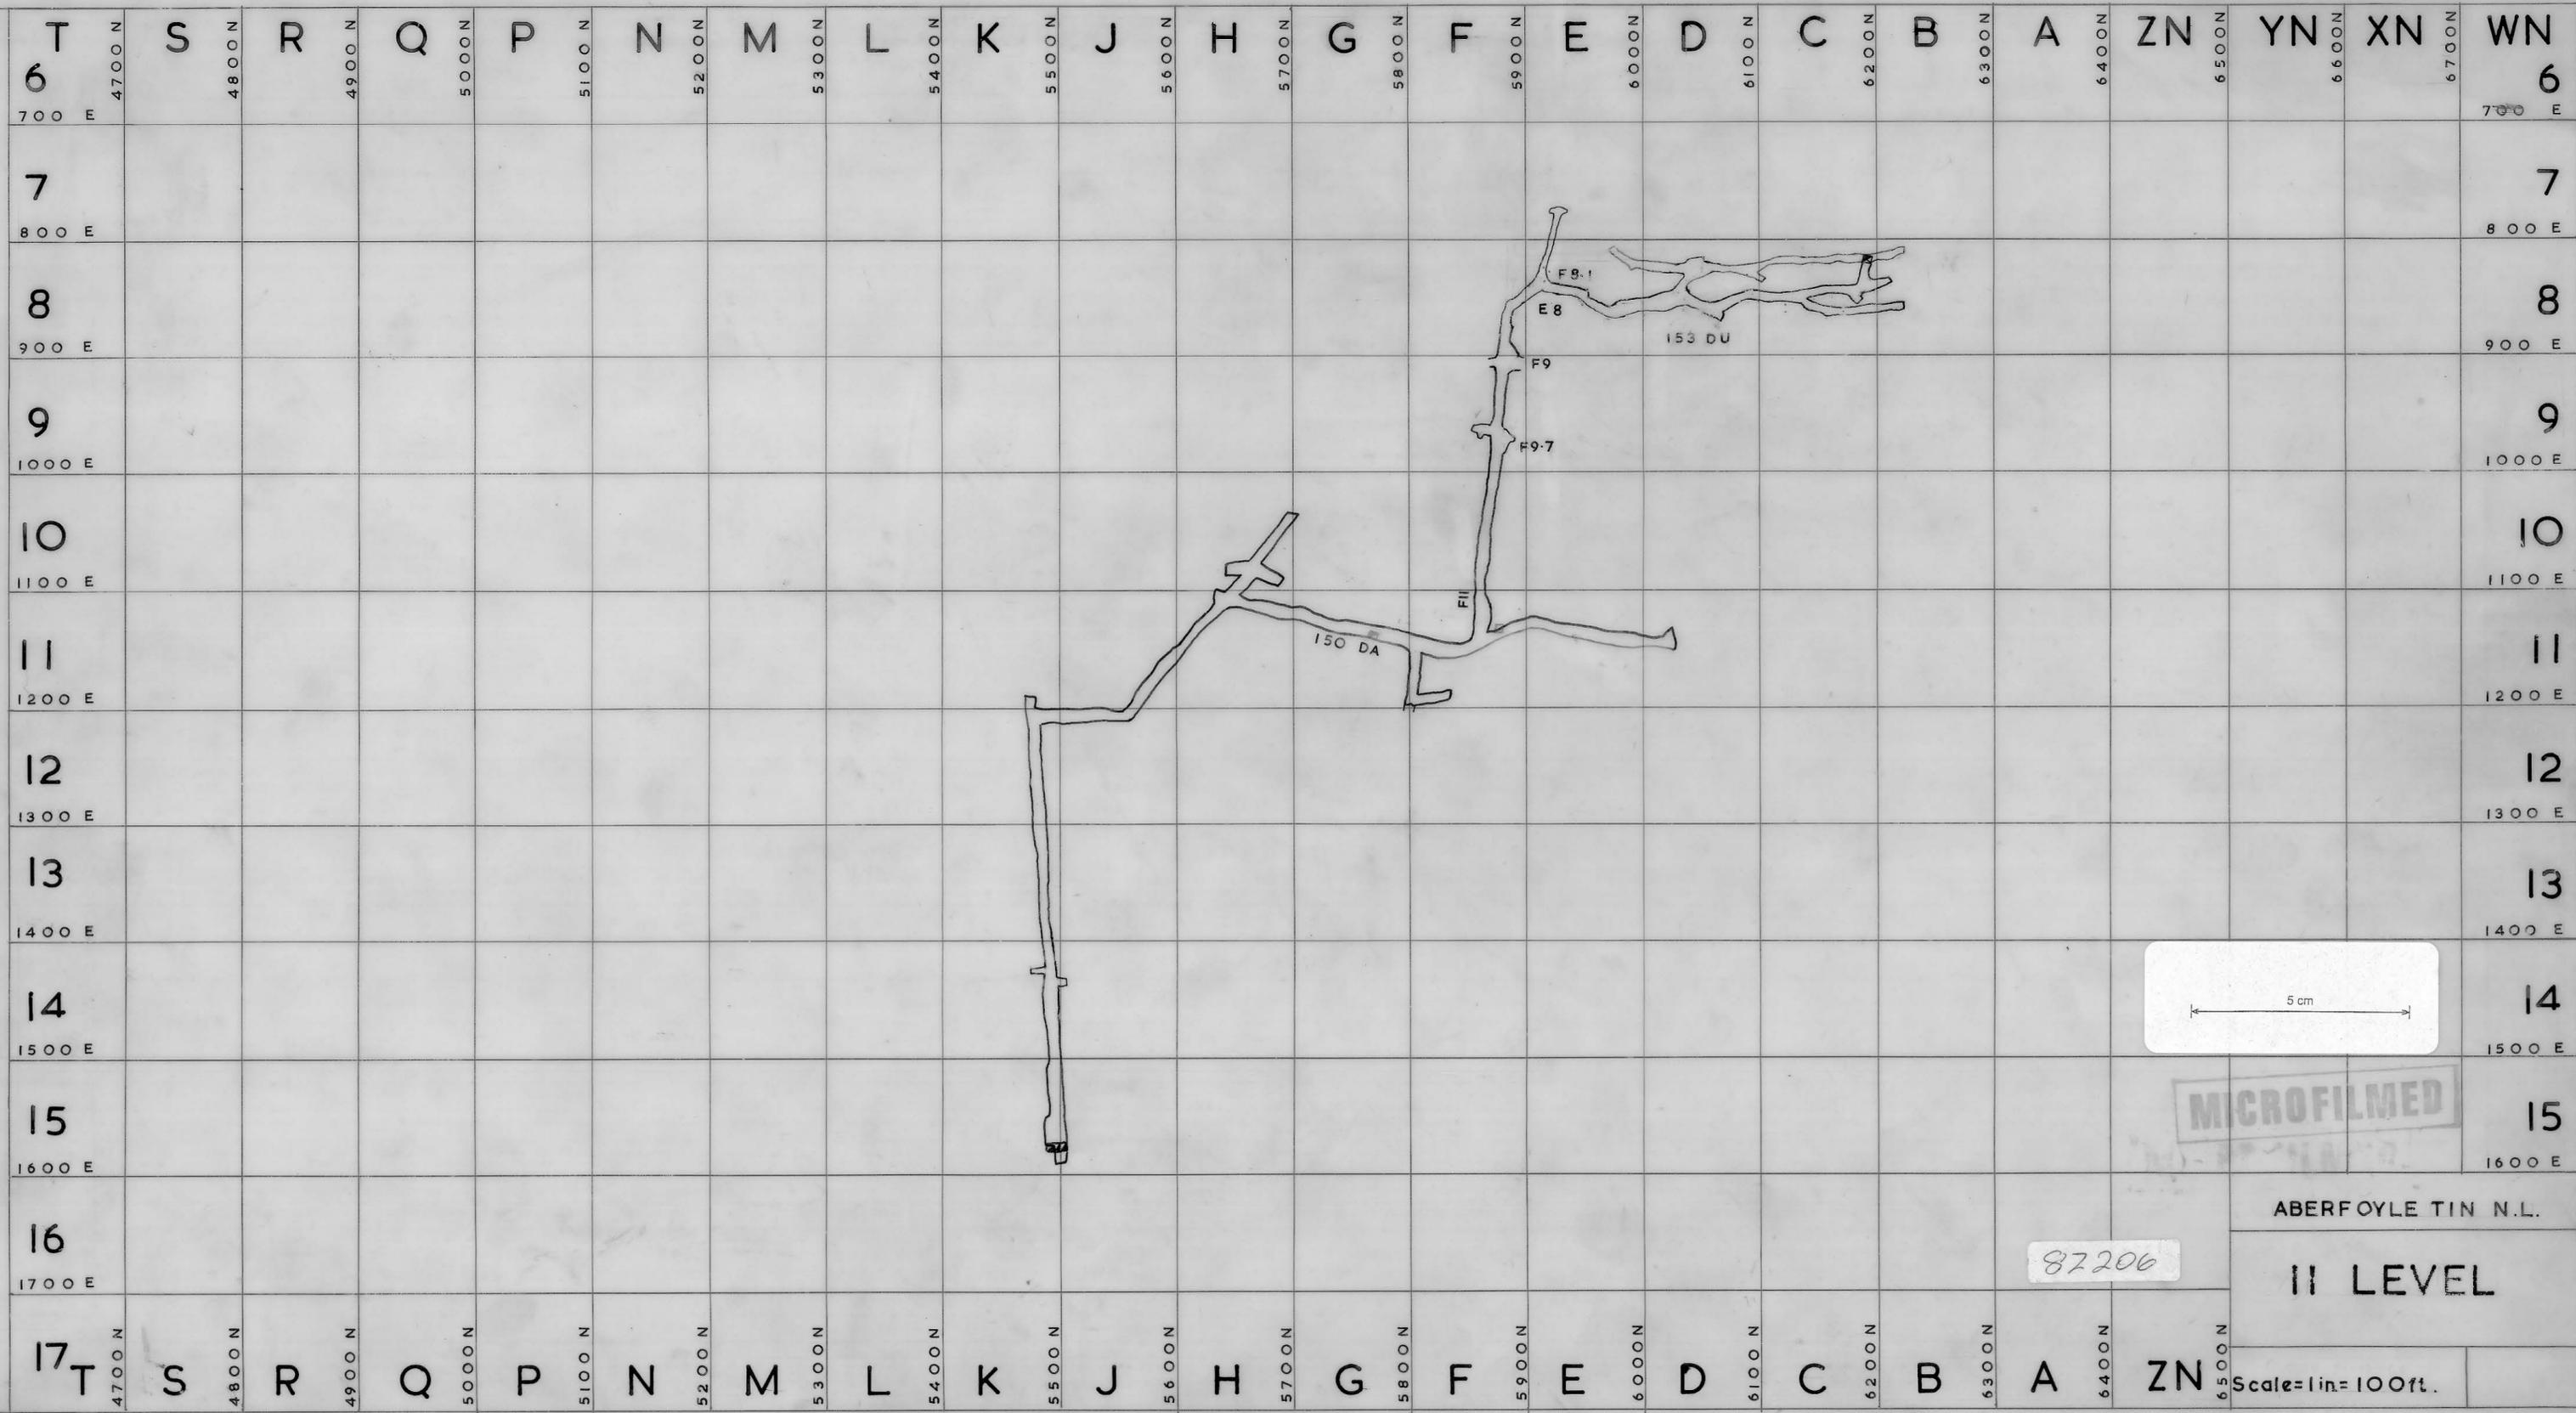

MICROFILMED

87206

ABERFOYLE TIN N.L.

II LEVEL

Scale = 1 in = 100 ft.