
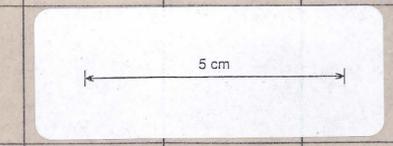


ABERF_756

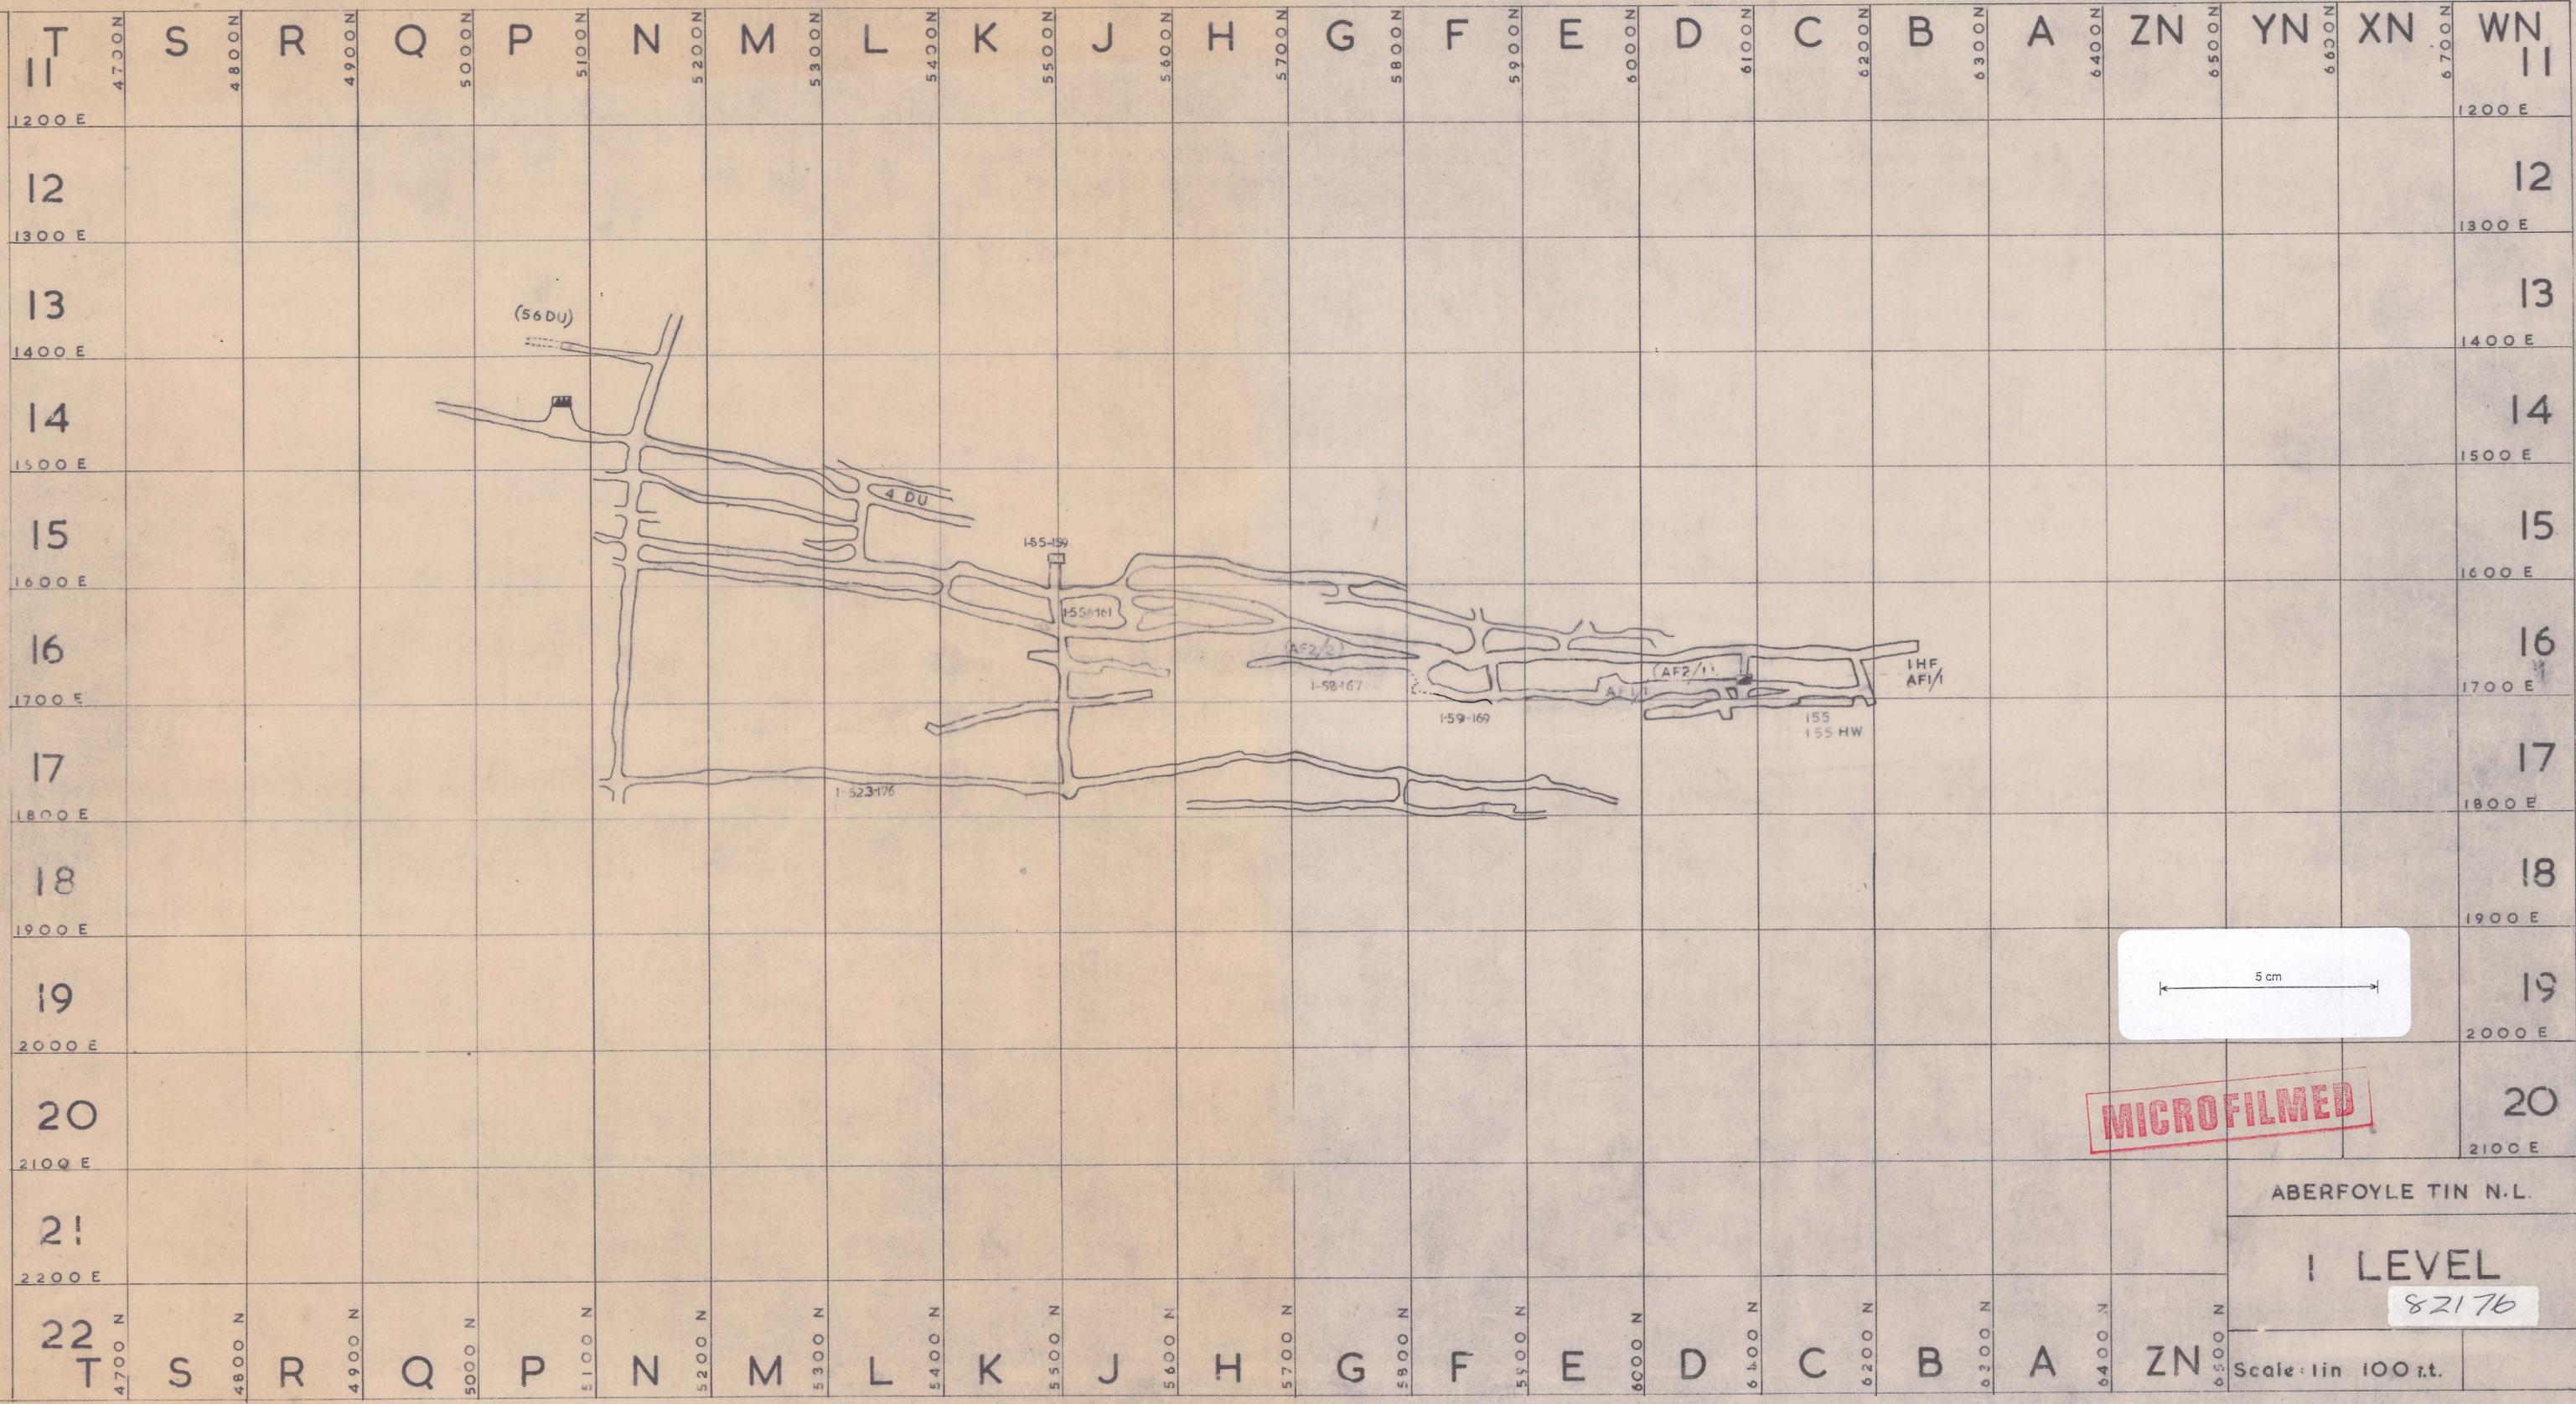

MICROFILMED

ABERFOYLE TIN N.L.

I LEVEL

82176

Scale: 1 in 100 ft.