


ABERF_762

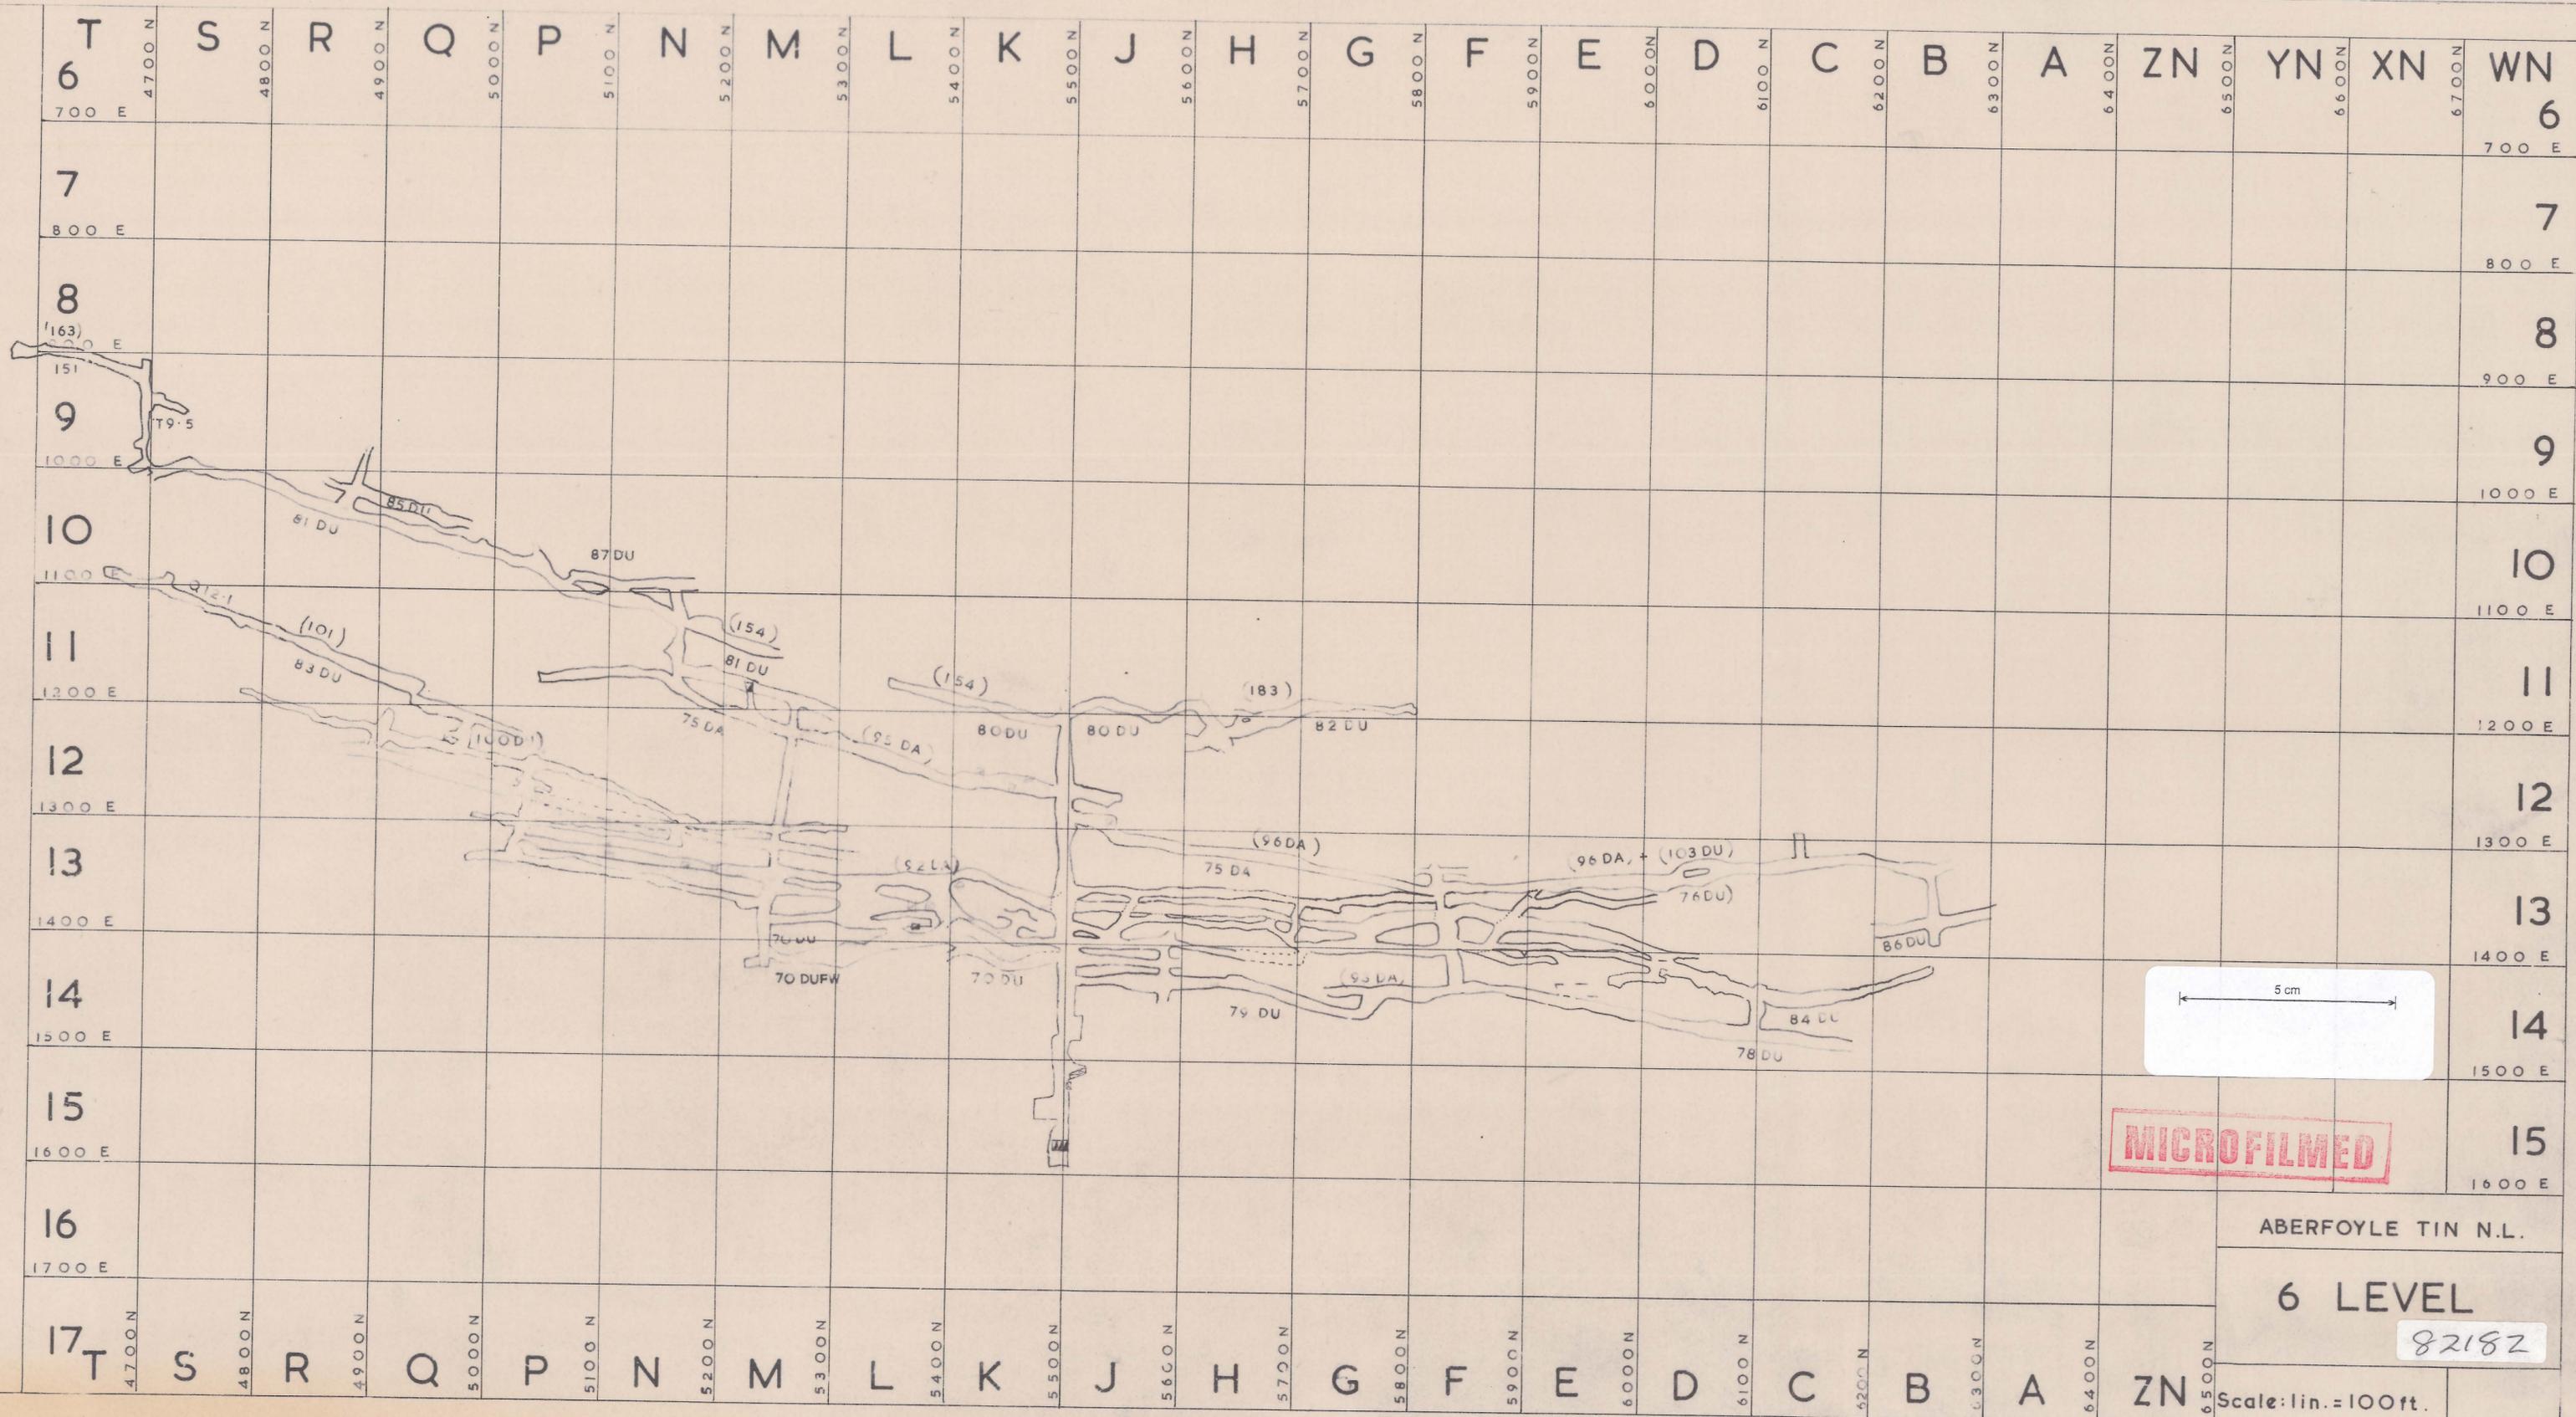

MICROFILMED

ABERFOYLE TIN N.L.

6 LEVEL

82182

Scale: lin. = 100ft.