


ABERF_766

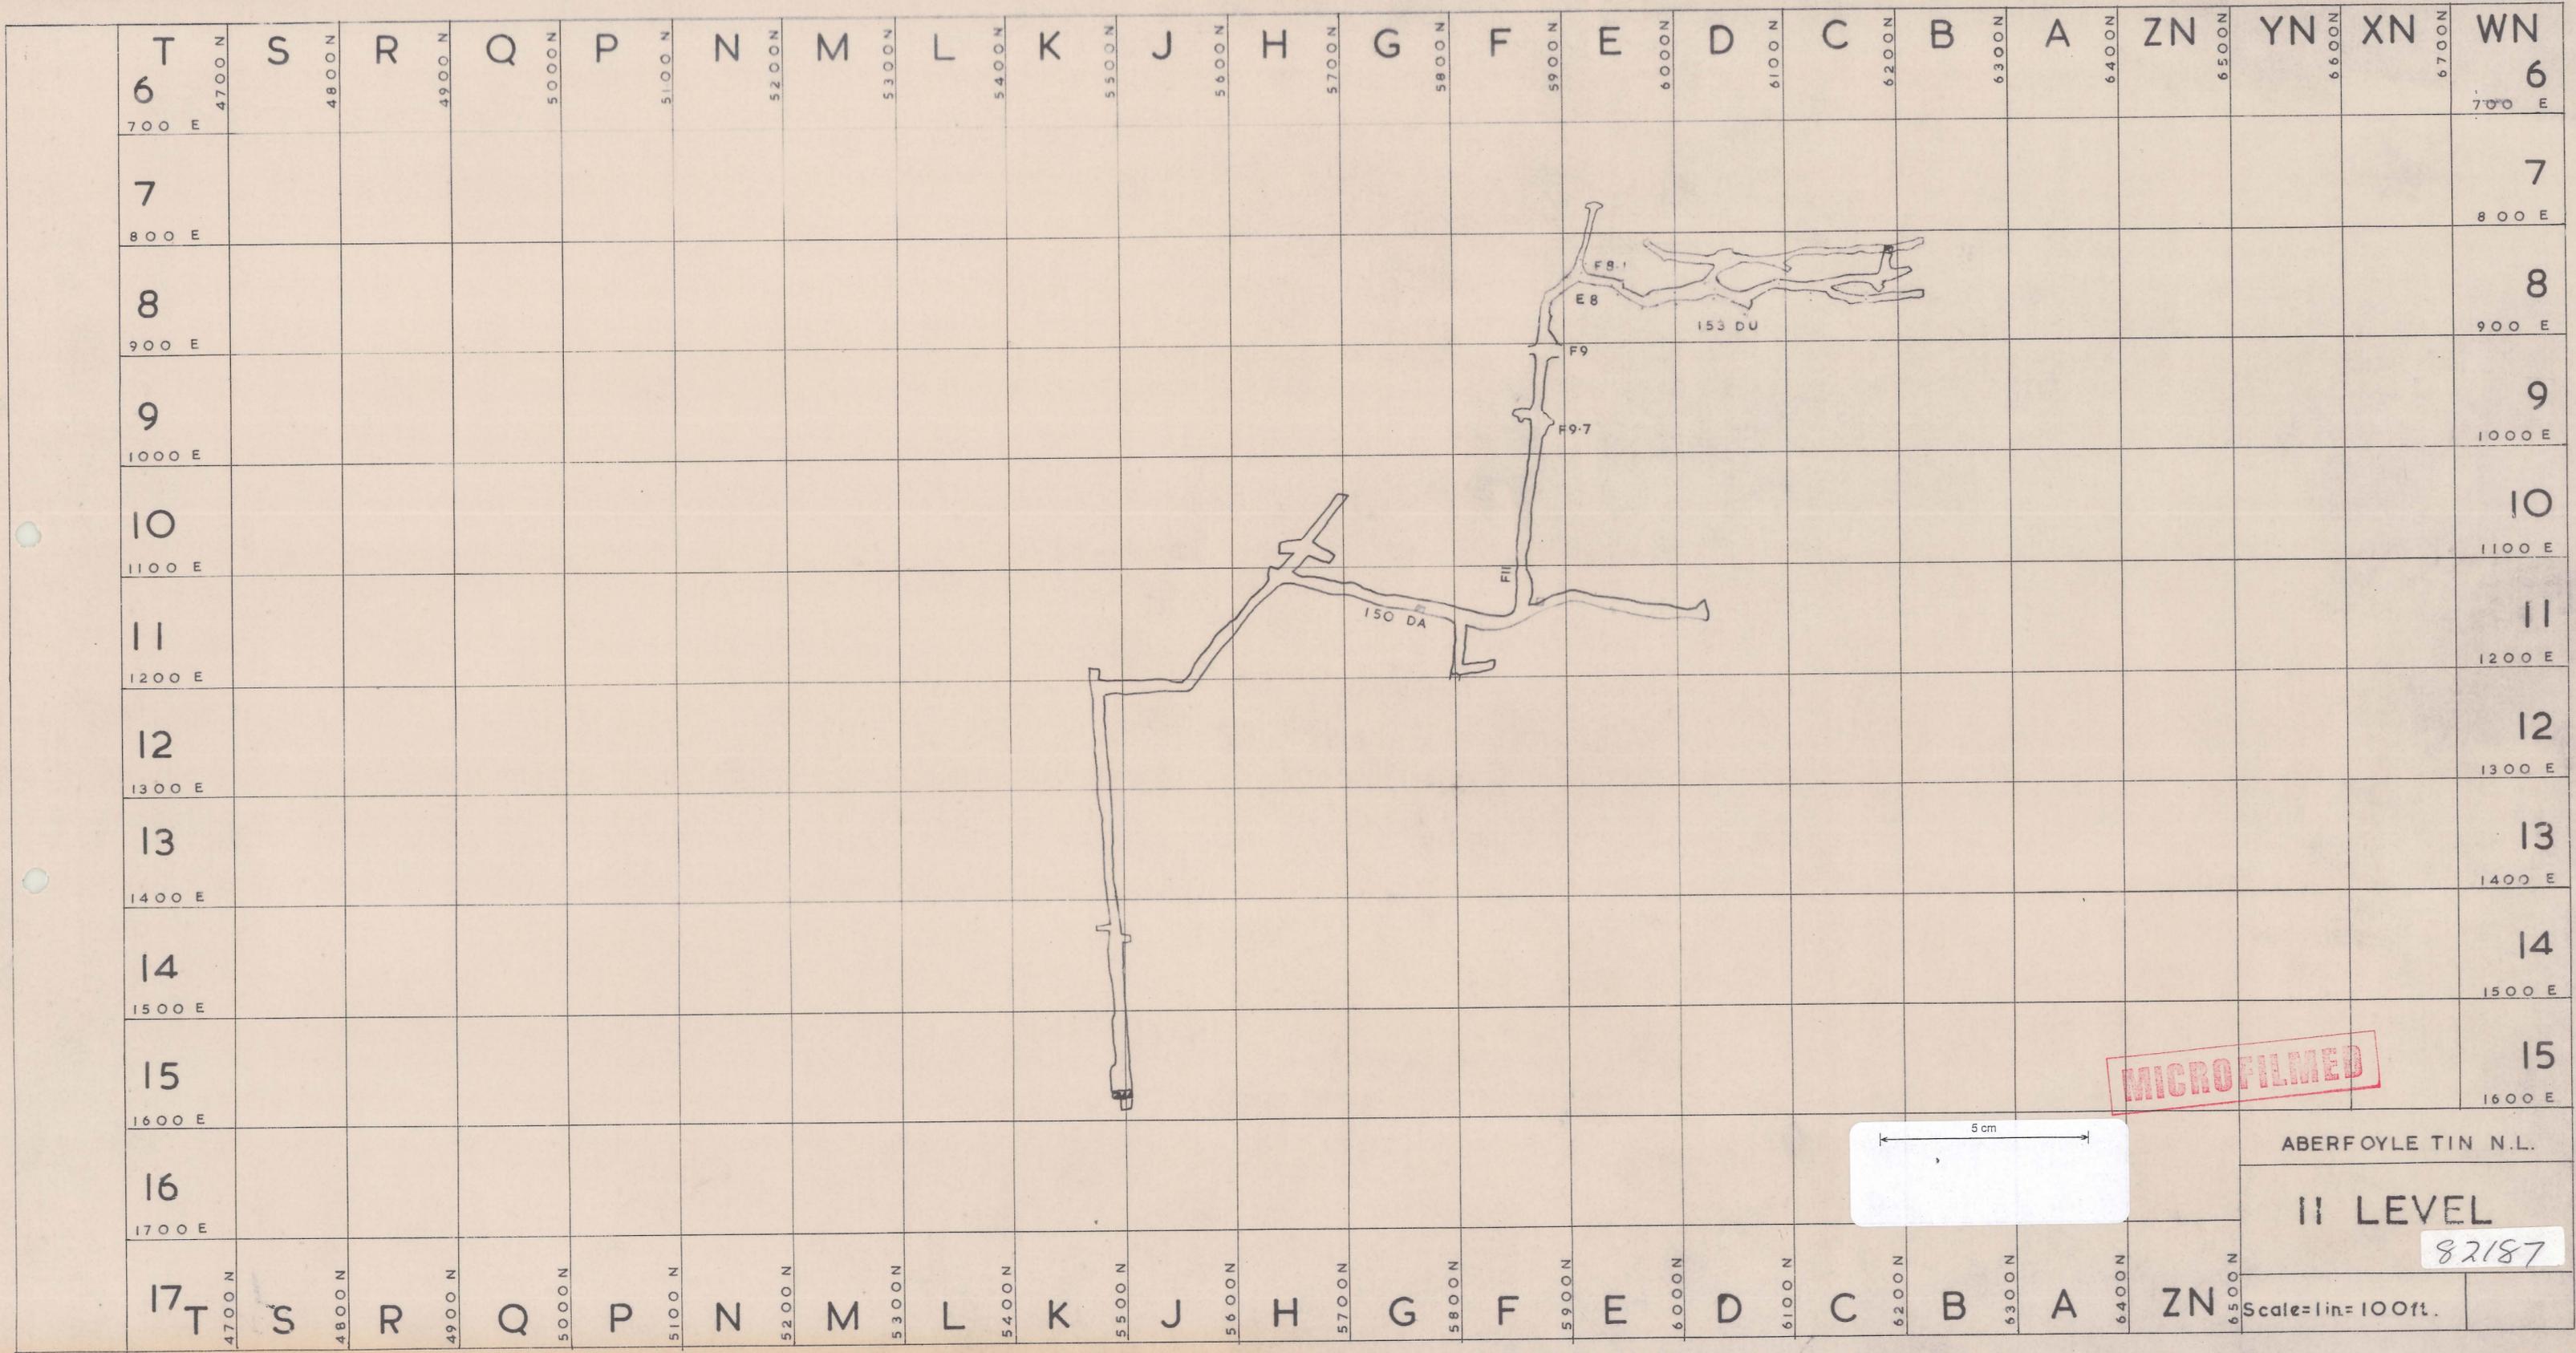

MICROFILMED

ABERFOYLE TIN N.L.

II LEVEL

82187

Scale = 1 in = 100 ft.