


ABERF_767

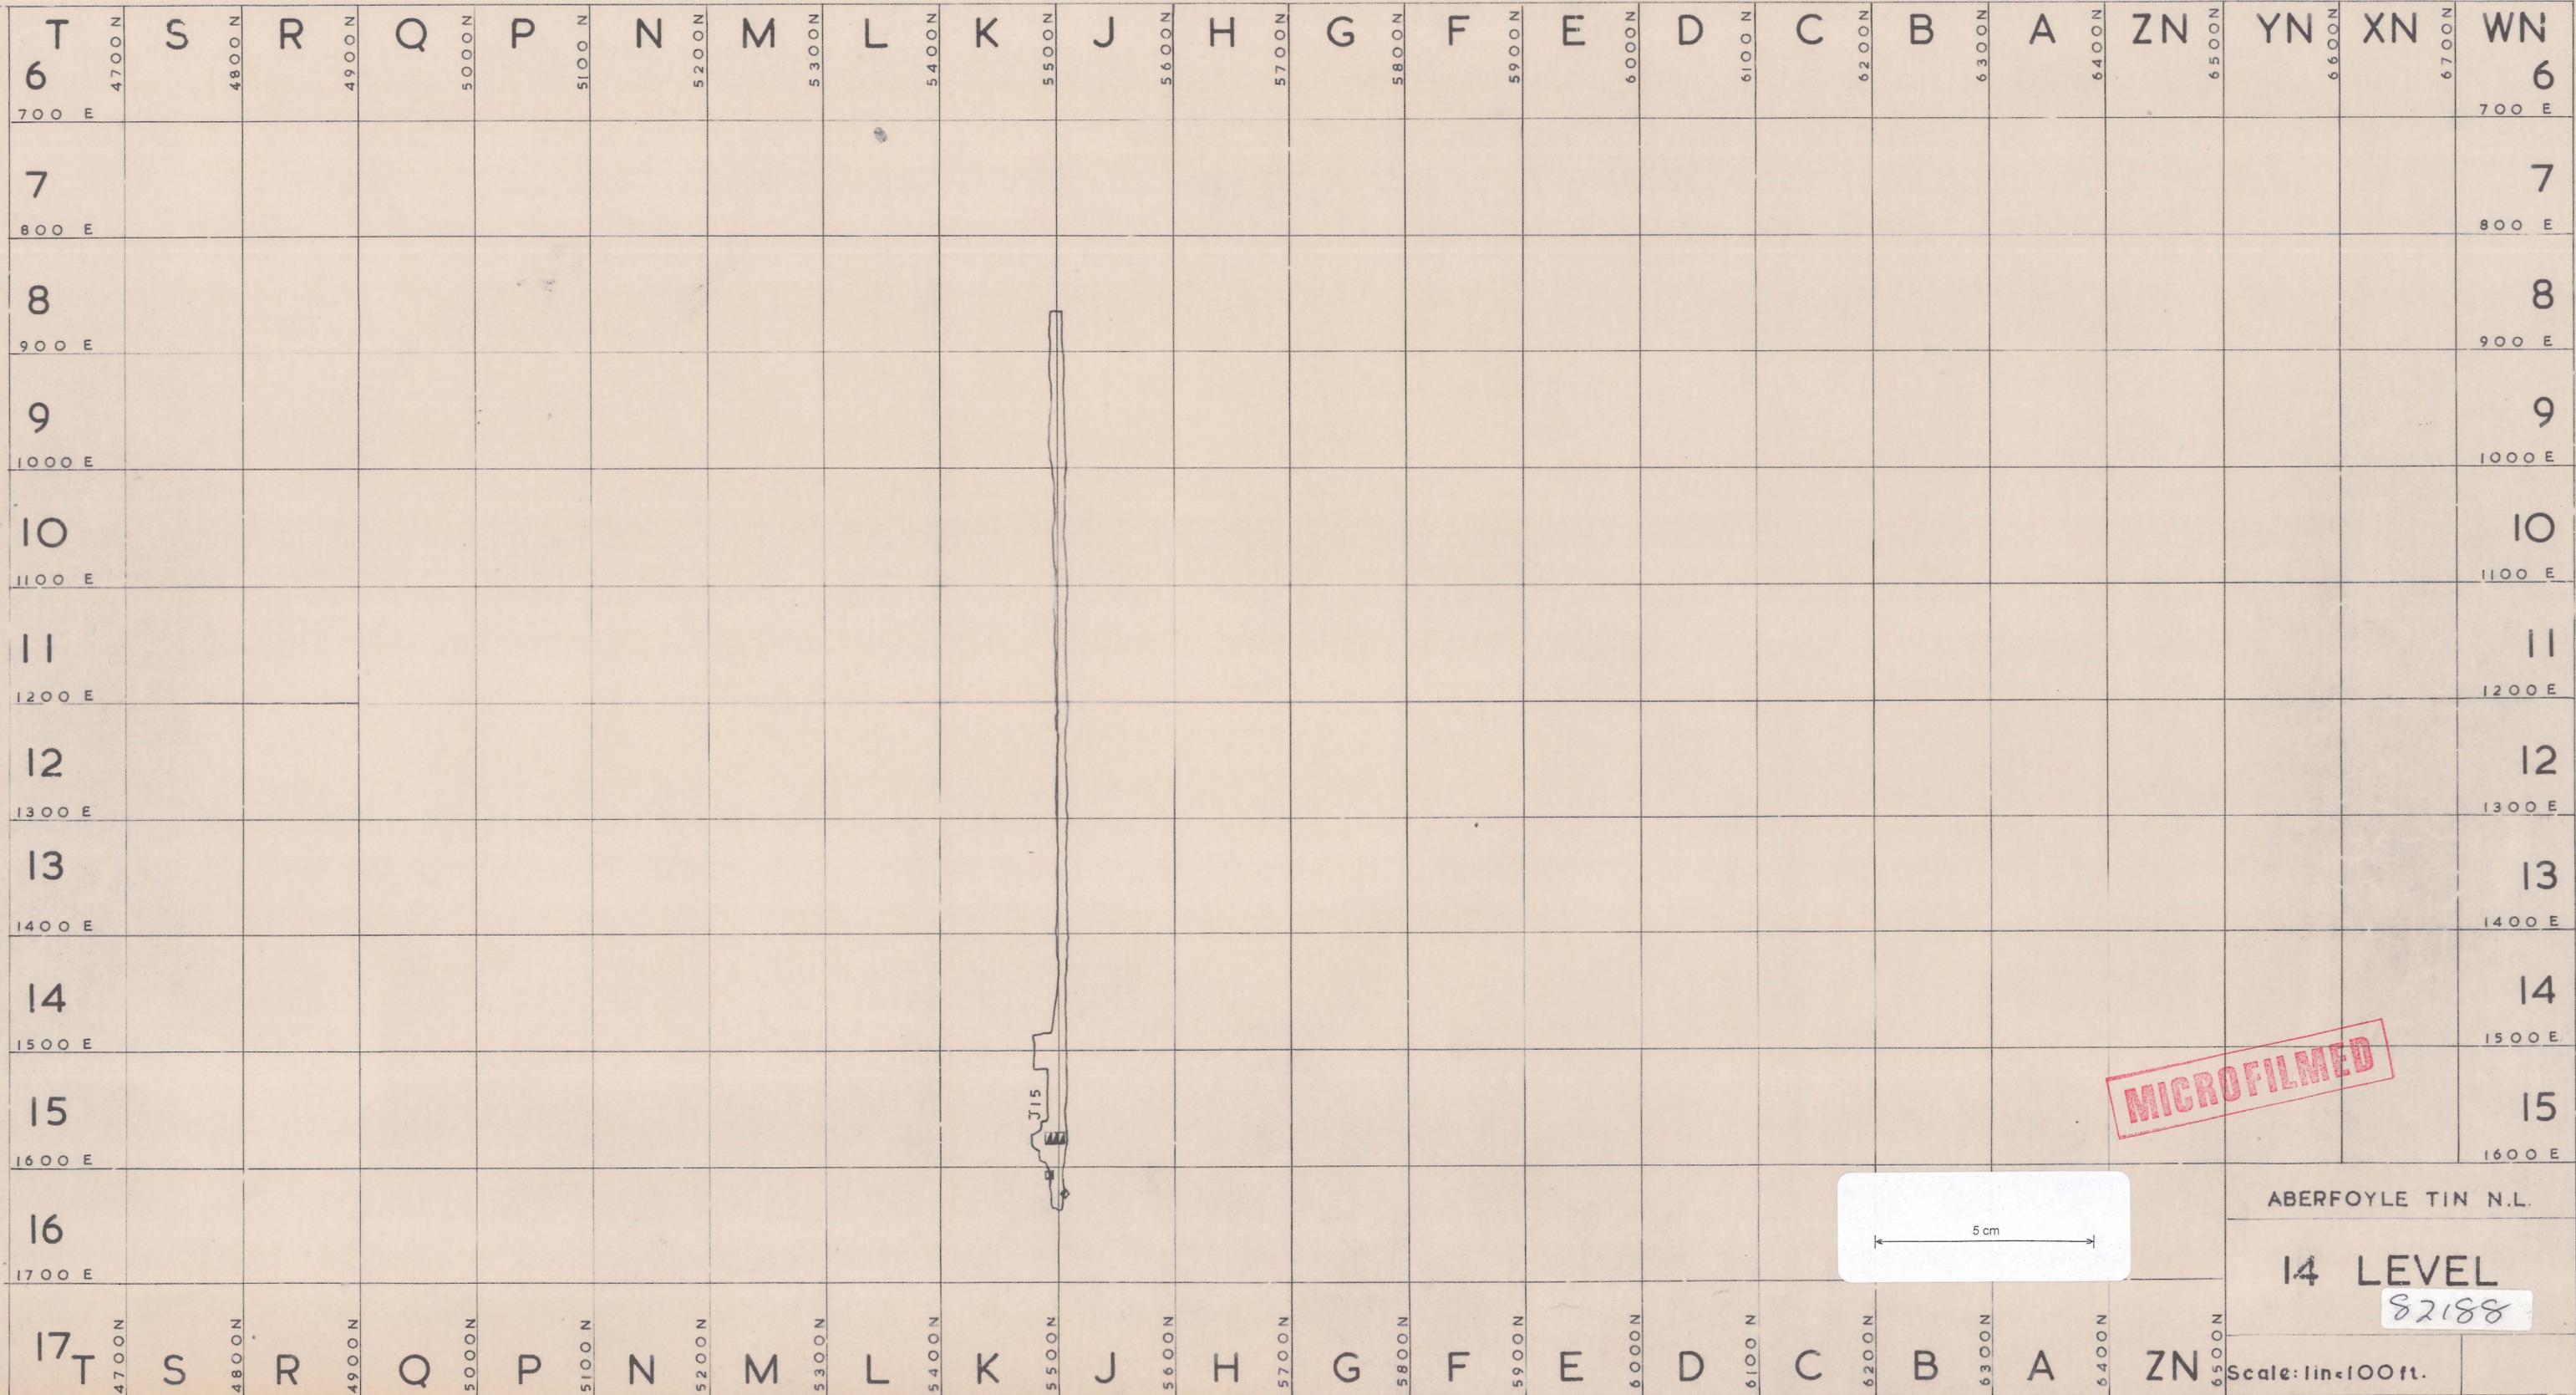

MICROFILMED

ABERFOYLE TIN N.L.

14 LEVEL

82188

Scale: 1 in = 100 ft.