


ABERF_769



MICROFILMED

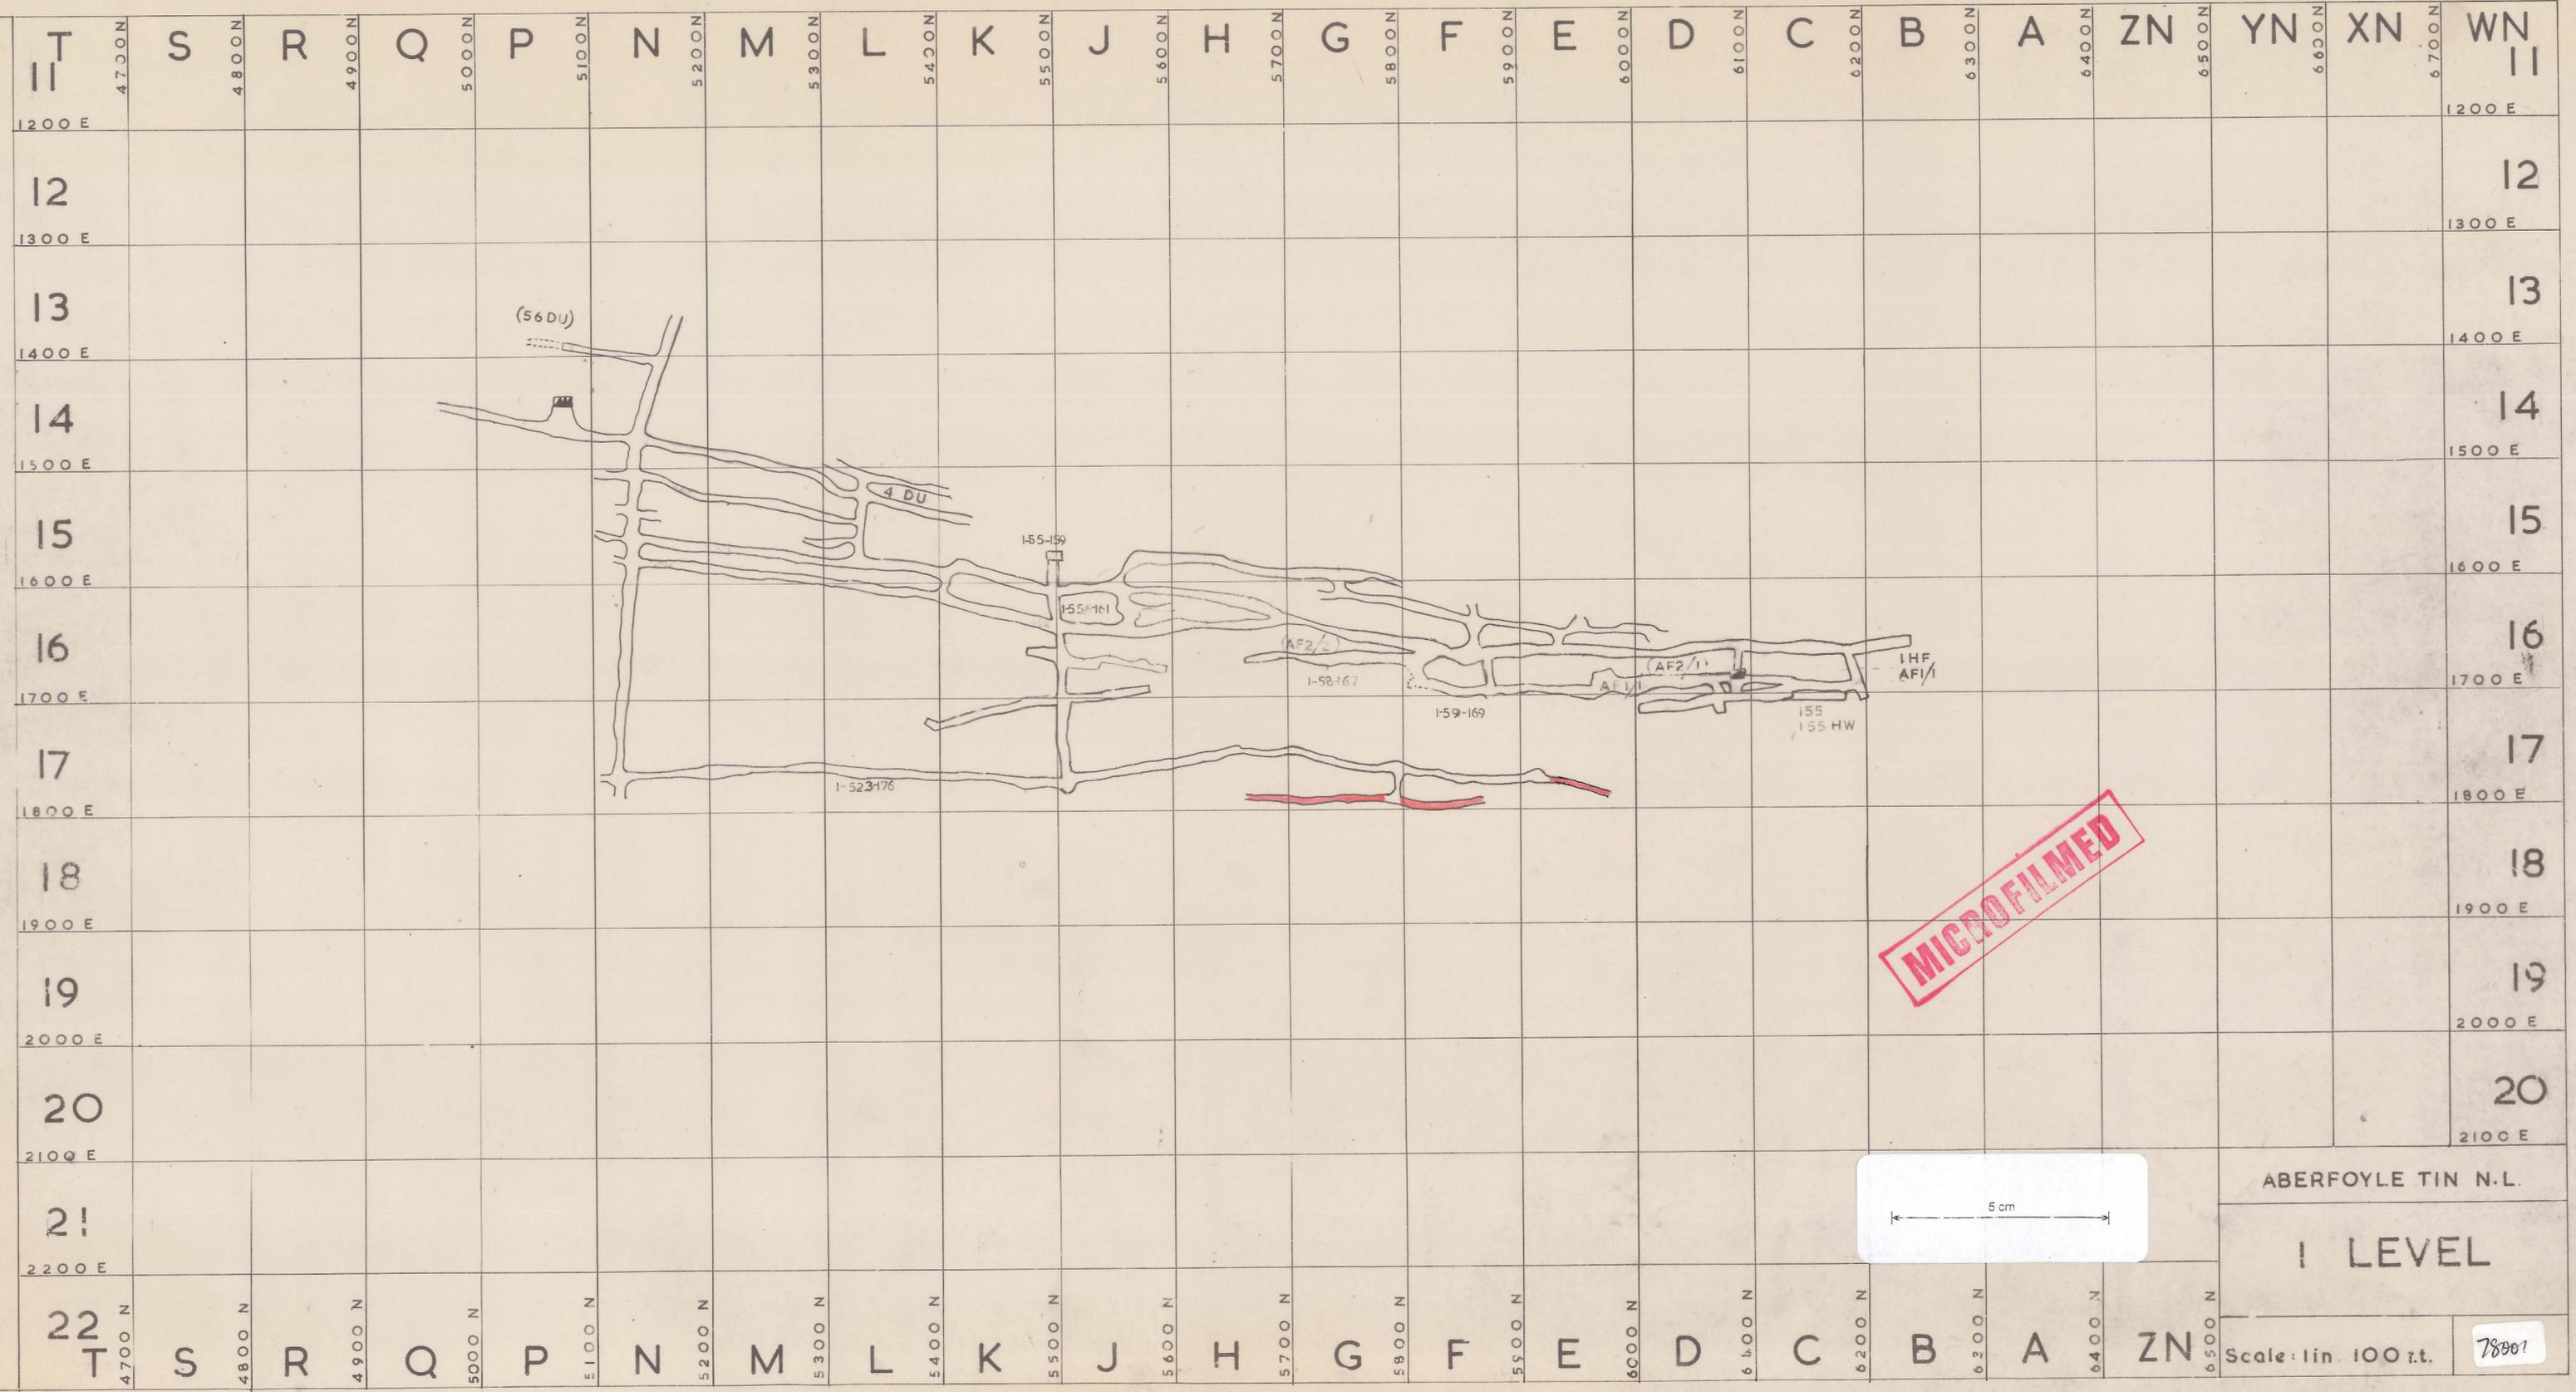

ABERFOYLE TIN N.L.

I LEVEL

Scale: 1 in. 100 ft.

78001