


ABERF_774

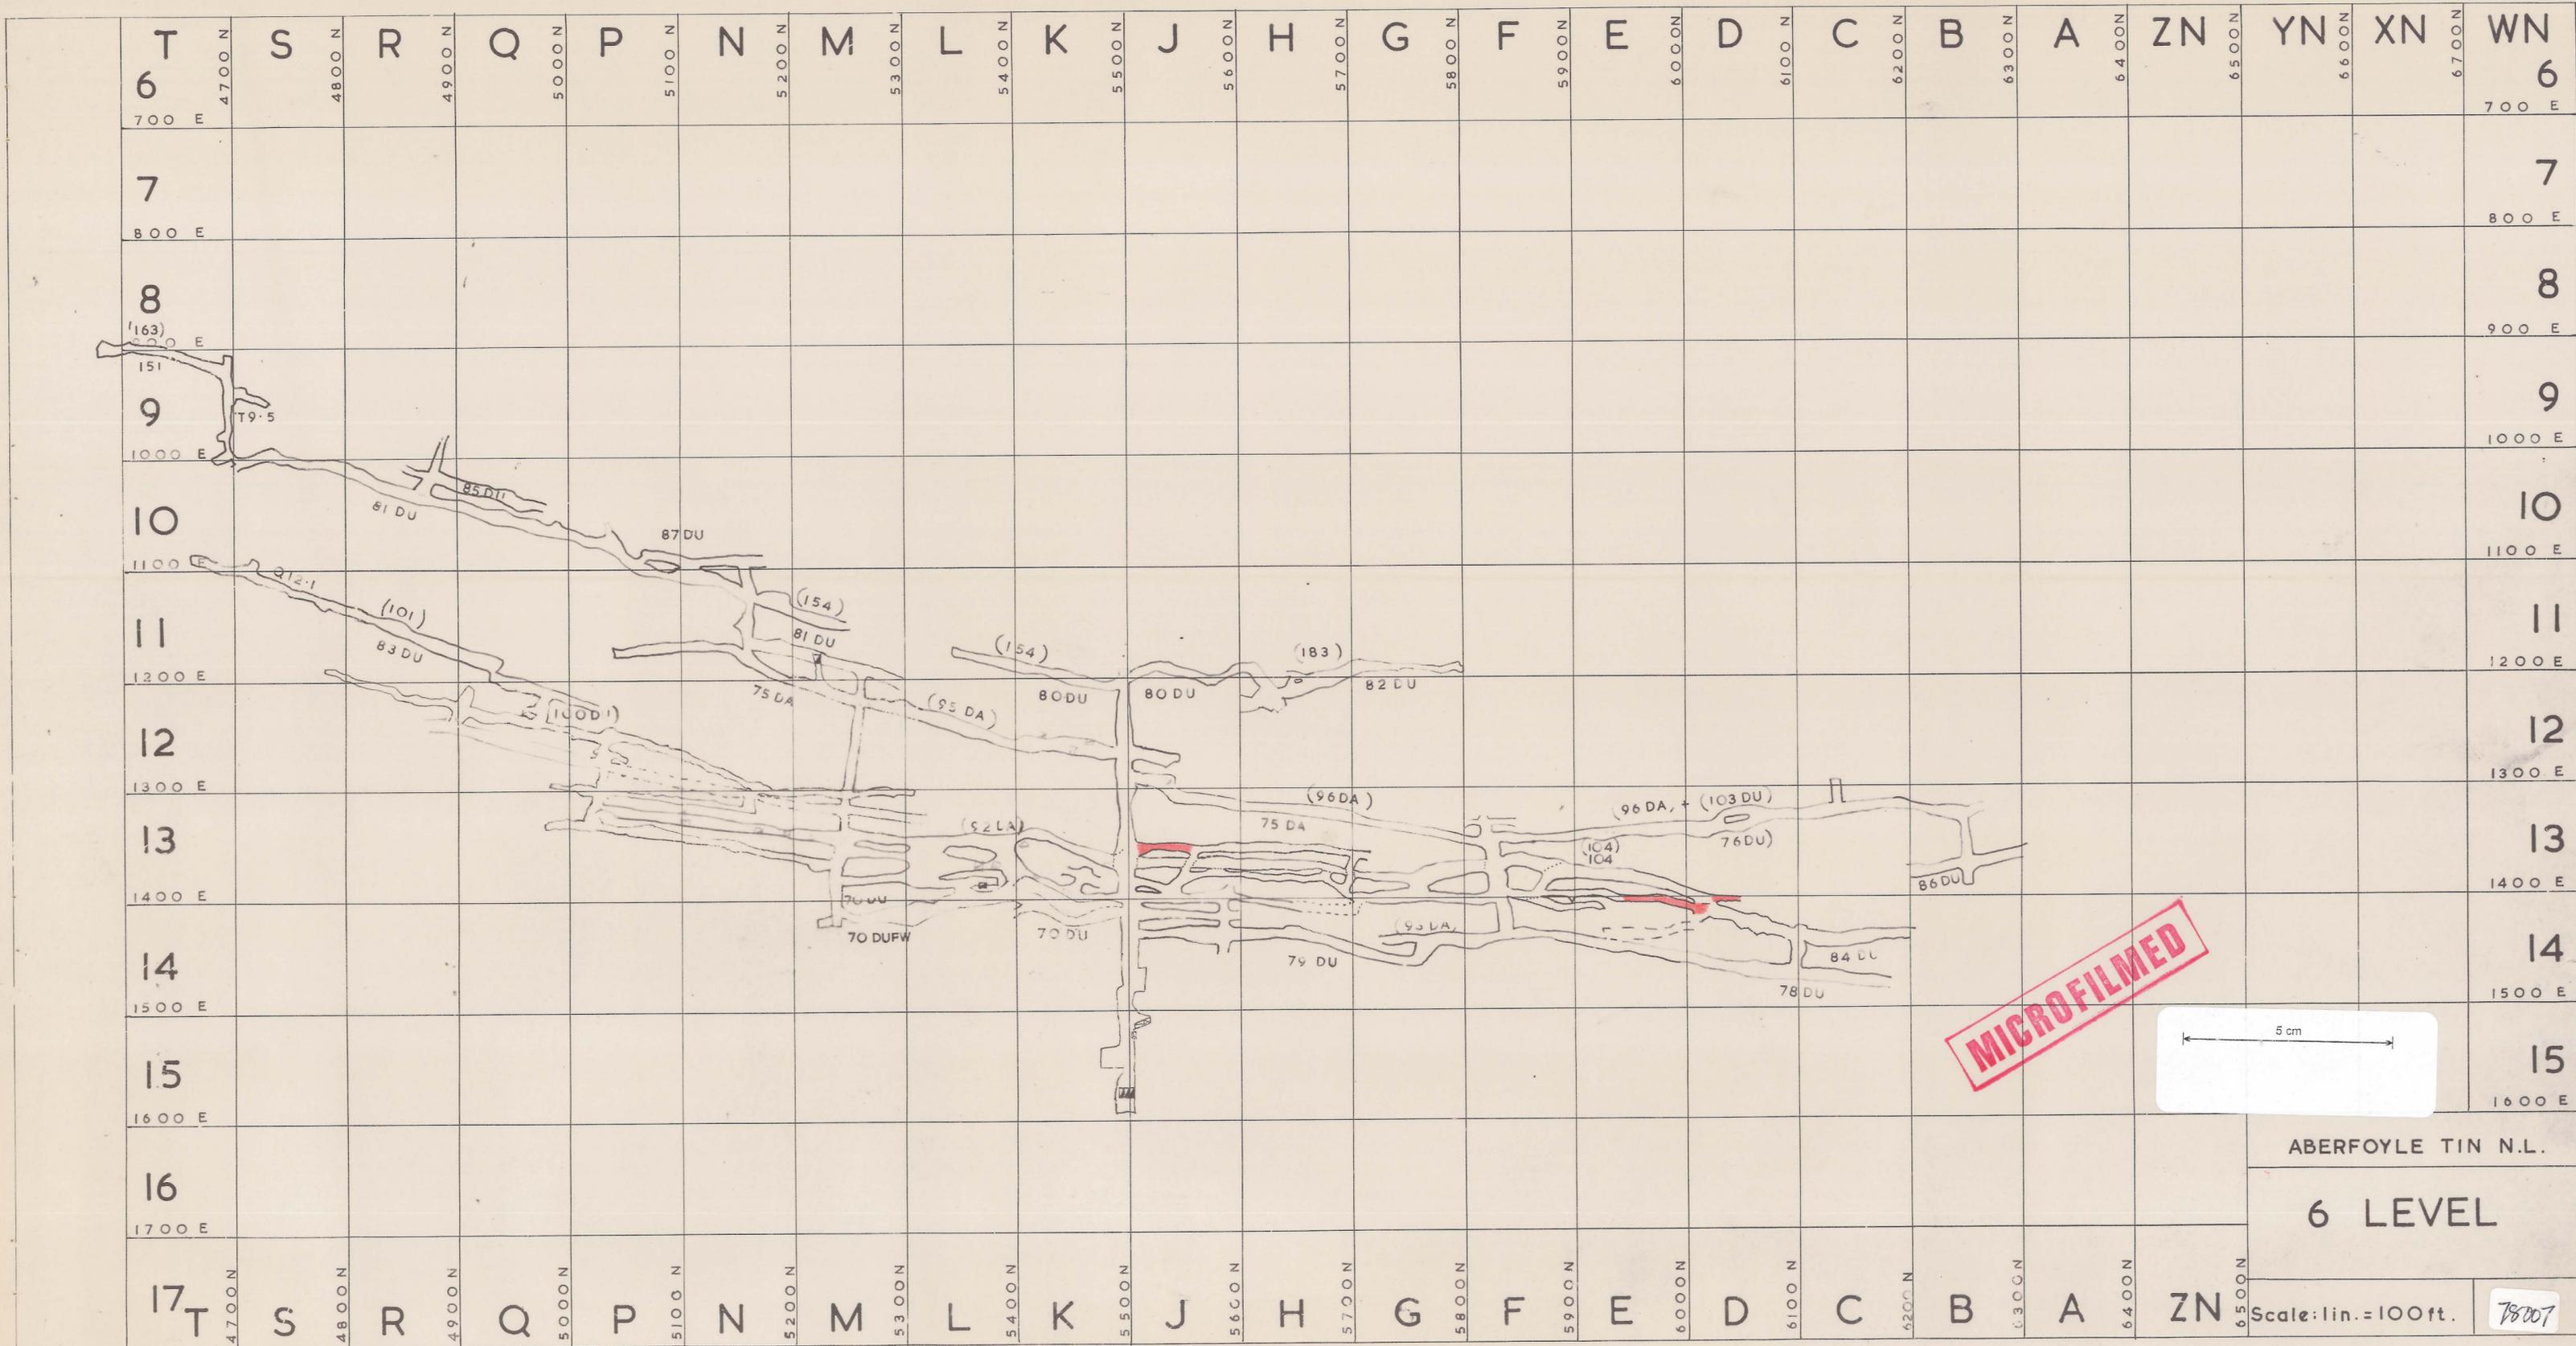

ABERFOYLE TIN N.L.

6 LEVEL

Scale: lin. = 100ft.

78007