



ABERF\_775

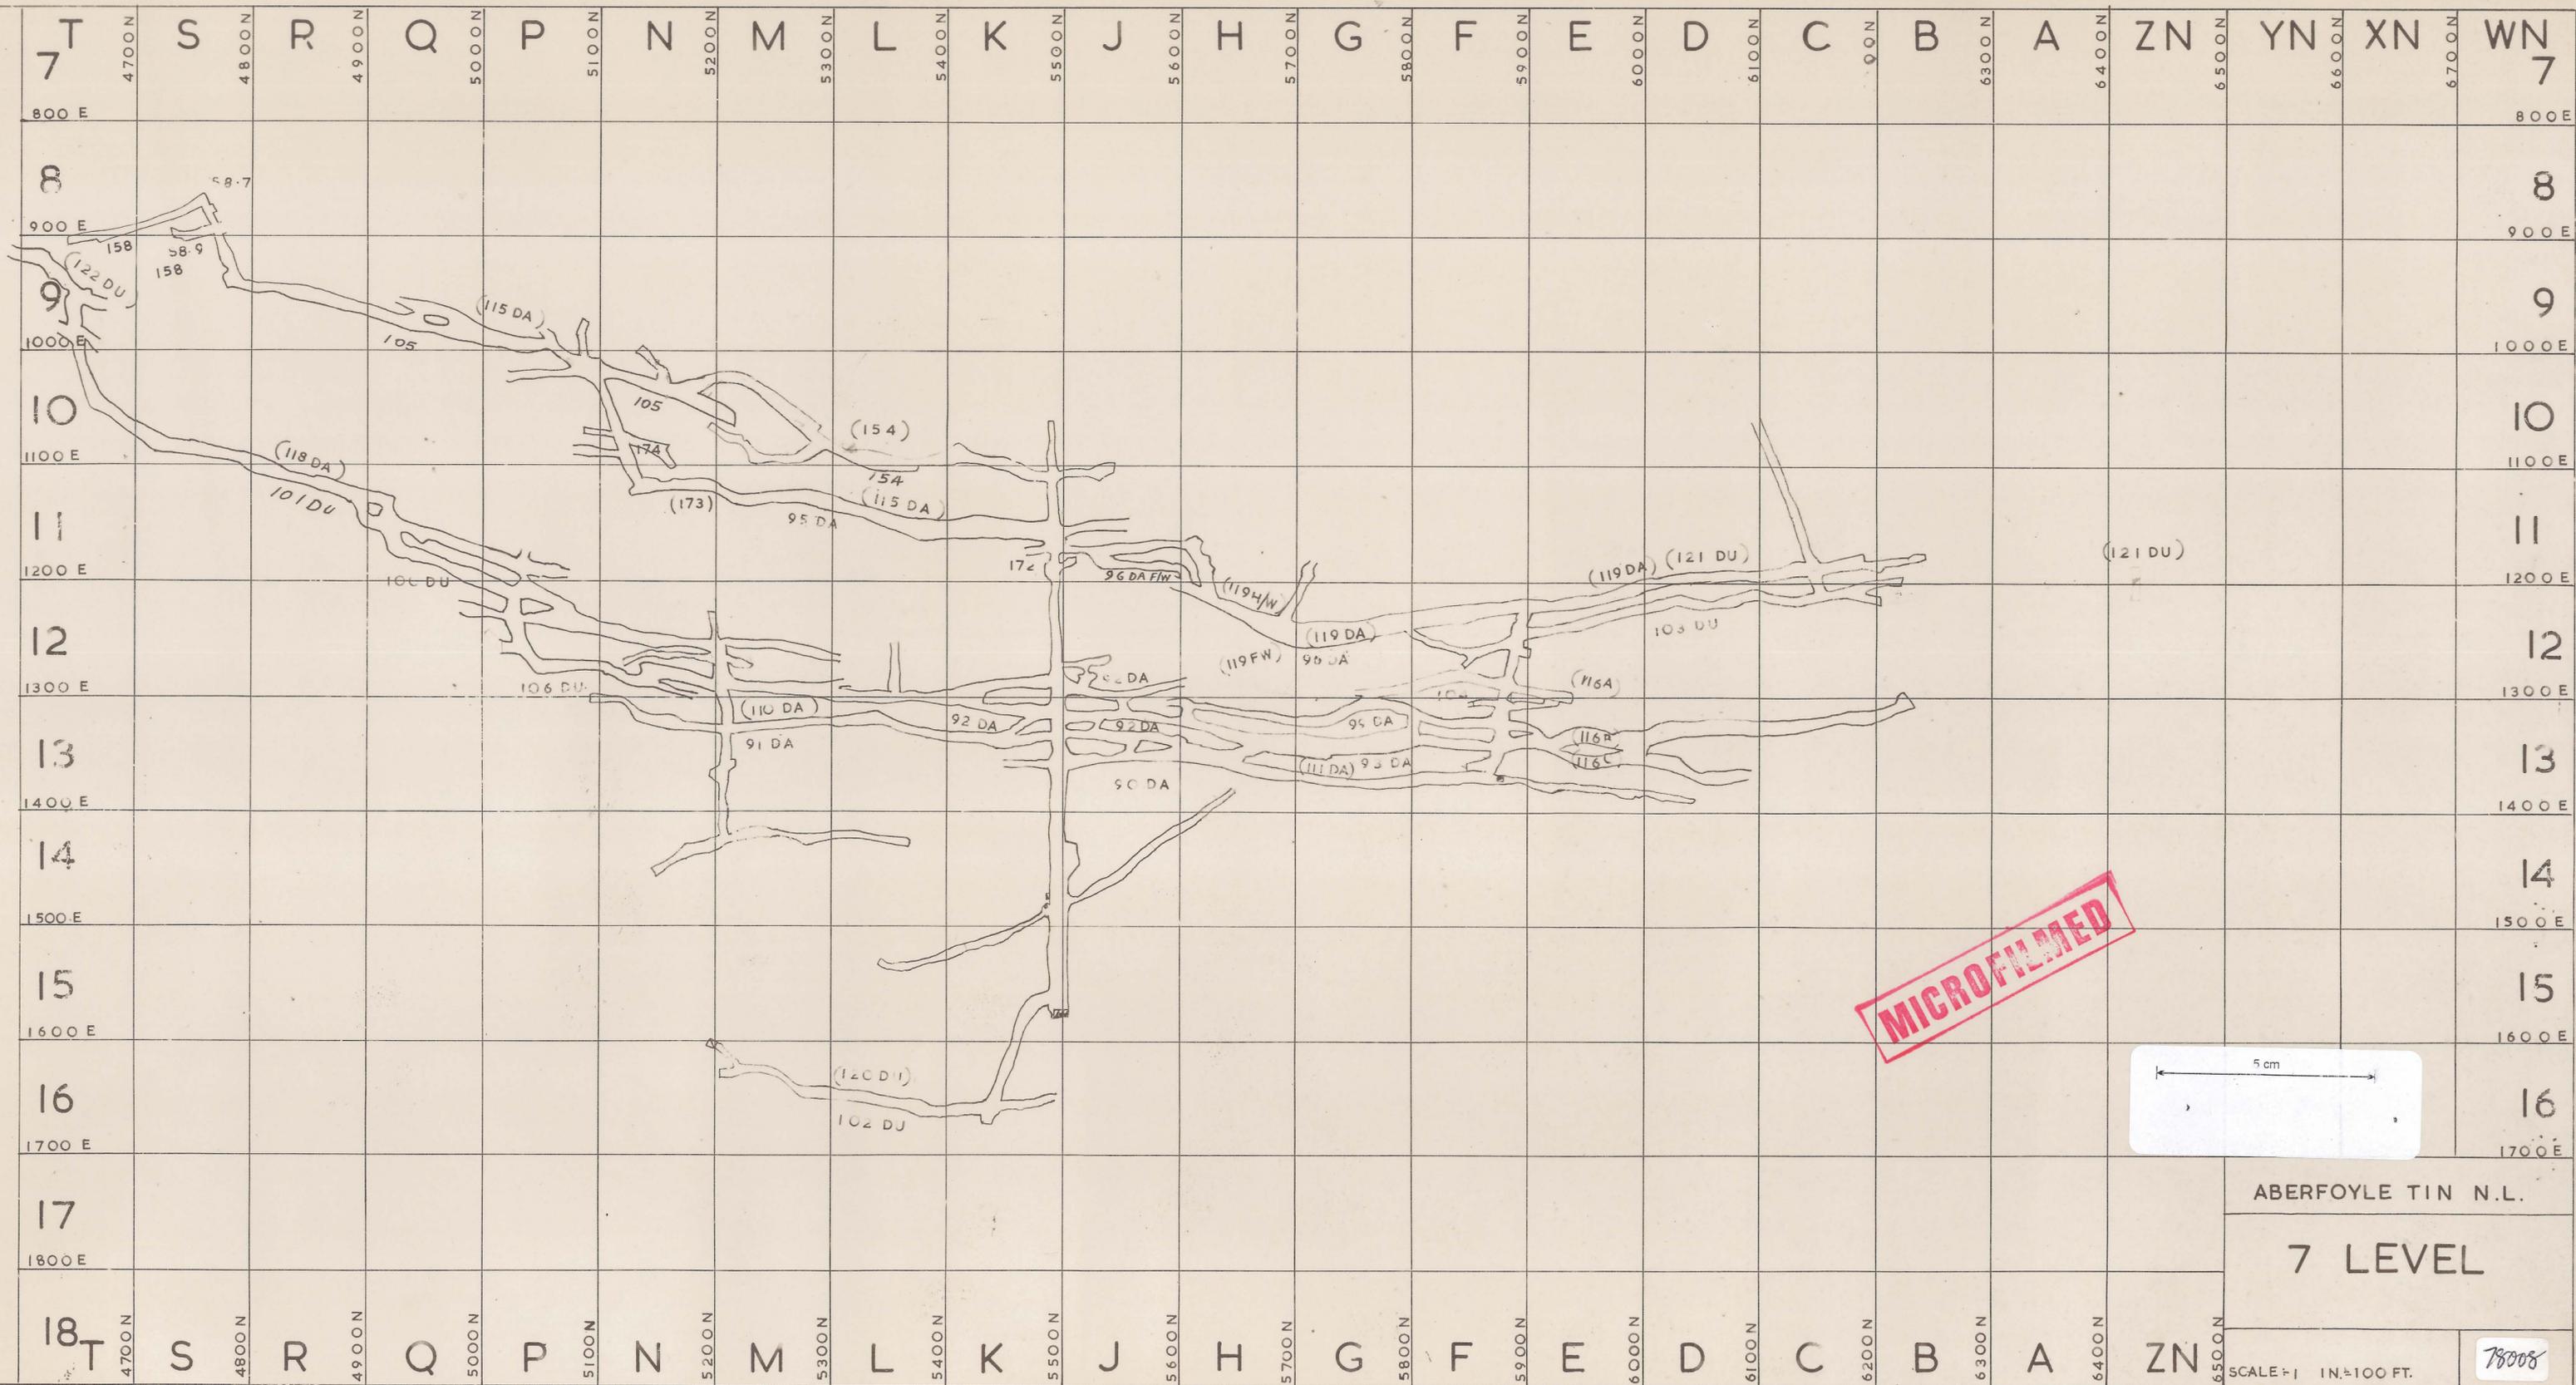

MICROFILMED

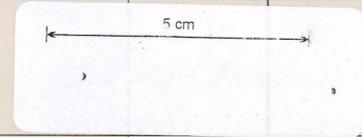

ABERFOYLE TIN N.L.

7 LEVEL

SCALE = 1 IN. = 100 FT.

78008