


ABERF_776

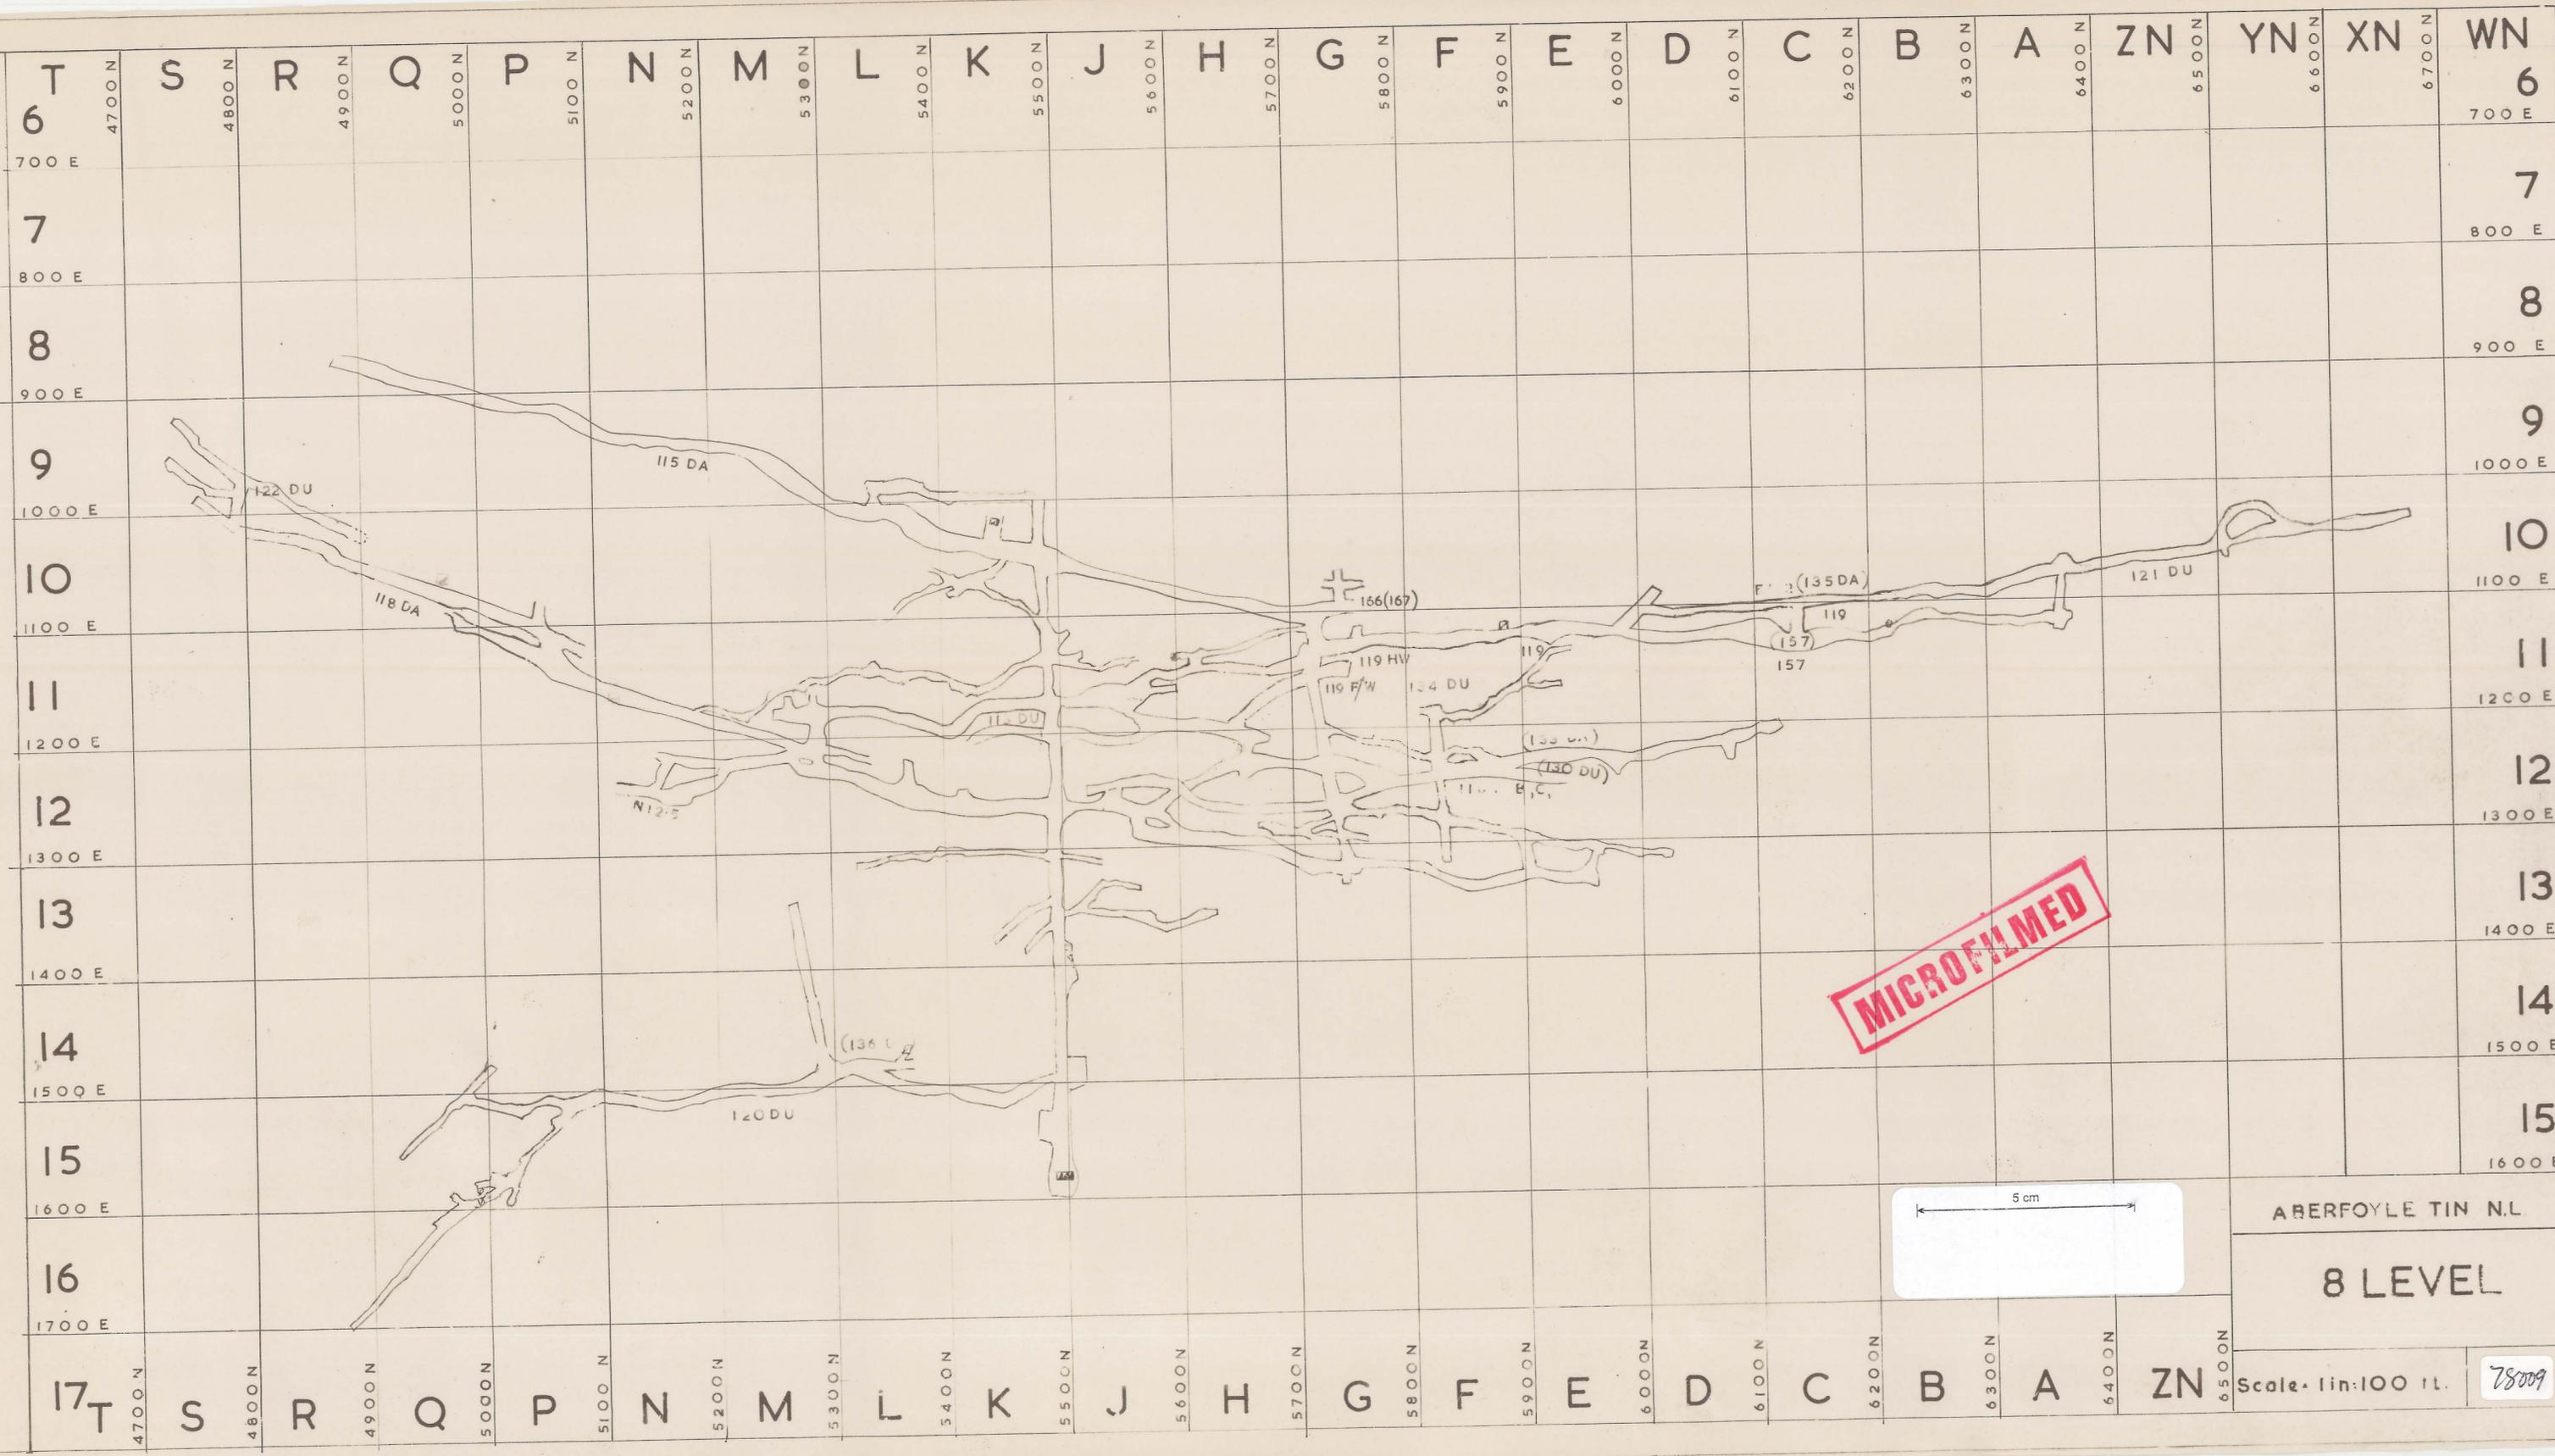

ABERFOYLE TIN N.L.

8 LEVEL

Scale: 1 in: 100 ft.

78009