



ABERF\_777

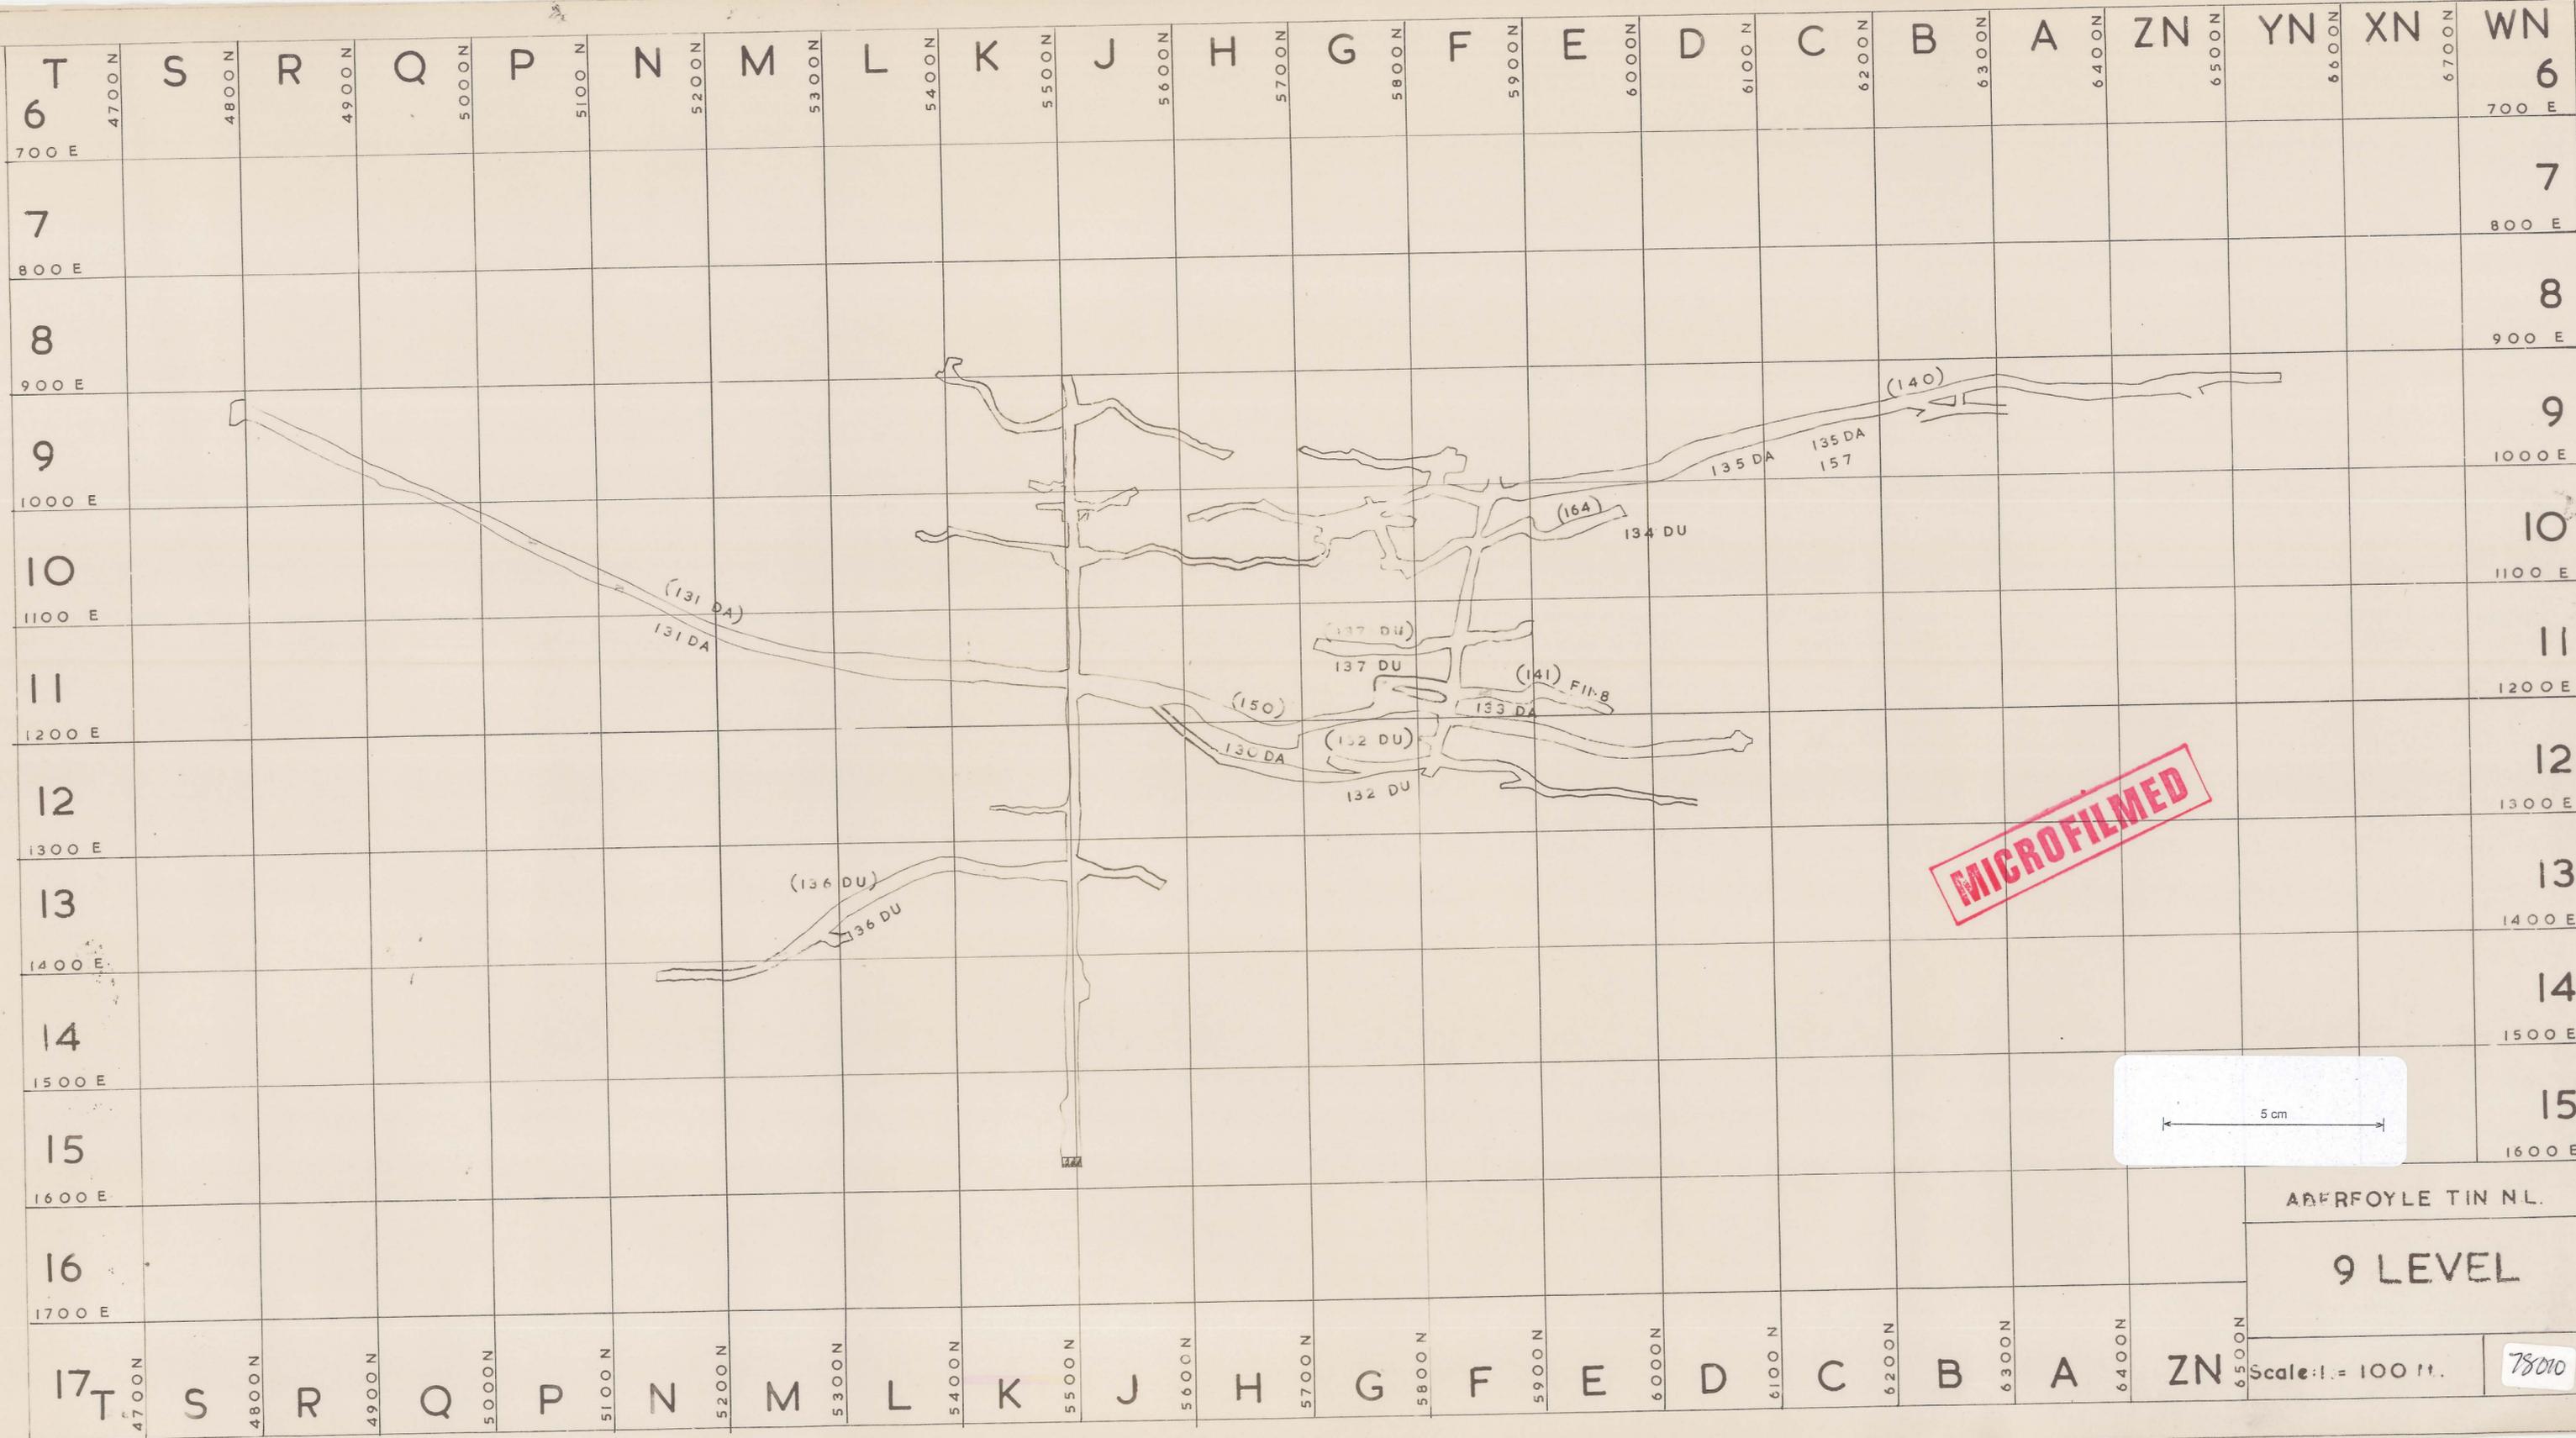

**MICROFILMED**

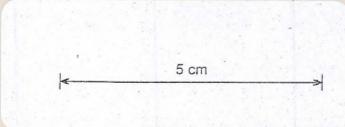

ABERFOYLE TIN NL.

9 LEVEL

Scale: 1" = 100 ft.

78010