


ABERF\_778



MICROFILMED

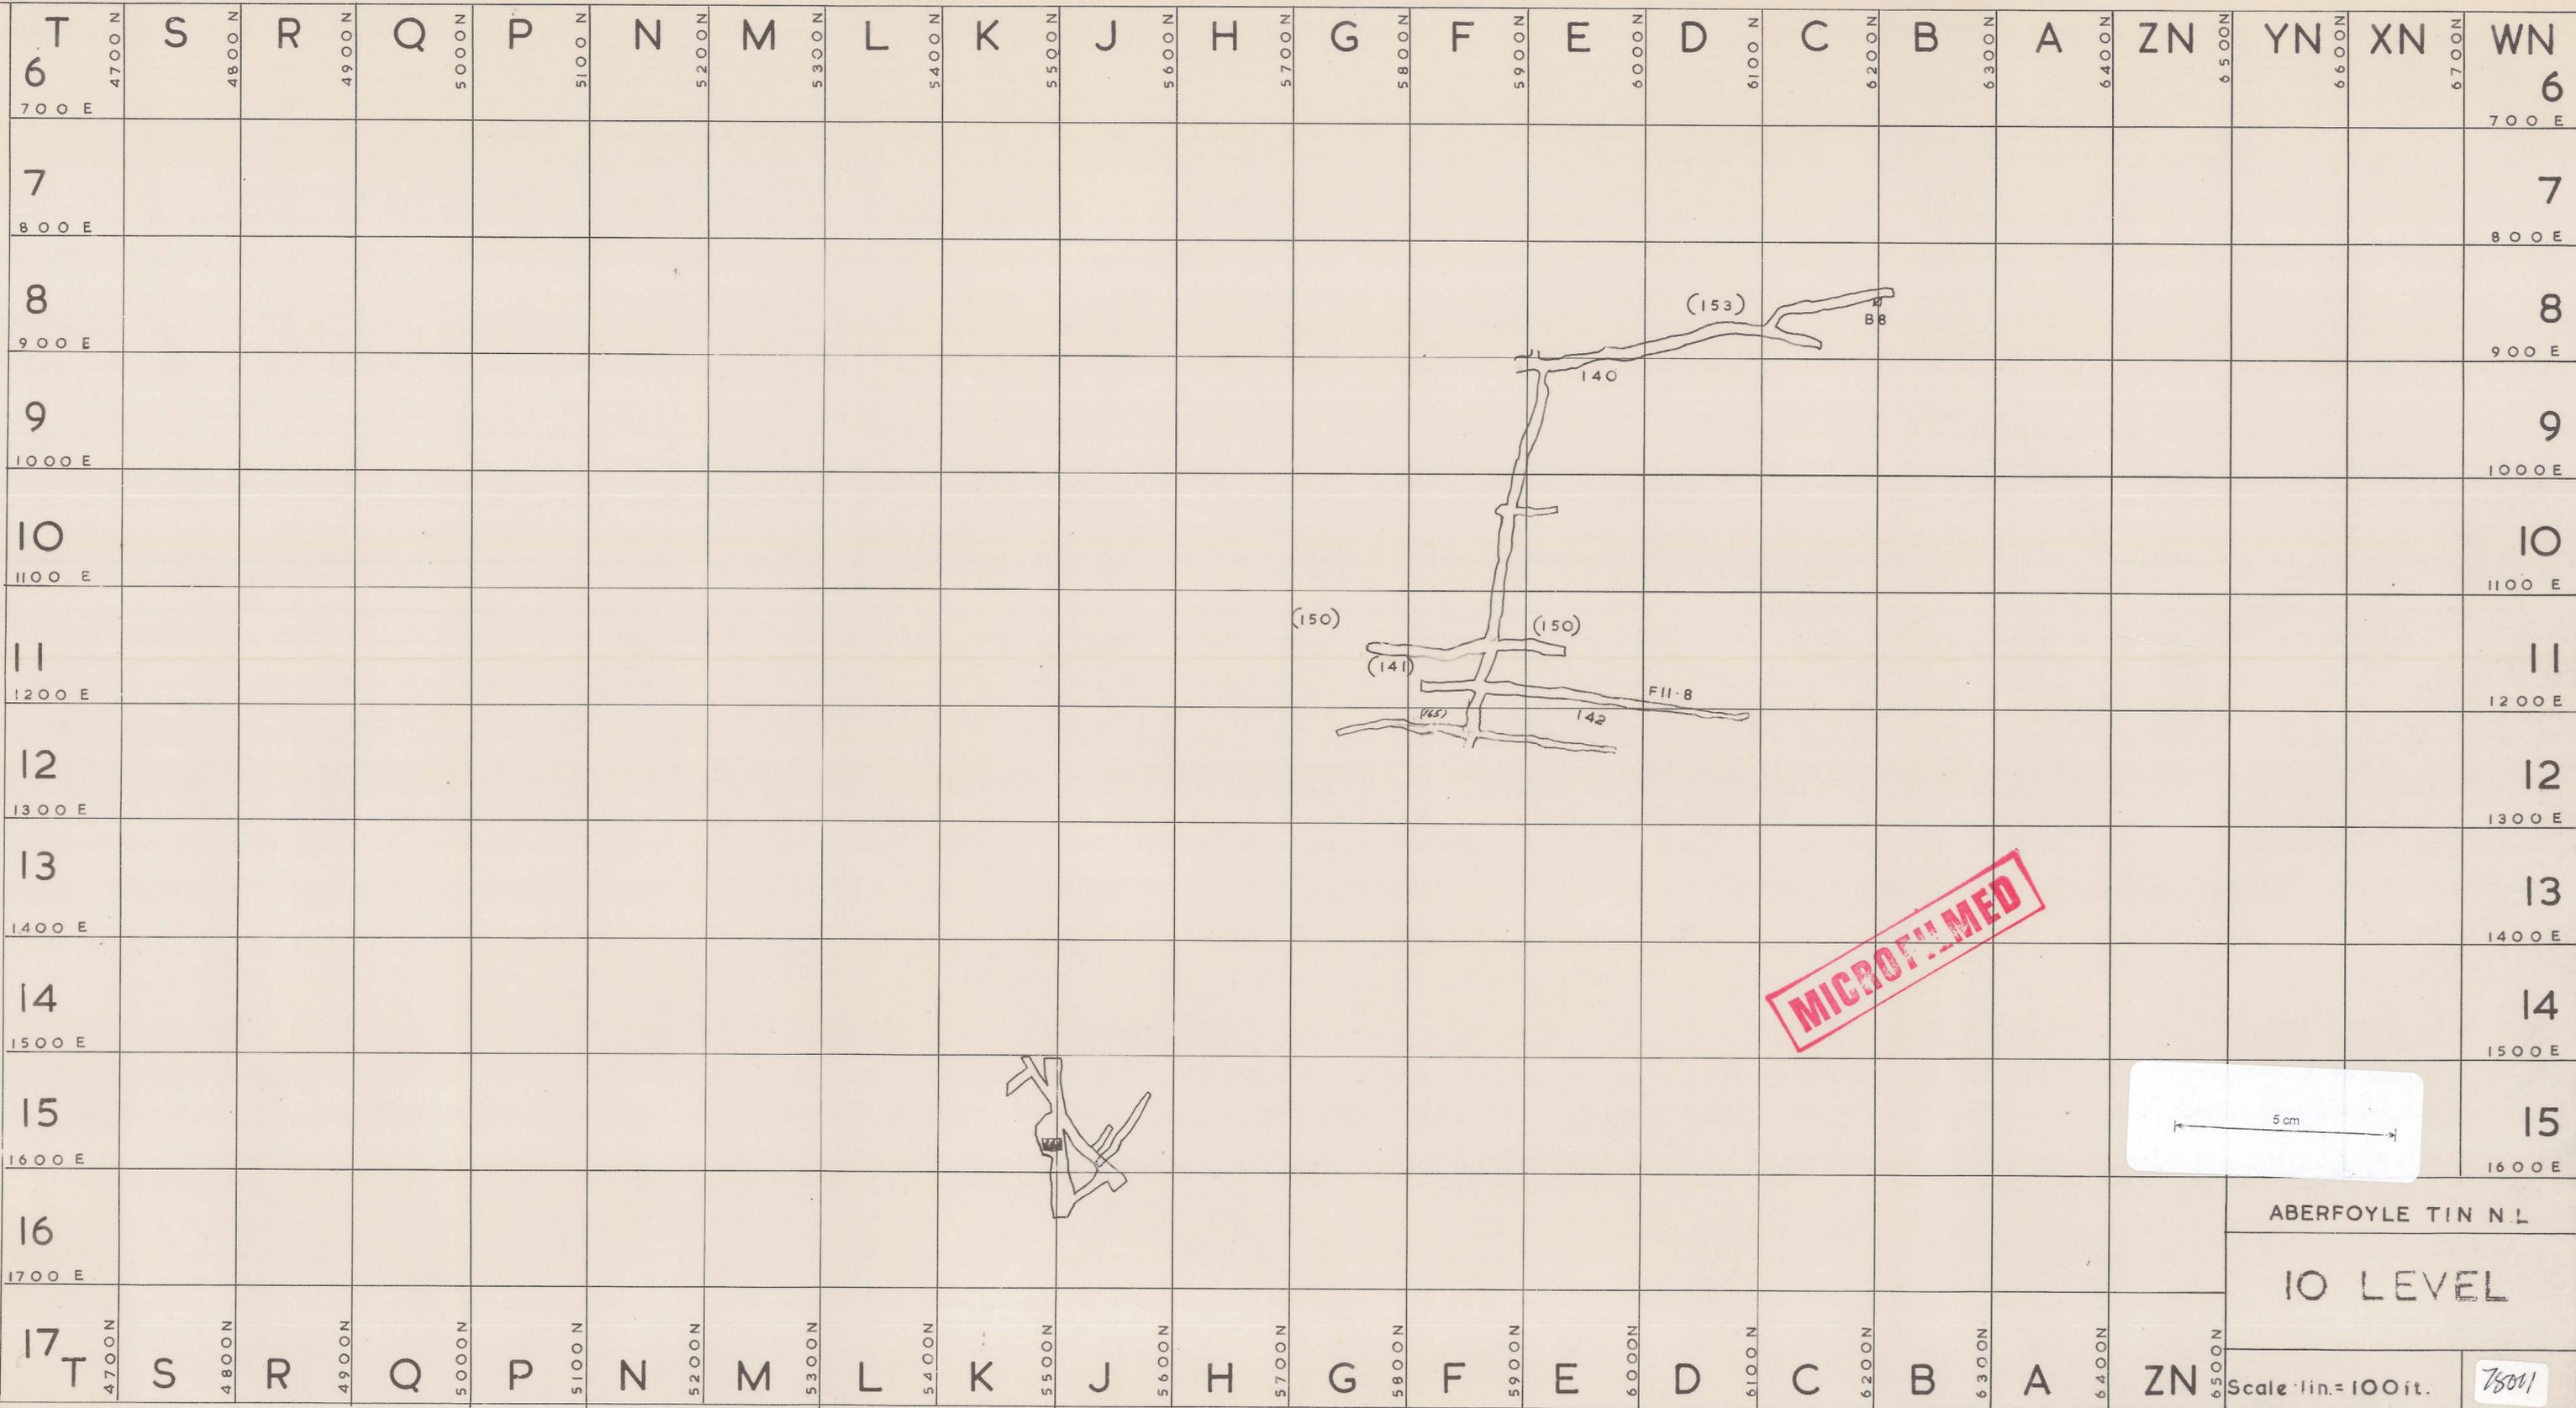

ABERFOYLE TIN N.L.  
 10 LEVEL  
 Scale 1 in. = 100 ft. 75001