



ABERF_782

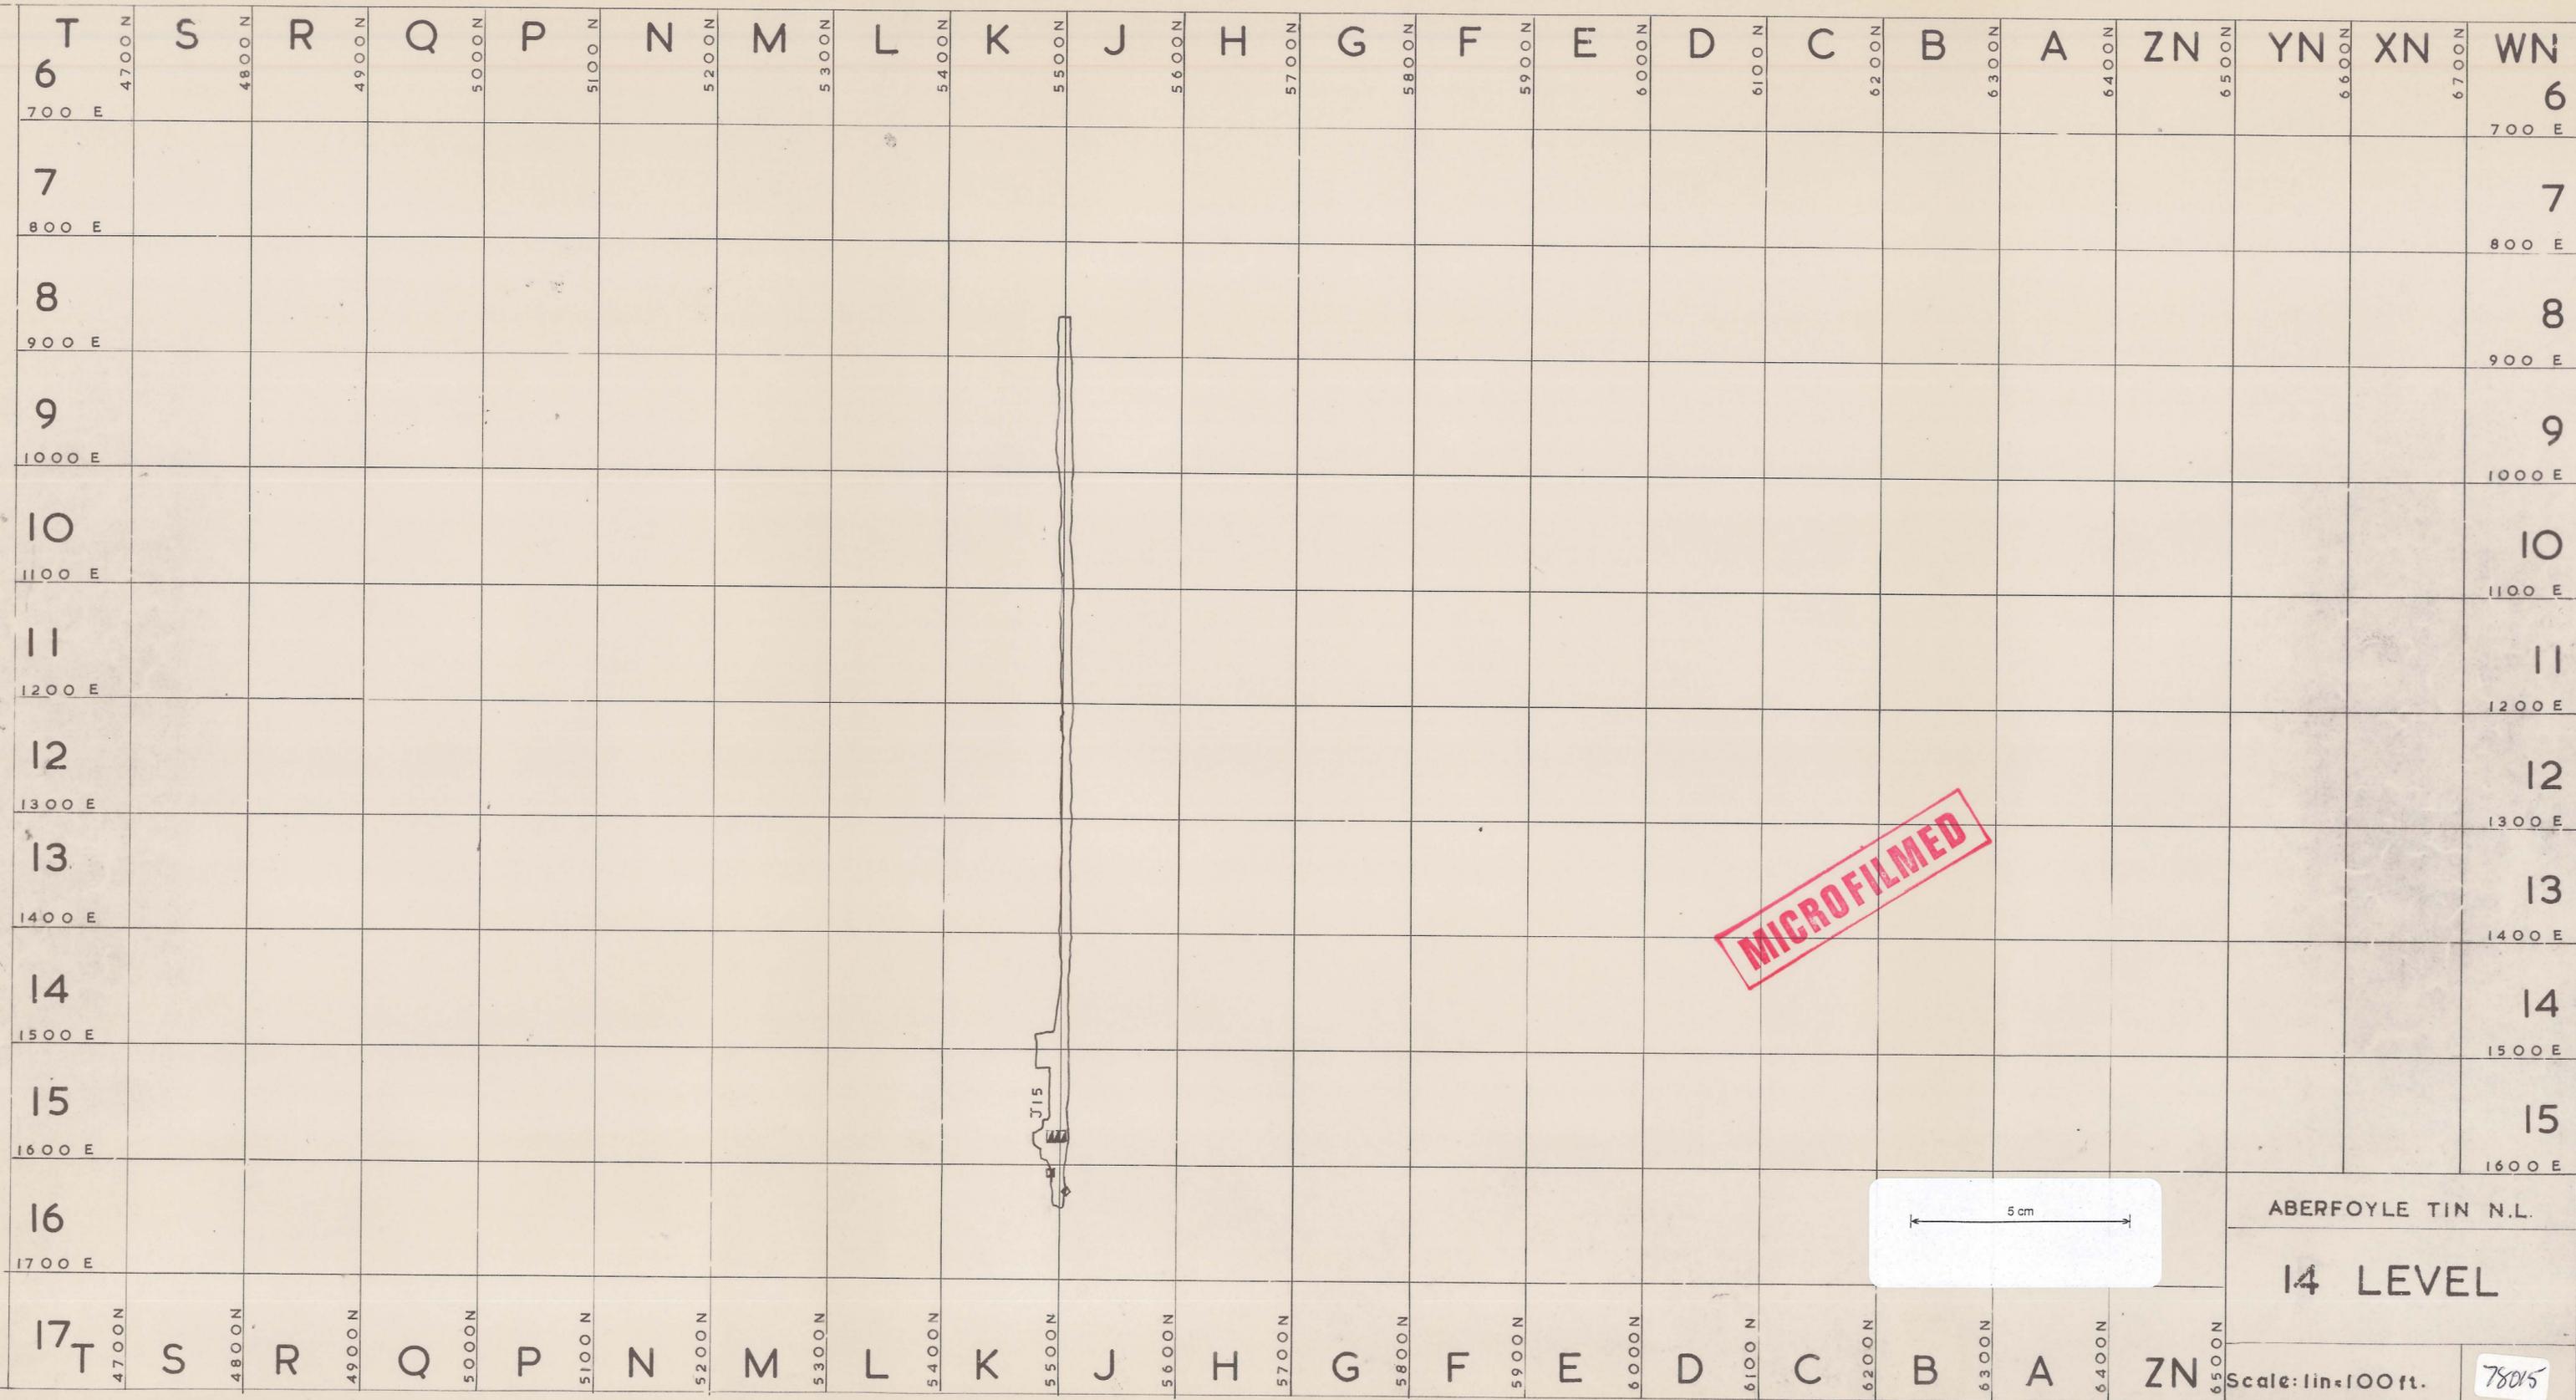

MICROFILMED

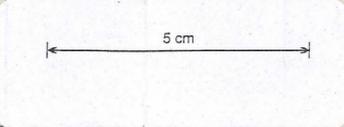

ABERFOYLE TIN N.L.

14 LEVEL

Scale: 1 in = 100 ft.

78015