

ROSSARDEN MINES LIMITED

STOREYS CREEK MINE

LEVEL PLANS


as at 26-2-82

H. Clayton  
Surveyor

Certification: Section 31 (1) (6) Mines Inspection Act.

I certify that to the best of my knowledge and belief that the plans and sections of the Storeys Creek Mine attached are a true representation of the mine workings as at Monday 29 March 1982

H. Swain  
Registered Mine Manager.  
31 March 1982

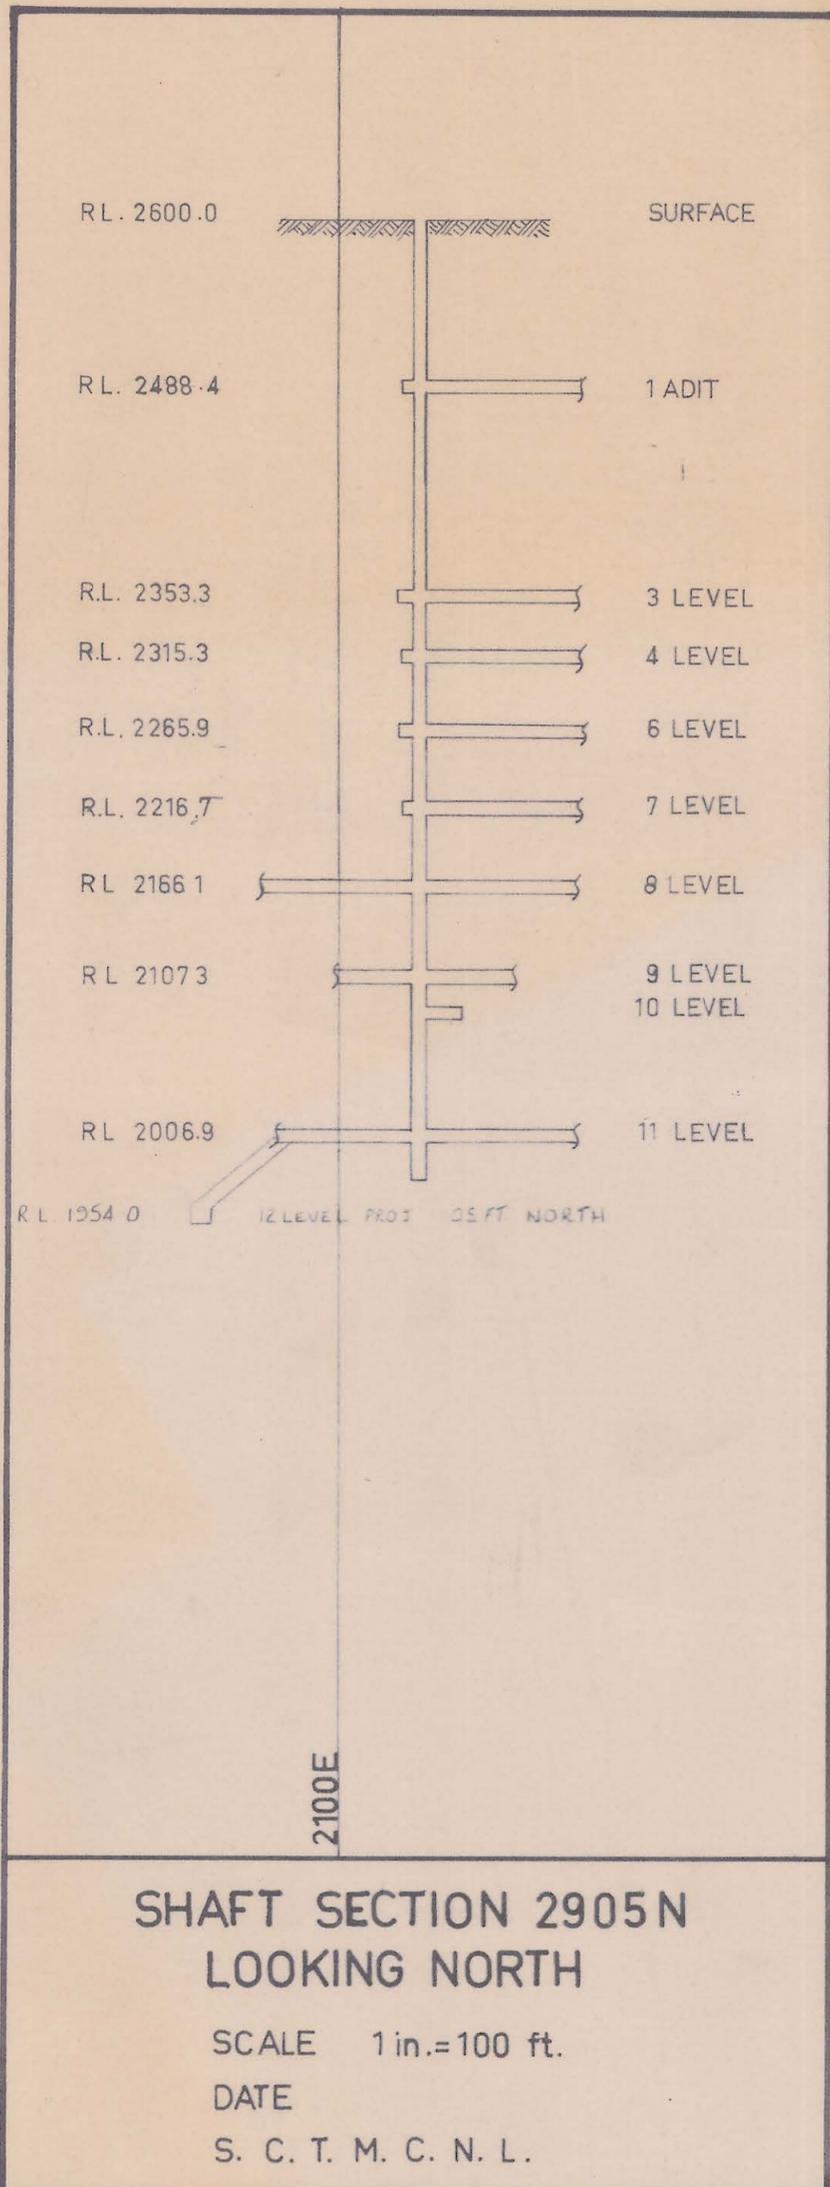

5 cm

REPRODUCED

82234