
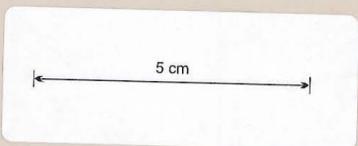
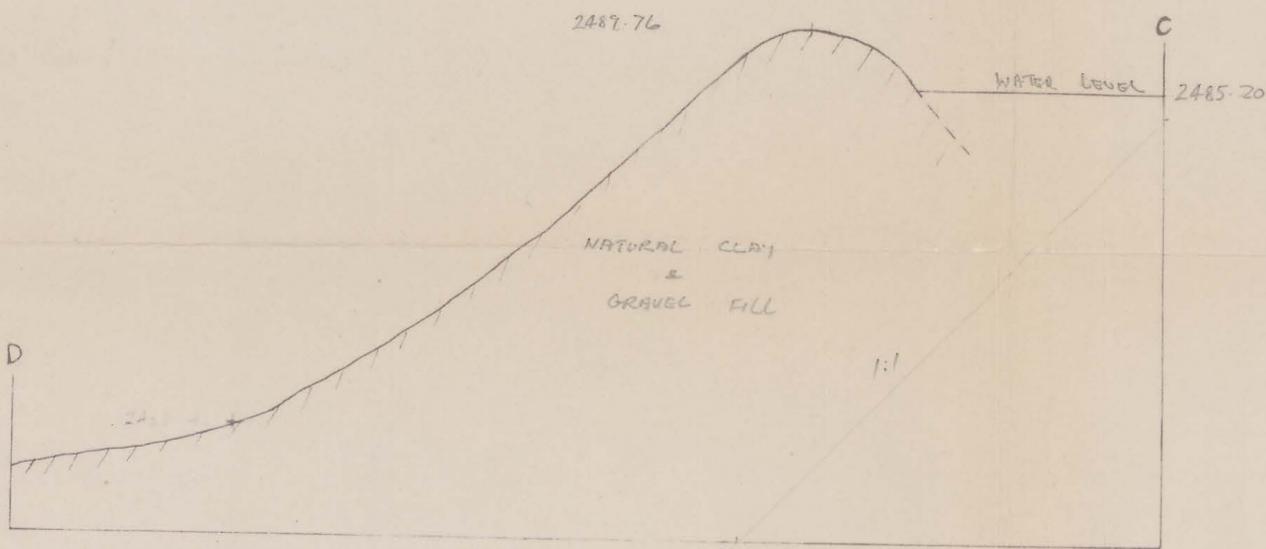



STOREYS CREEK SLIME DAM

27/8/74

FILE 500.00/1

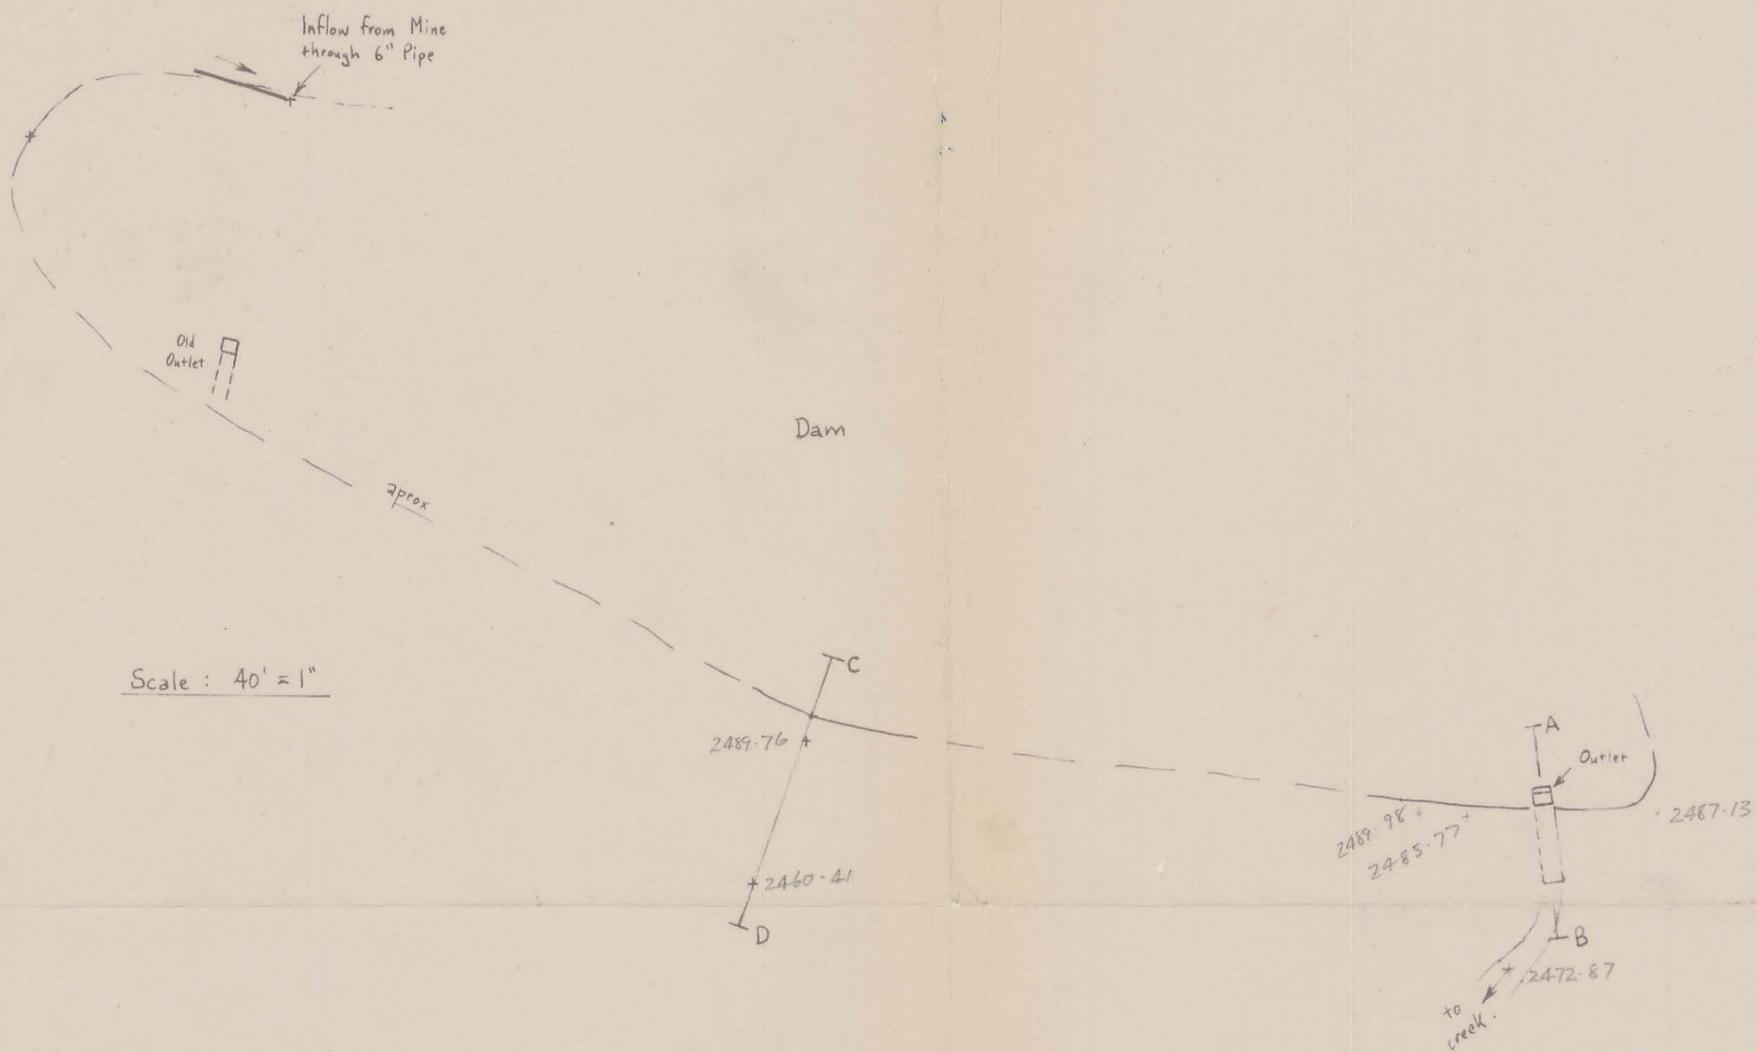

CROSS SECTIONS.
Scale: 10' = 1"

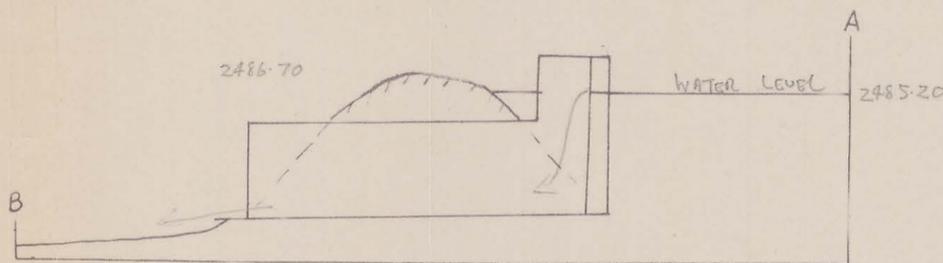

Low Dam - Approx 1'