


82/007-182-006

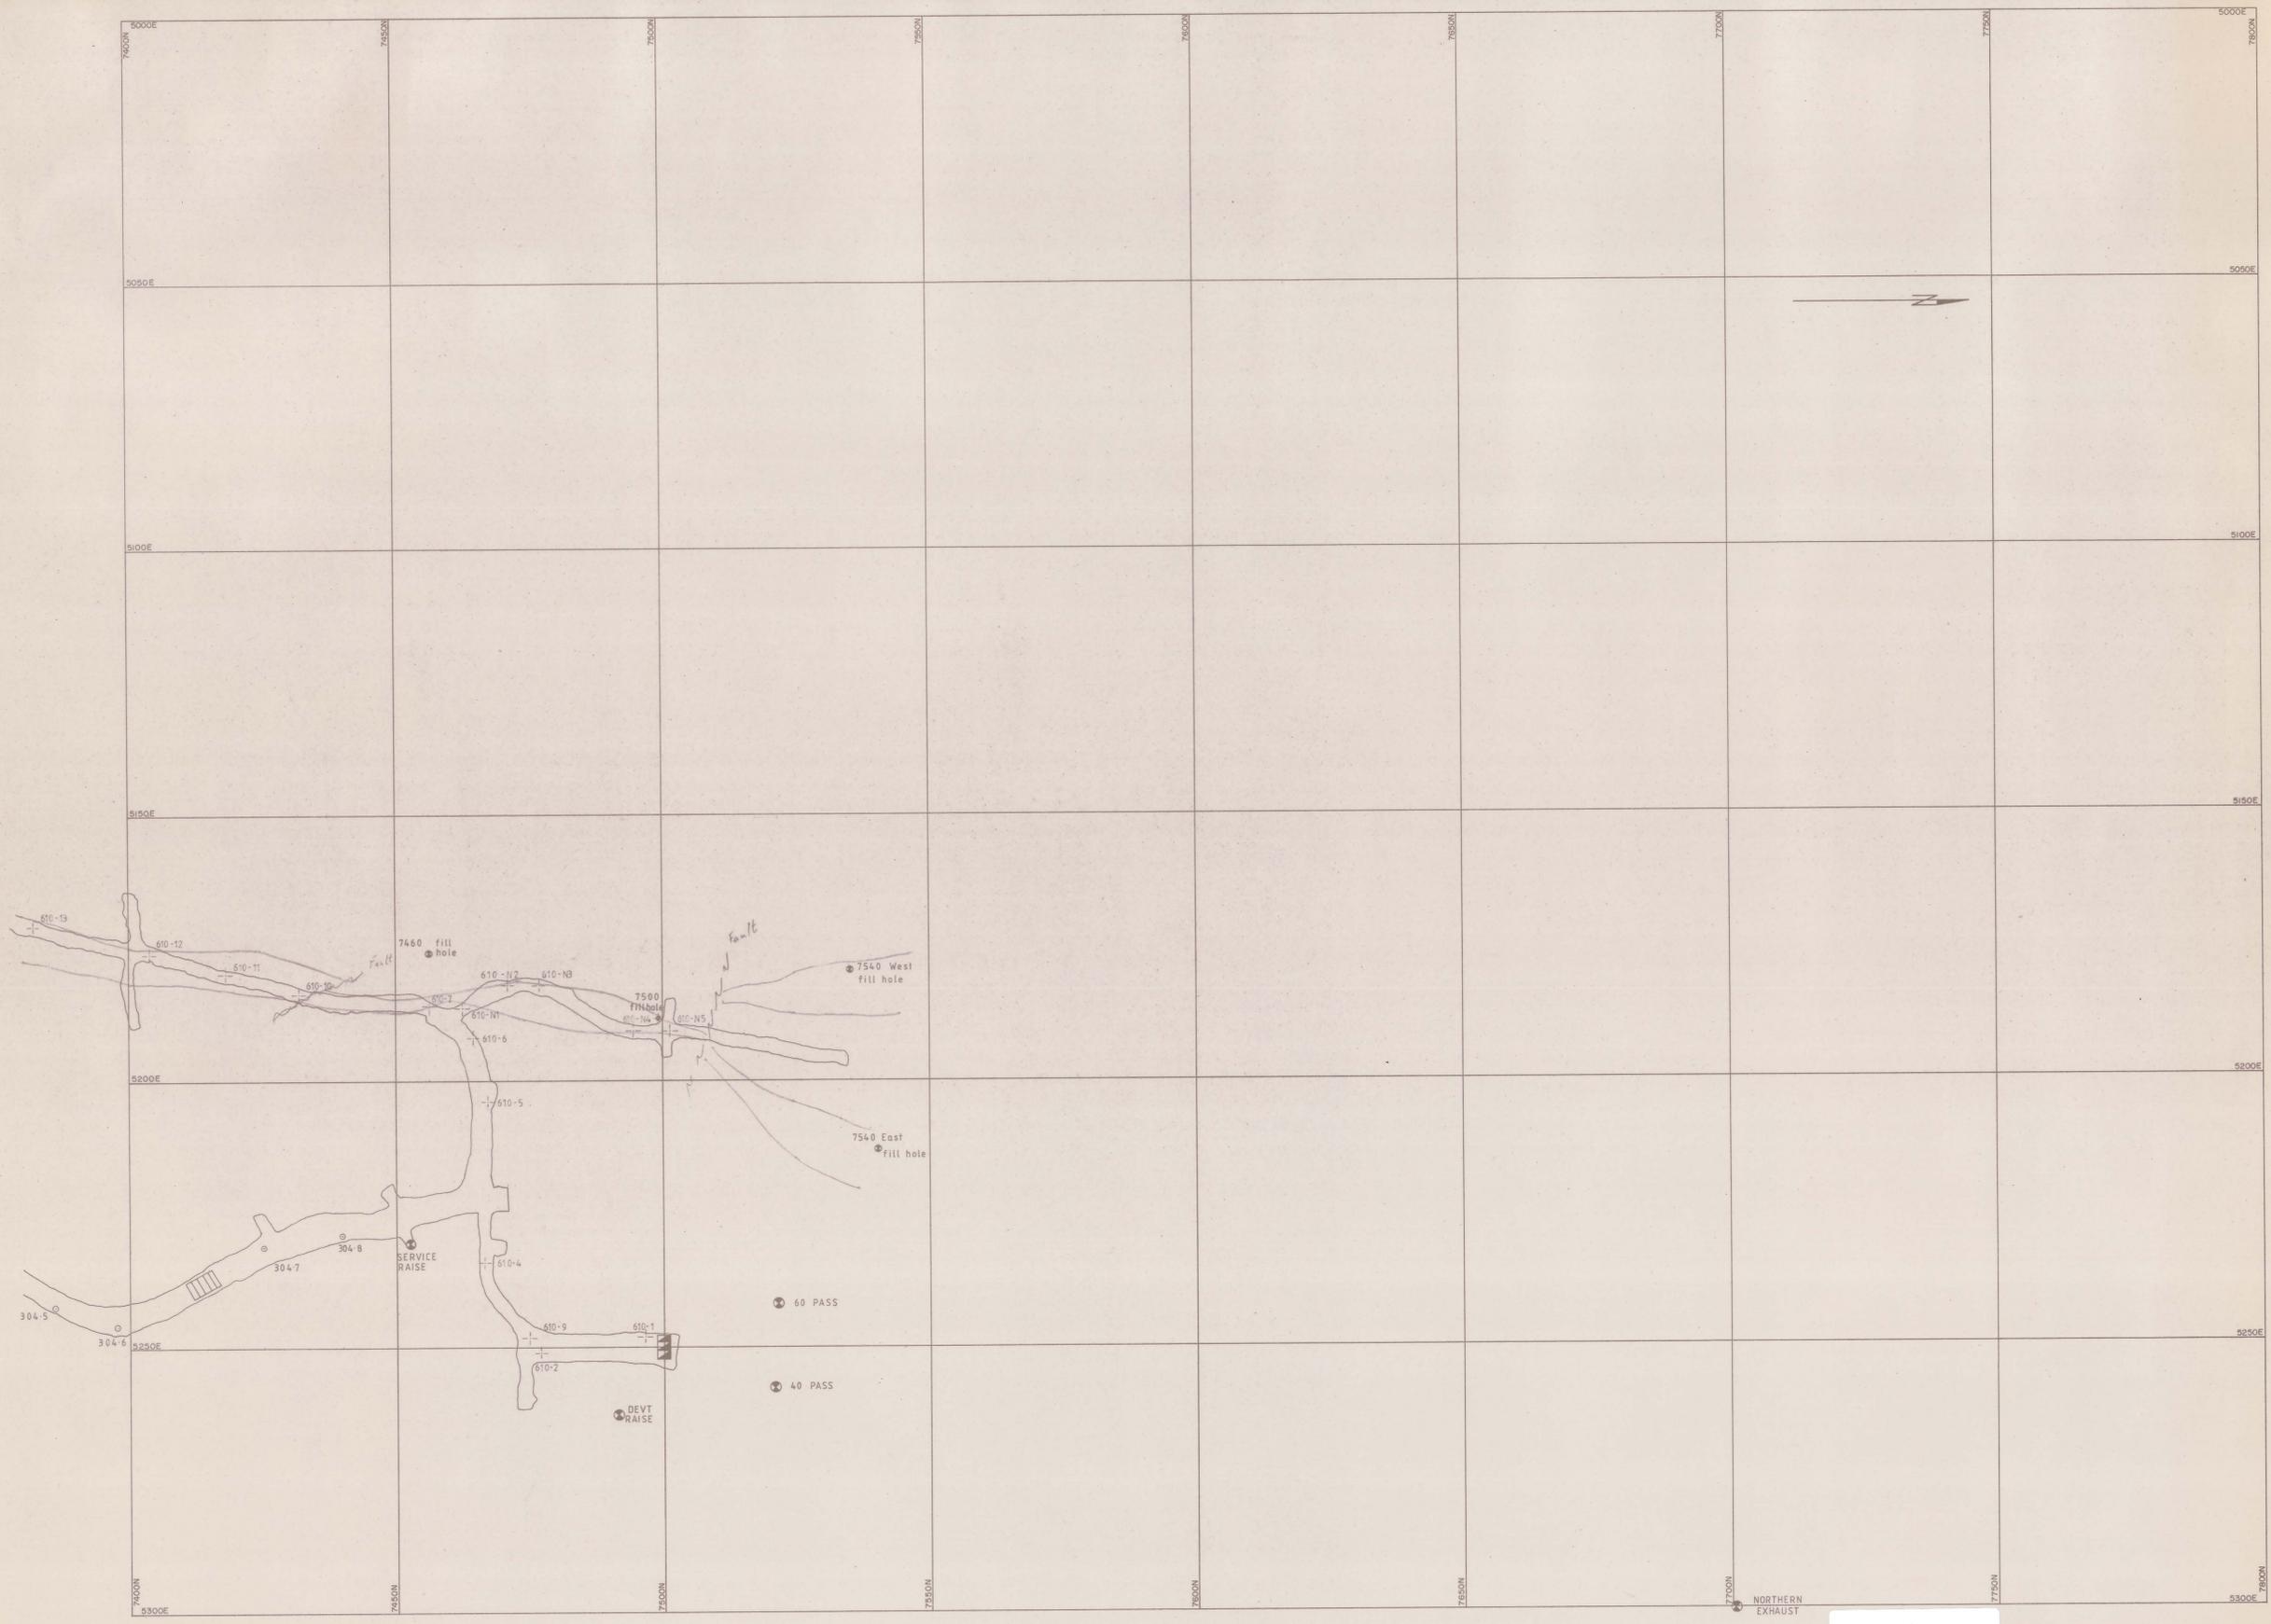

5 cm

MICROFILMED

DRAWN	J.D.D.	QUE RIVER MANAGEMENT PTY. LTD.		DRAWING No.
TRACED		3 LEVEL PLAN		3N
CHECKED	<i>[Signature]</i>	SCALE 1:500	DATE 1/1/82	REVISION
APPROVED	<i>[Signature]</i>			SHEET

82/007