


RL 5150 E
5175 E
5200 E
5225 E
5250 E

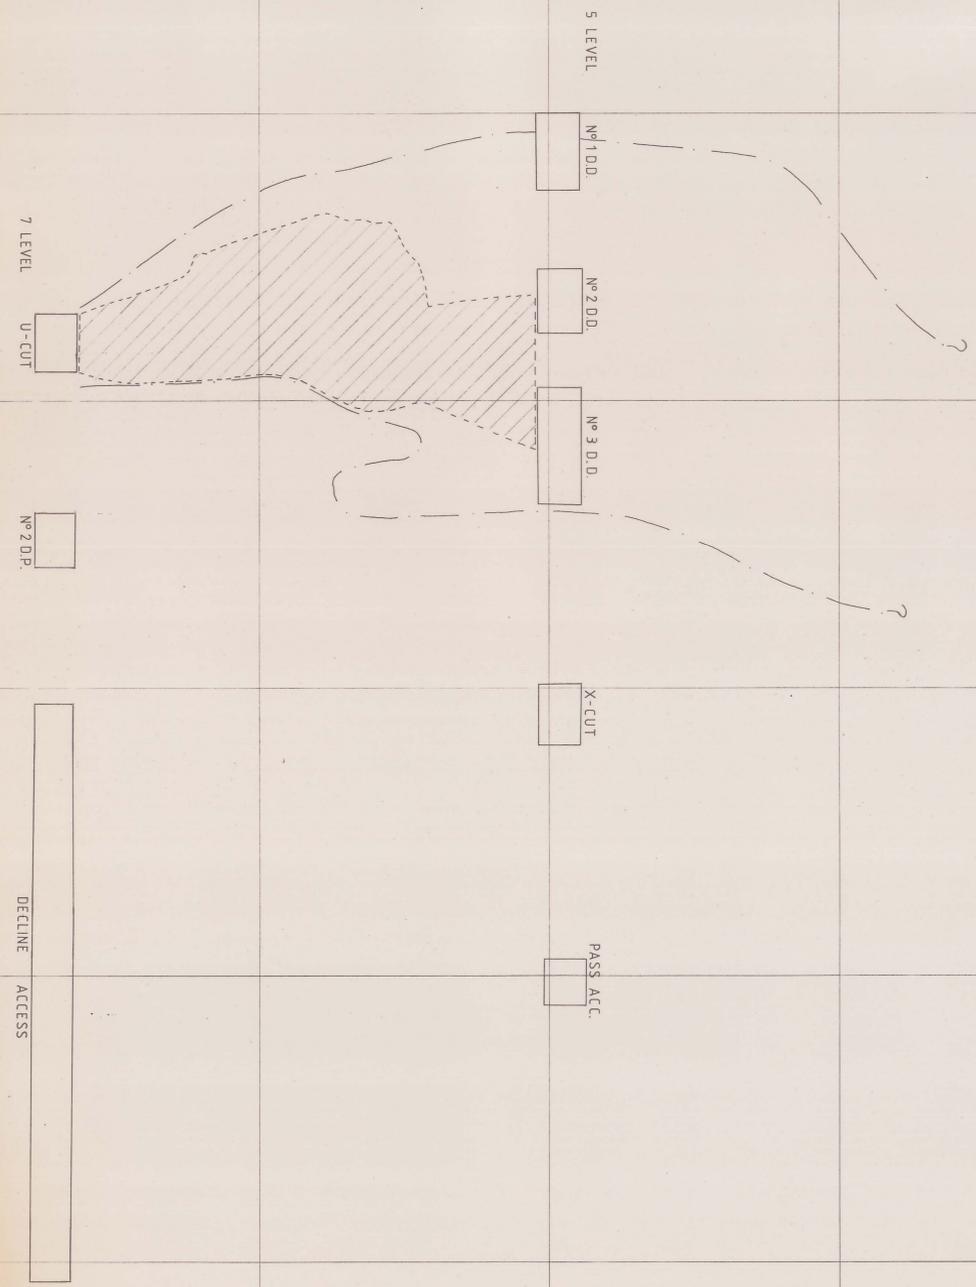

Area mined to Period 2 1982
5275 E

MICROFILMED

DRAWN	R. SQUIRES	QUE RIVER MINING PTY. LTD.	DRAWING No
TRACED		7540 X-SECTION	XS - 54
CHECKED	<i>[Signature]</i>	(LOOKING NORTH)	
APPROVED	<i>[Signature]</i>	SCALE	DATE
		1:250	12/3/82
		REVISION	SHEET

82/018

7-9 DEC

RL 475
RL 500
RL 525
RL 550
RL 575
RL 600
RL 625
RL 650