


900-1984-006

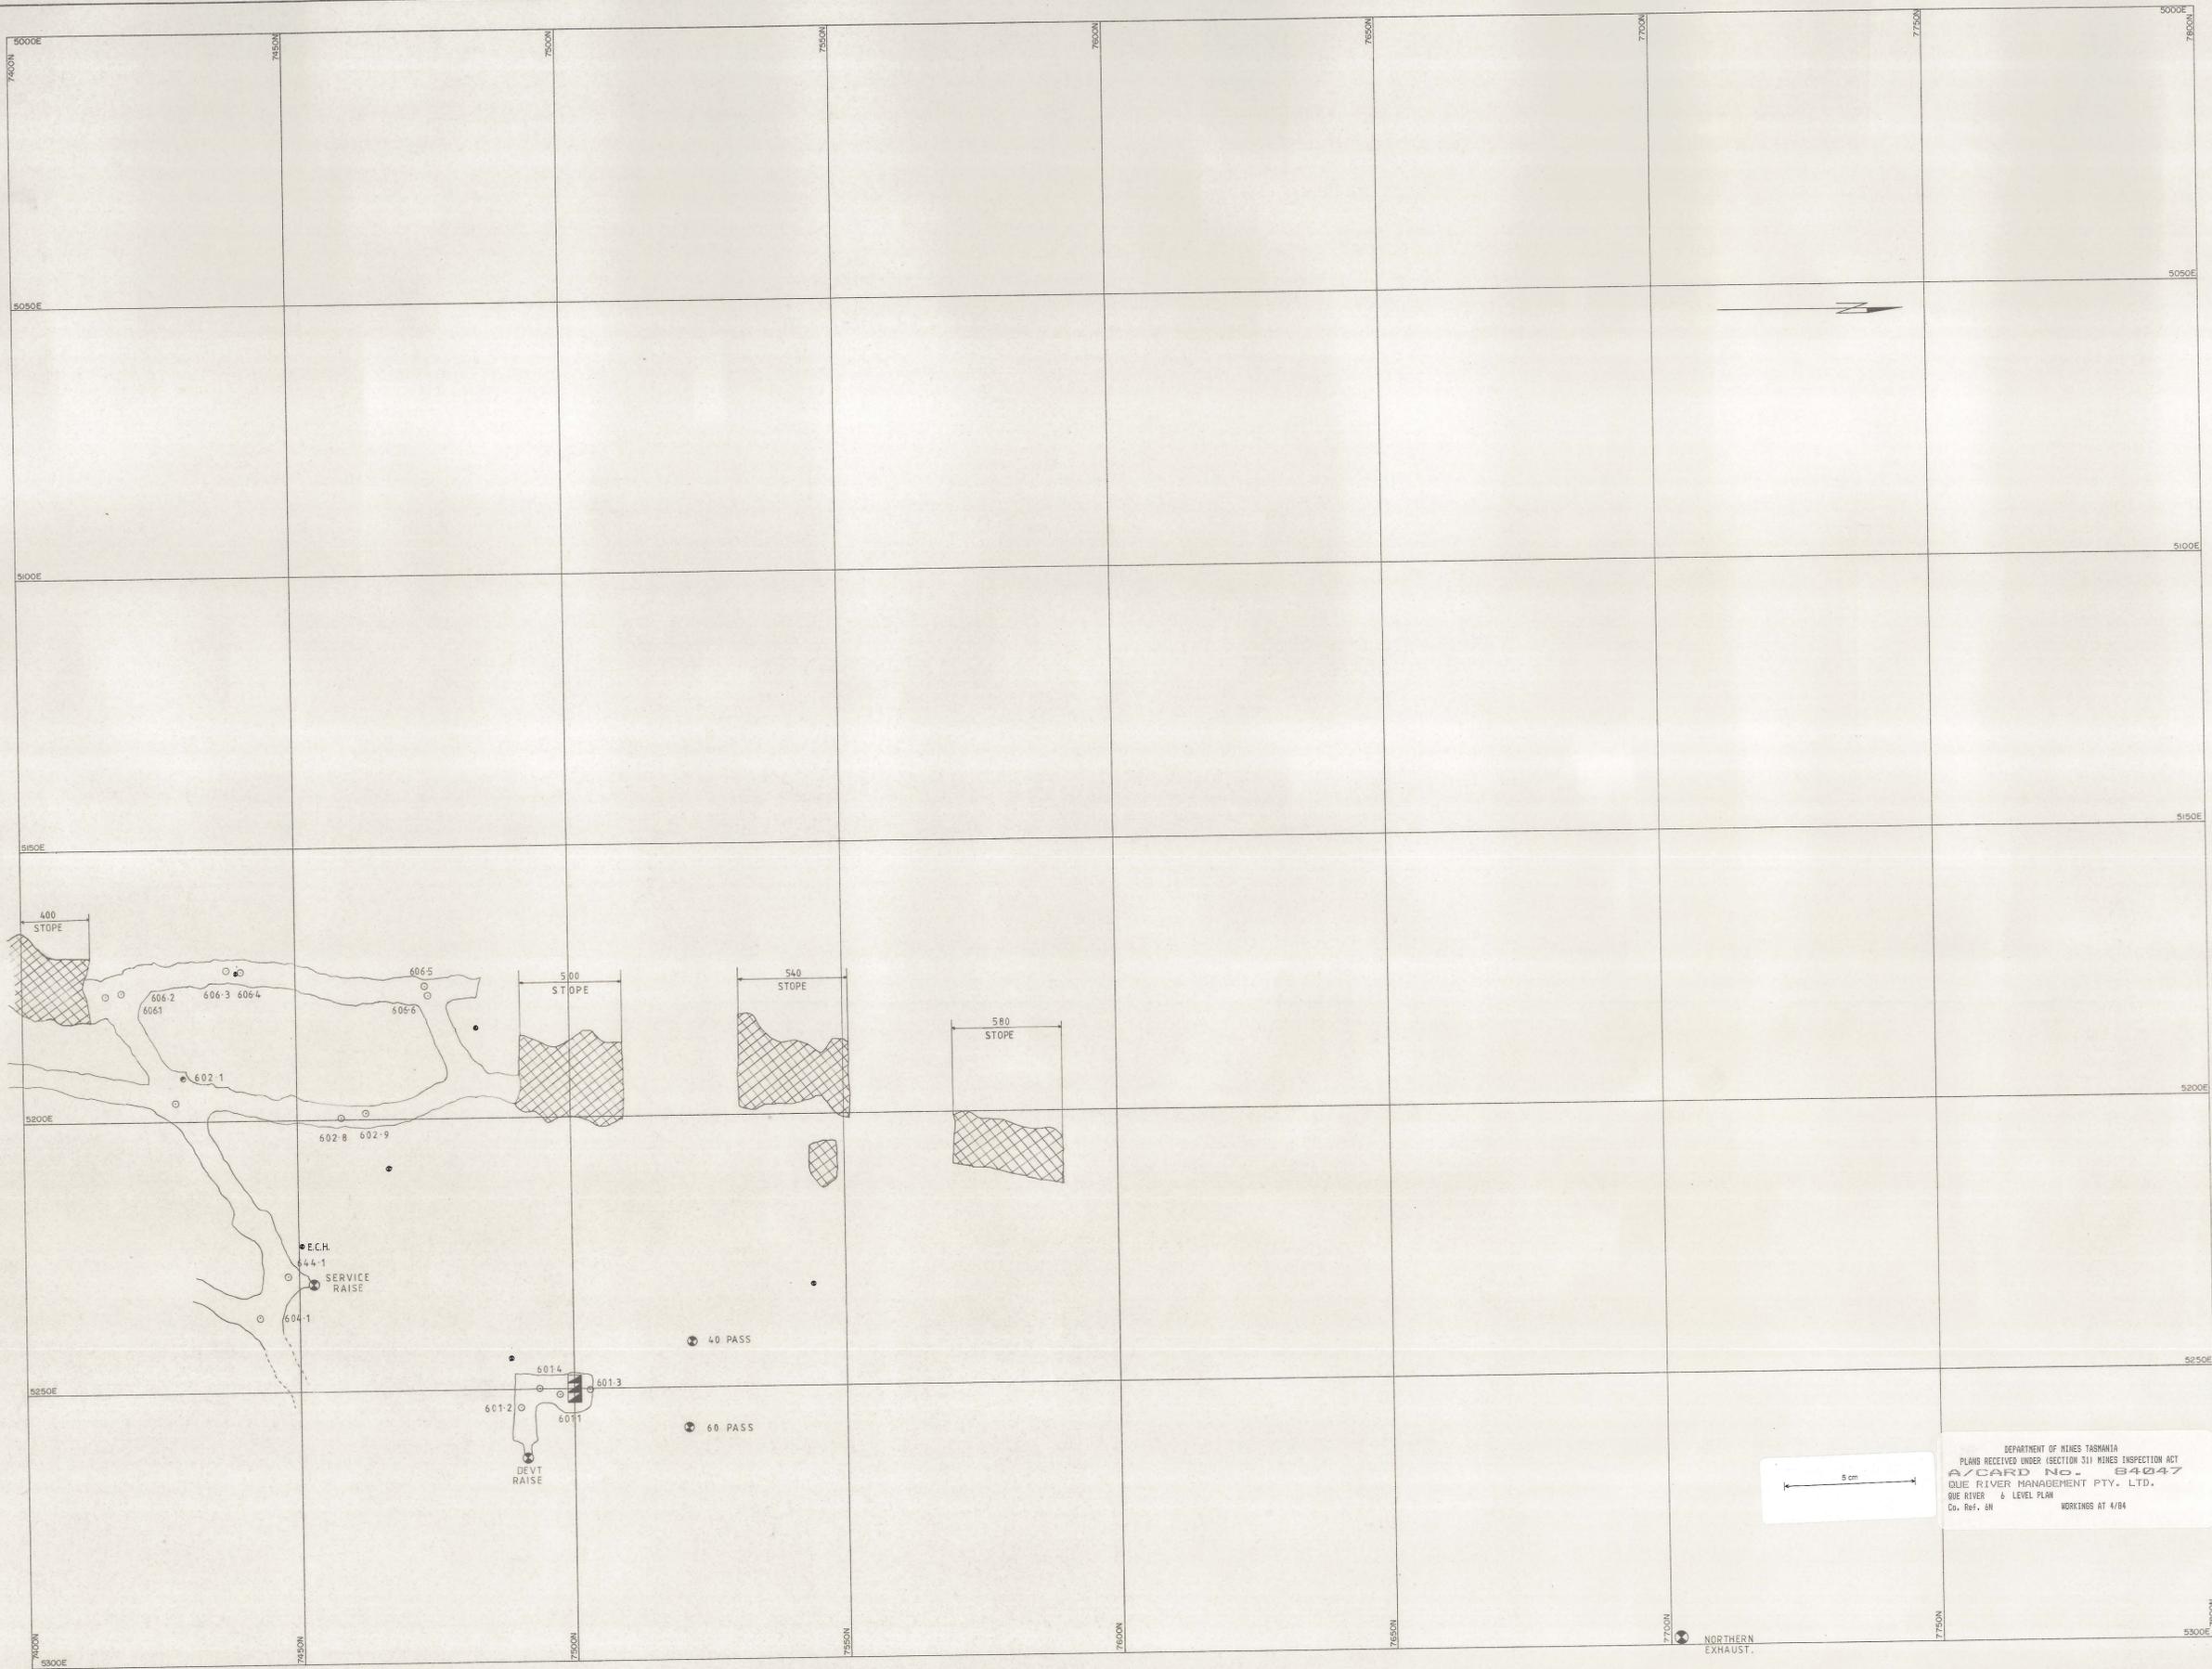

DEPARTMENT OF MINES TASMANIA  
 PLANS RECEIVED UNDER SECTION 311 MINES INSPECTION ACT  
 A/CARD No. 84047  
 QUE RIVER MANAGEMENT PTY. LTD.  
 QUE RIVER 6 LEVEL PLAN  
 Co. Ref. 6N WORKINGS AT 4/84

-  Stoping Above Level
-  Stoping Below Level
-  Stoping Above and Below Level

DRAWN		D.H.		QUE RIVER MANAGEMENT PTY. LTD.	
CHECKED		M.H.		DRAWING No.	
APPROVED		D.M.		6 LEVEL PLAN	
ADJUSTED		R.D.V. / J.S.		6 N	
NEW DATUM		22-6-81 R.S.		SCALE 1:500	
D.M.H.W.L.		27-4-1984		DATE 1/1/84	
				REVISION	
				SHEET	