


QV6-1981-020



DEPARTMENT OF MINES TASMANIA
PLANS RECEIVED UNDER SECTION 311 MINES INSPECTION ACT
EX/APP'D NO. 13-4-83-1
QUE RIVER MANAGEMENT PTY. LTD.
QUE RIVER 7550m CROSS SECTION
Co. Ref. WORKINGS AT 4/84

DRAWN	D.M.	QUE RIVER MANAGEMENT PTY. LTD. 7550mN X-SECTION	DRAWING No.
TRACED			
CHECKED	<i>[Signature]</i>		
APPROVED	<i>[Signature]</i>		
D. MINOL	27-2-1984	LOOKING NORTH	REVISION: 108
SCALE 1:500		DATE March '83	SHEET

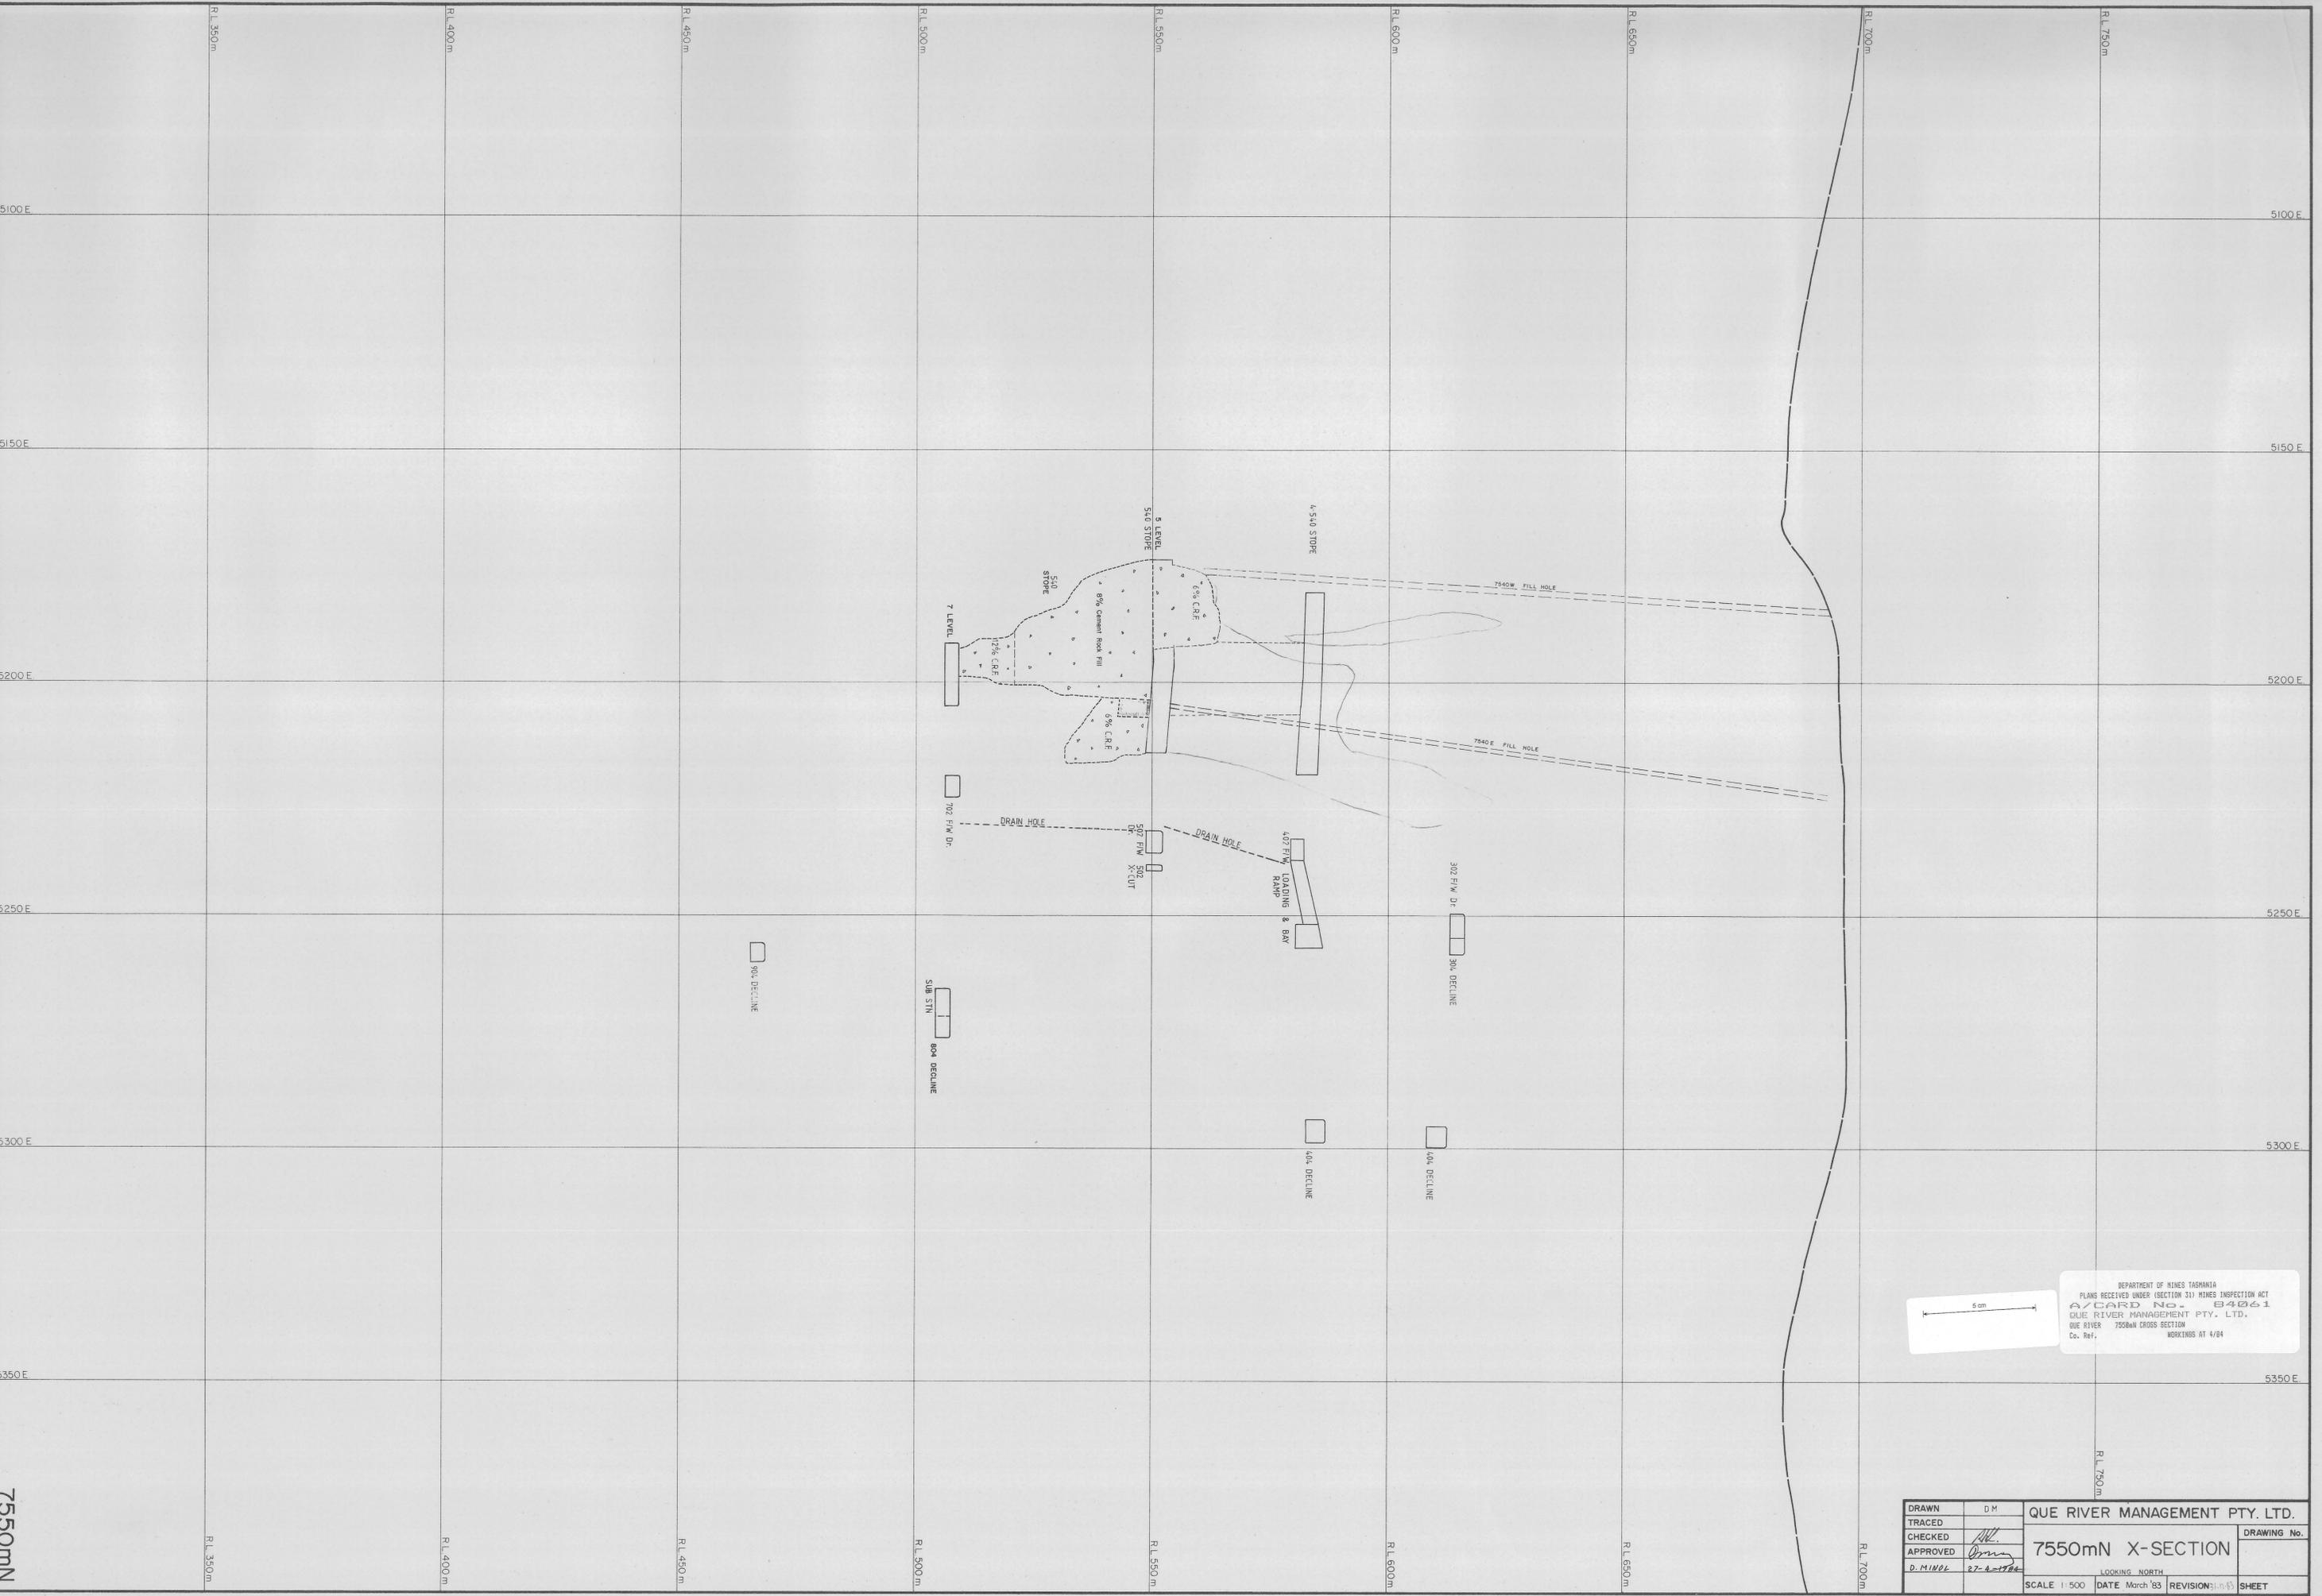

7550mN