



QV 3N - 1984-031

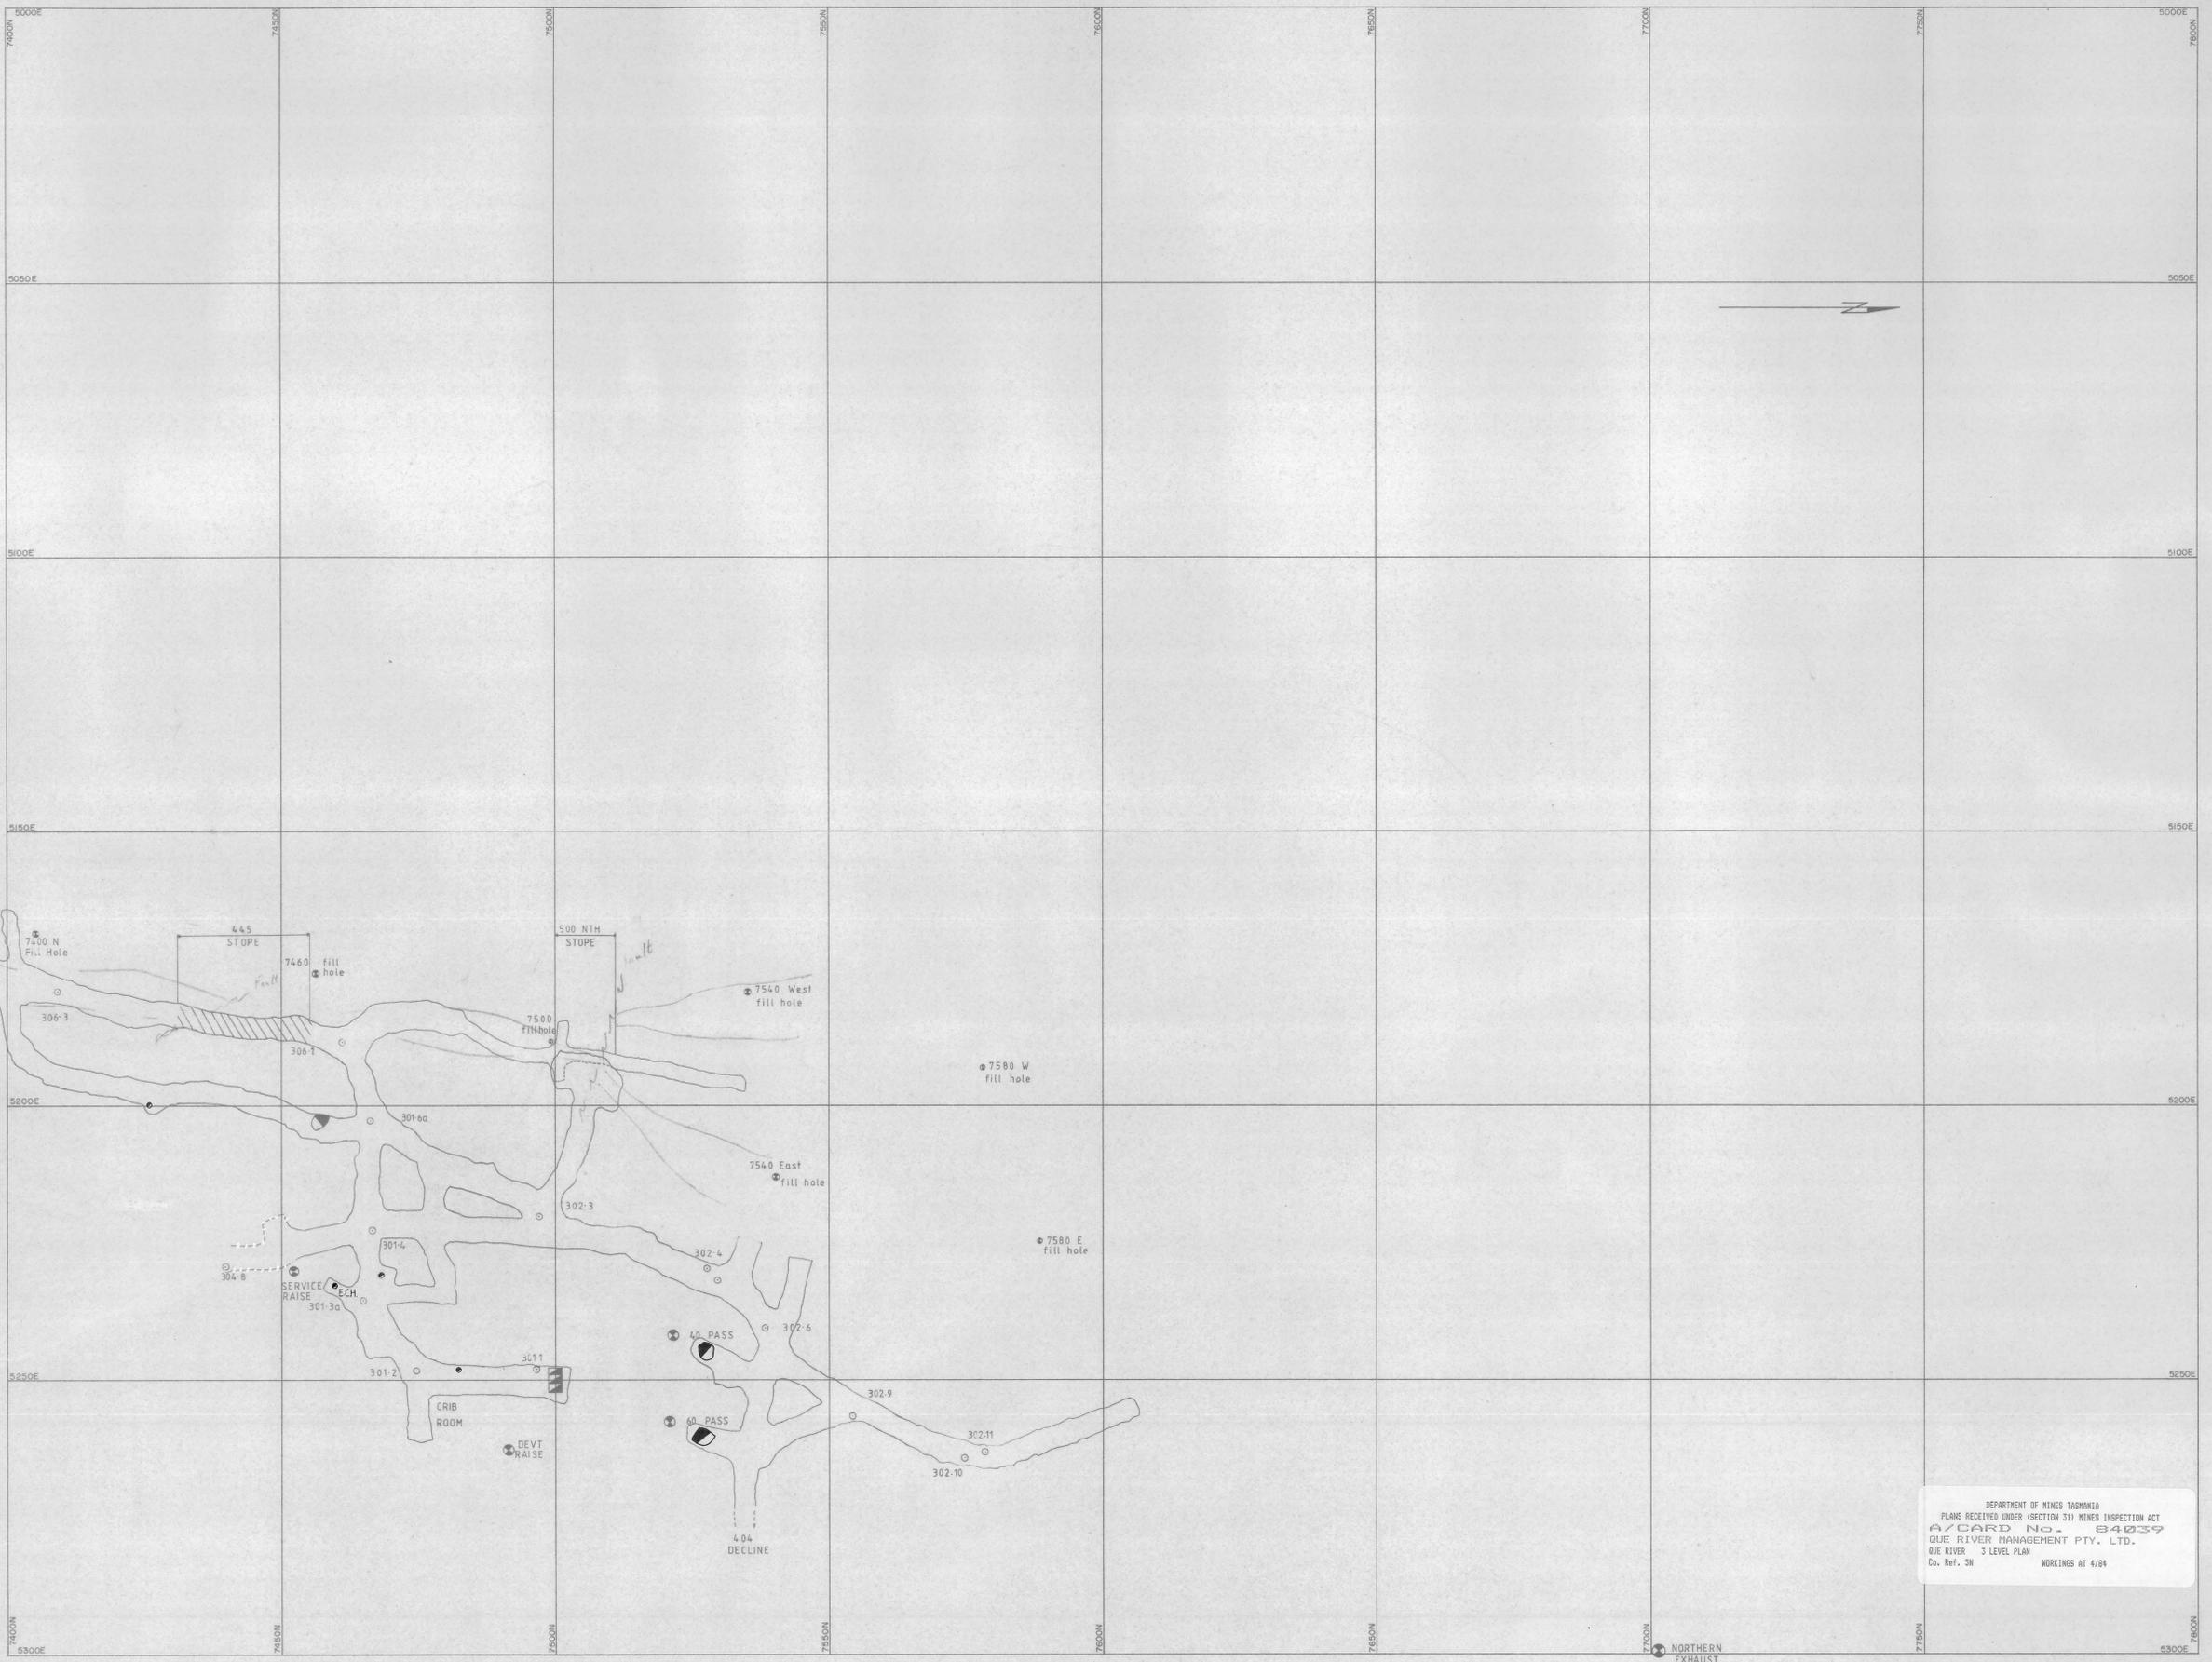

DEPARTMENT OF MINES TASMANIA  
 PLANS RECEIVED UNDER (SECTION 31) MINES INSPECTION ACT  
 17/04/84 14:45  
 QUE RIVER MANAGEMENT PTY. LTD.  
 QUE RIVER 3 LEVEL PLAN  
 Co. Ref. 3N WORKINGS AT 4/84

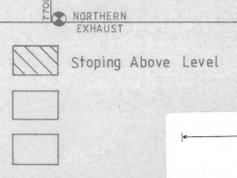

DRAWN		D. M.		QUE RIVER MANAGEMENT PTY. LTD.	
TRACED				DRAWING No.	
CHECKED				3N	
APPROVED				3 LEVEL PLAN	
NEW DATUM		22.6.82		SCALE 1:500	
D. MINOR		27-4-1984		DATE 1/1/84	
				REVISION	
				SHEET	