

PLAN OF MINERAL SURVEY

Situate in the

LAND DISTRICT OF DEVON

265 / 18

Vicinity of

NOOK


Registered Surveyor

Scale :— 1 : 2 500

Map Ref. Devon 2c

DRAWN IN OFFICE from a survey
by N.D. Lester — July 1977.

Part of Lot 6741
H. Cooper Pur.

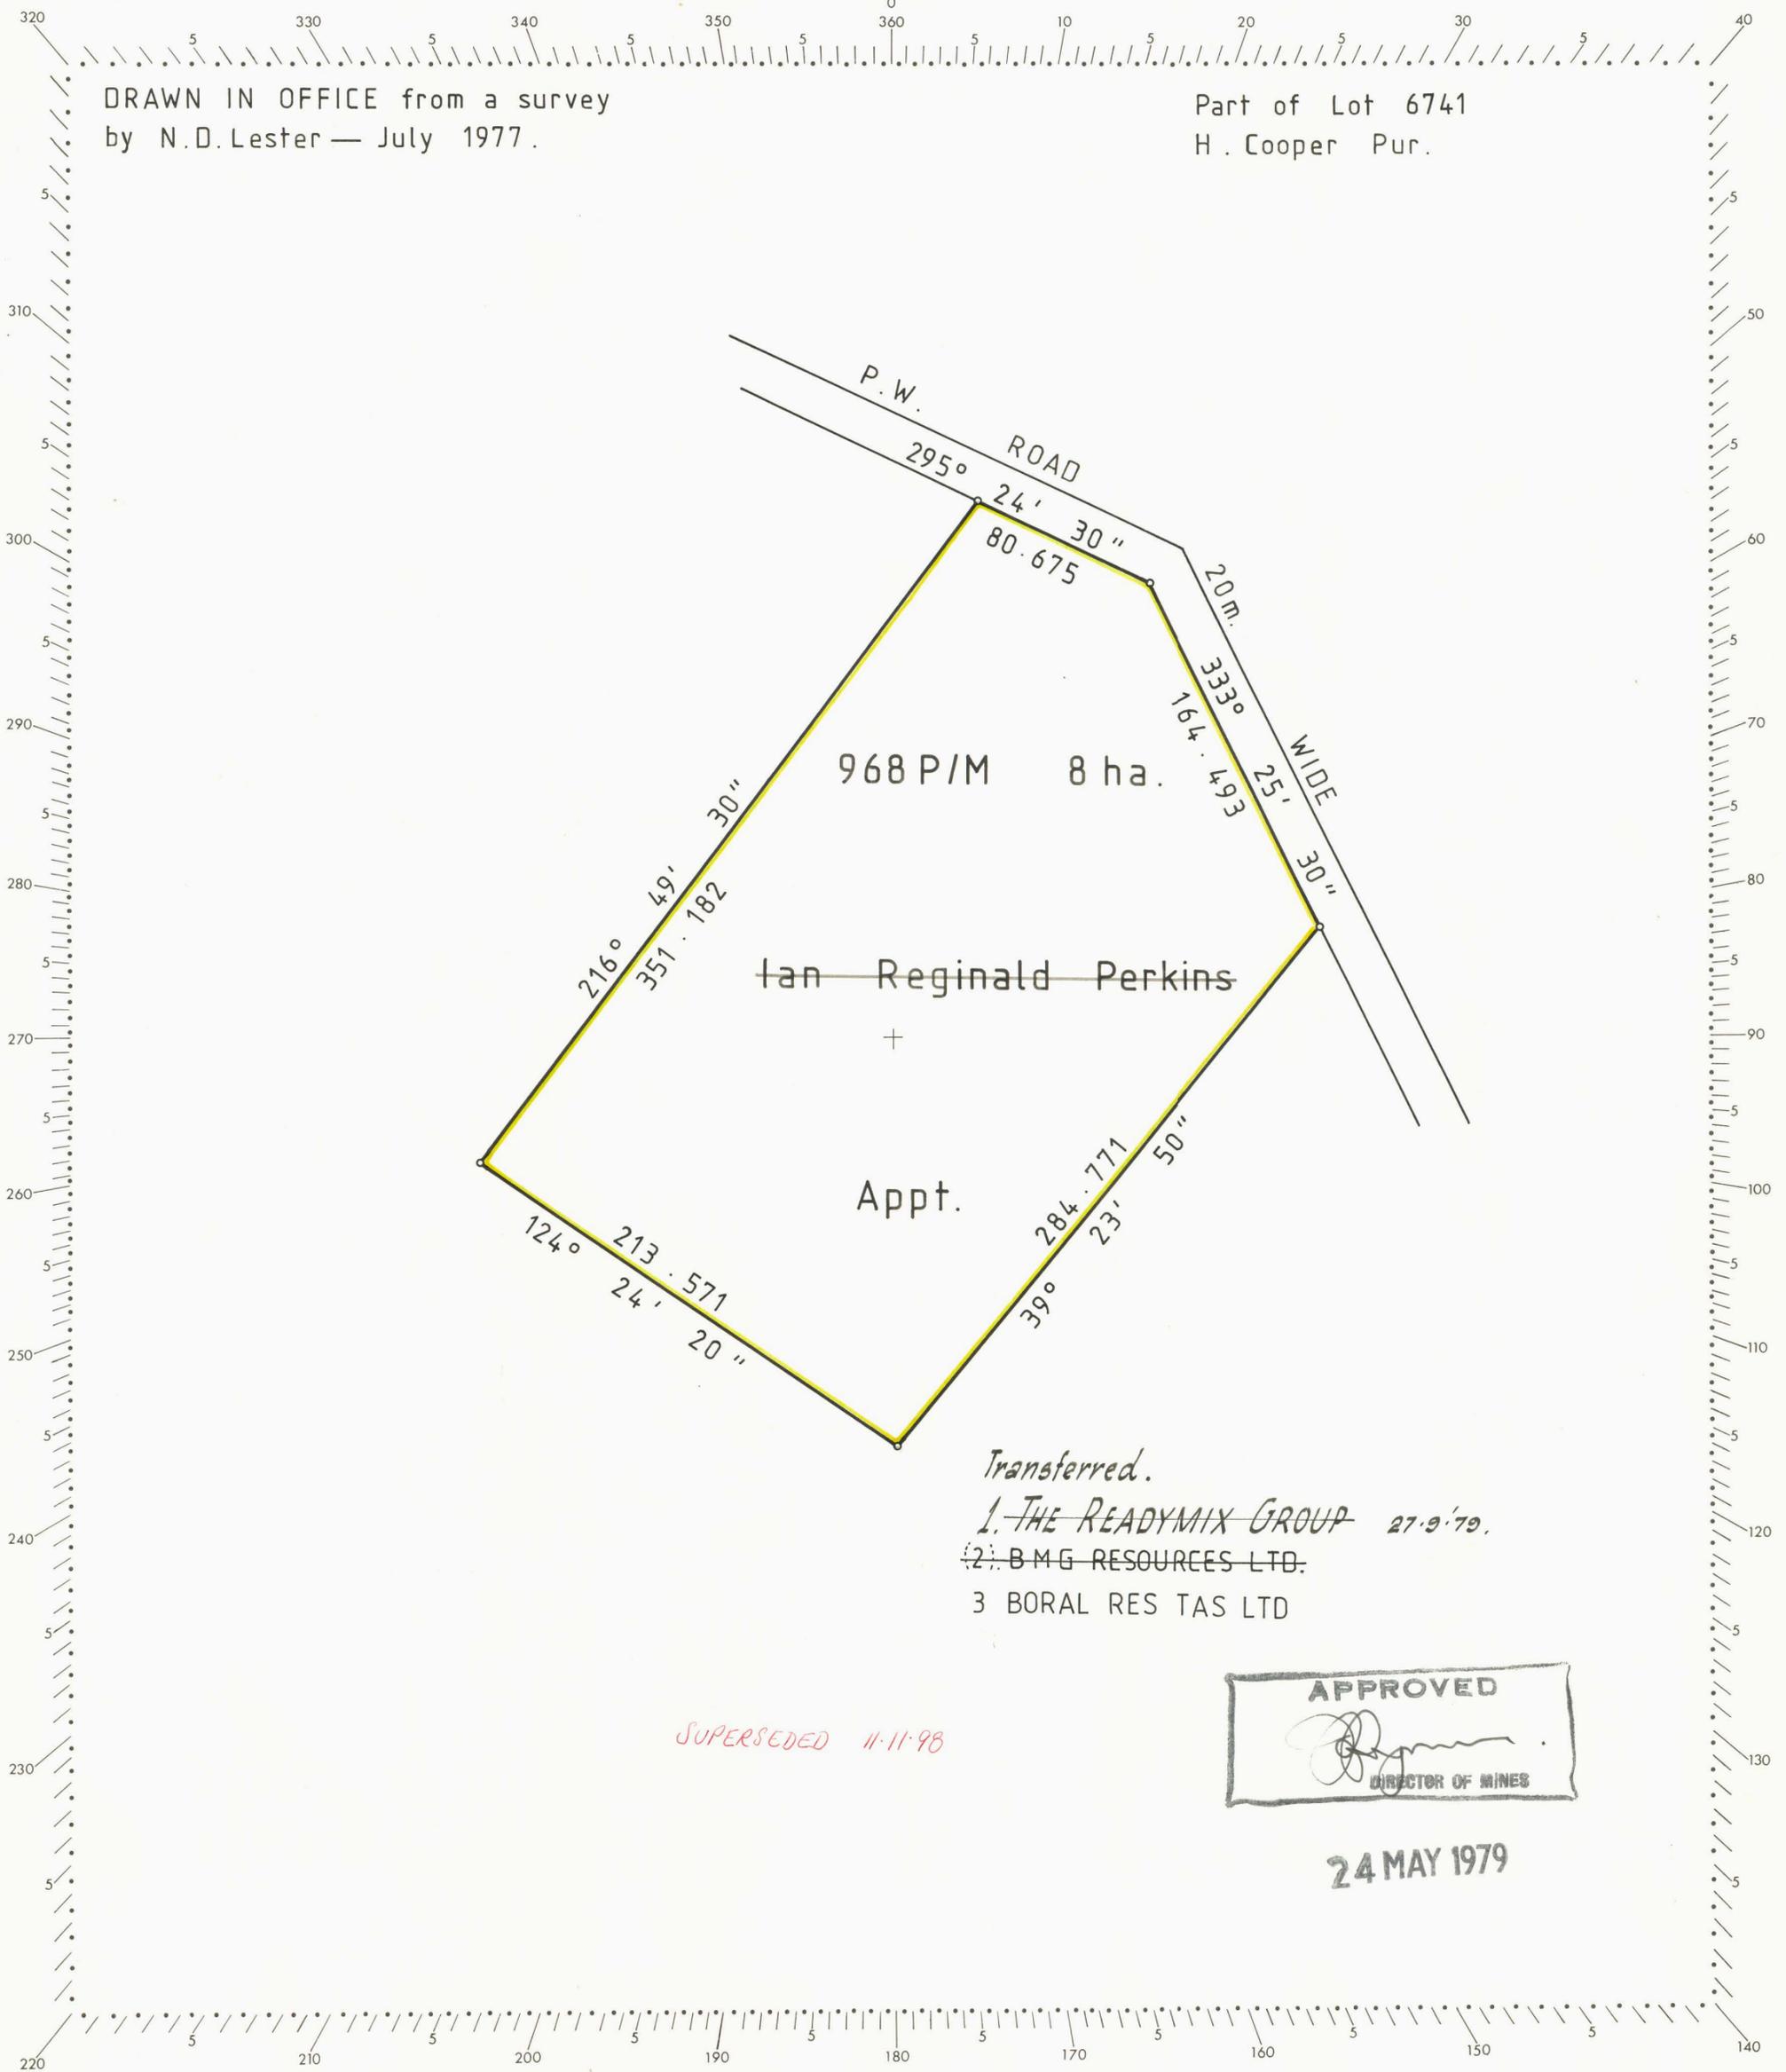

Transferred.

- ~~1. THE READYMIX GROUP 27.9.79.~~
- ~~2. B.M.G. RESOURCES LTD.~~
- 3 BORAL RES TAS LTD


SUPERSEDED 11.11.98

APPROVED
[Signature]
DIRECTOR OF MINES

24 MAY 1979



PLAN OF SURVEY

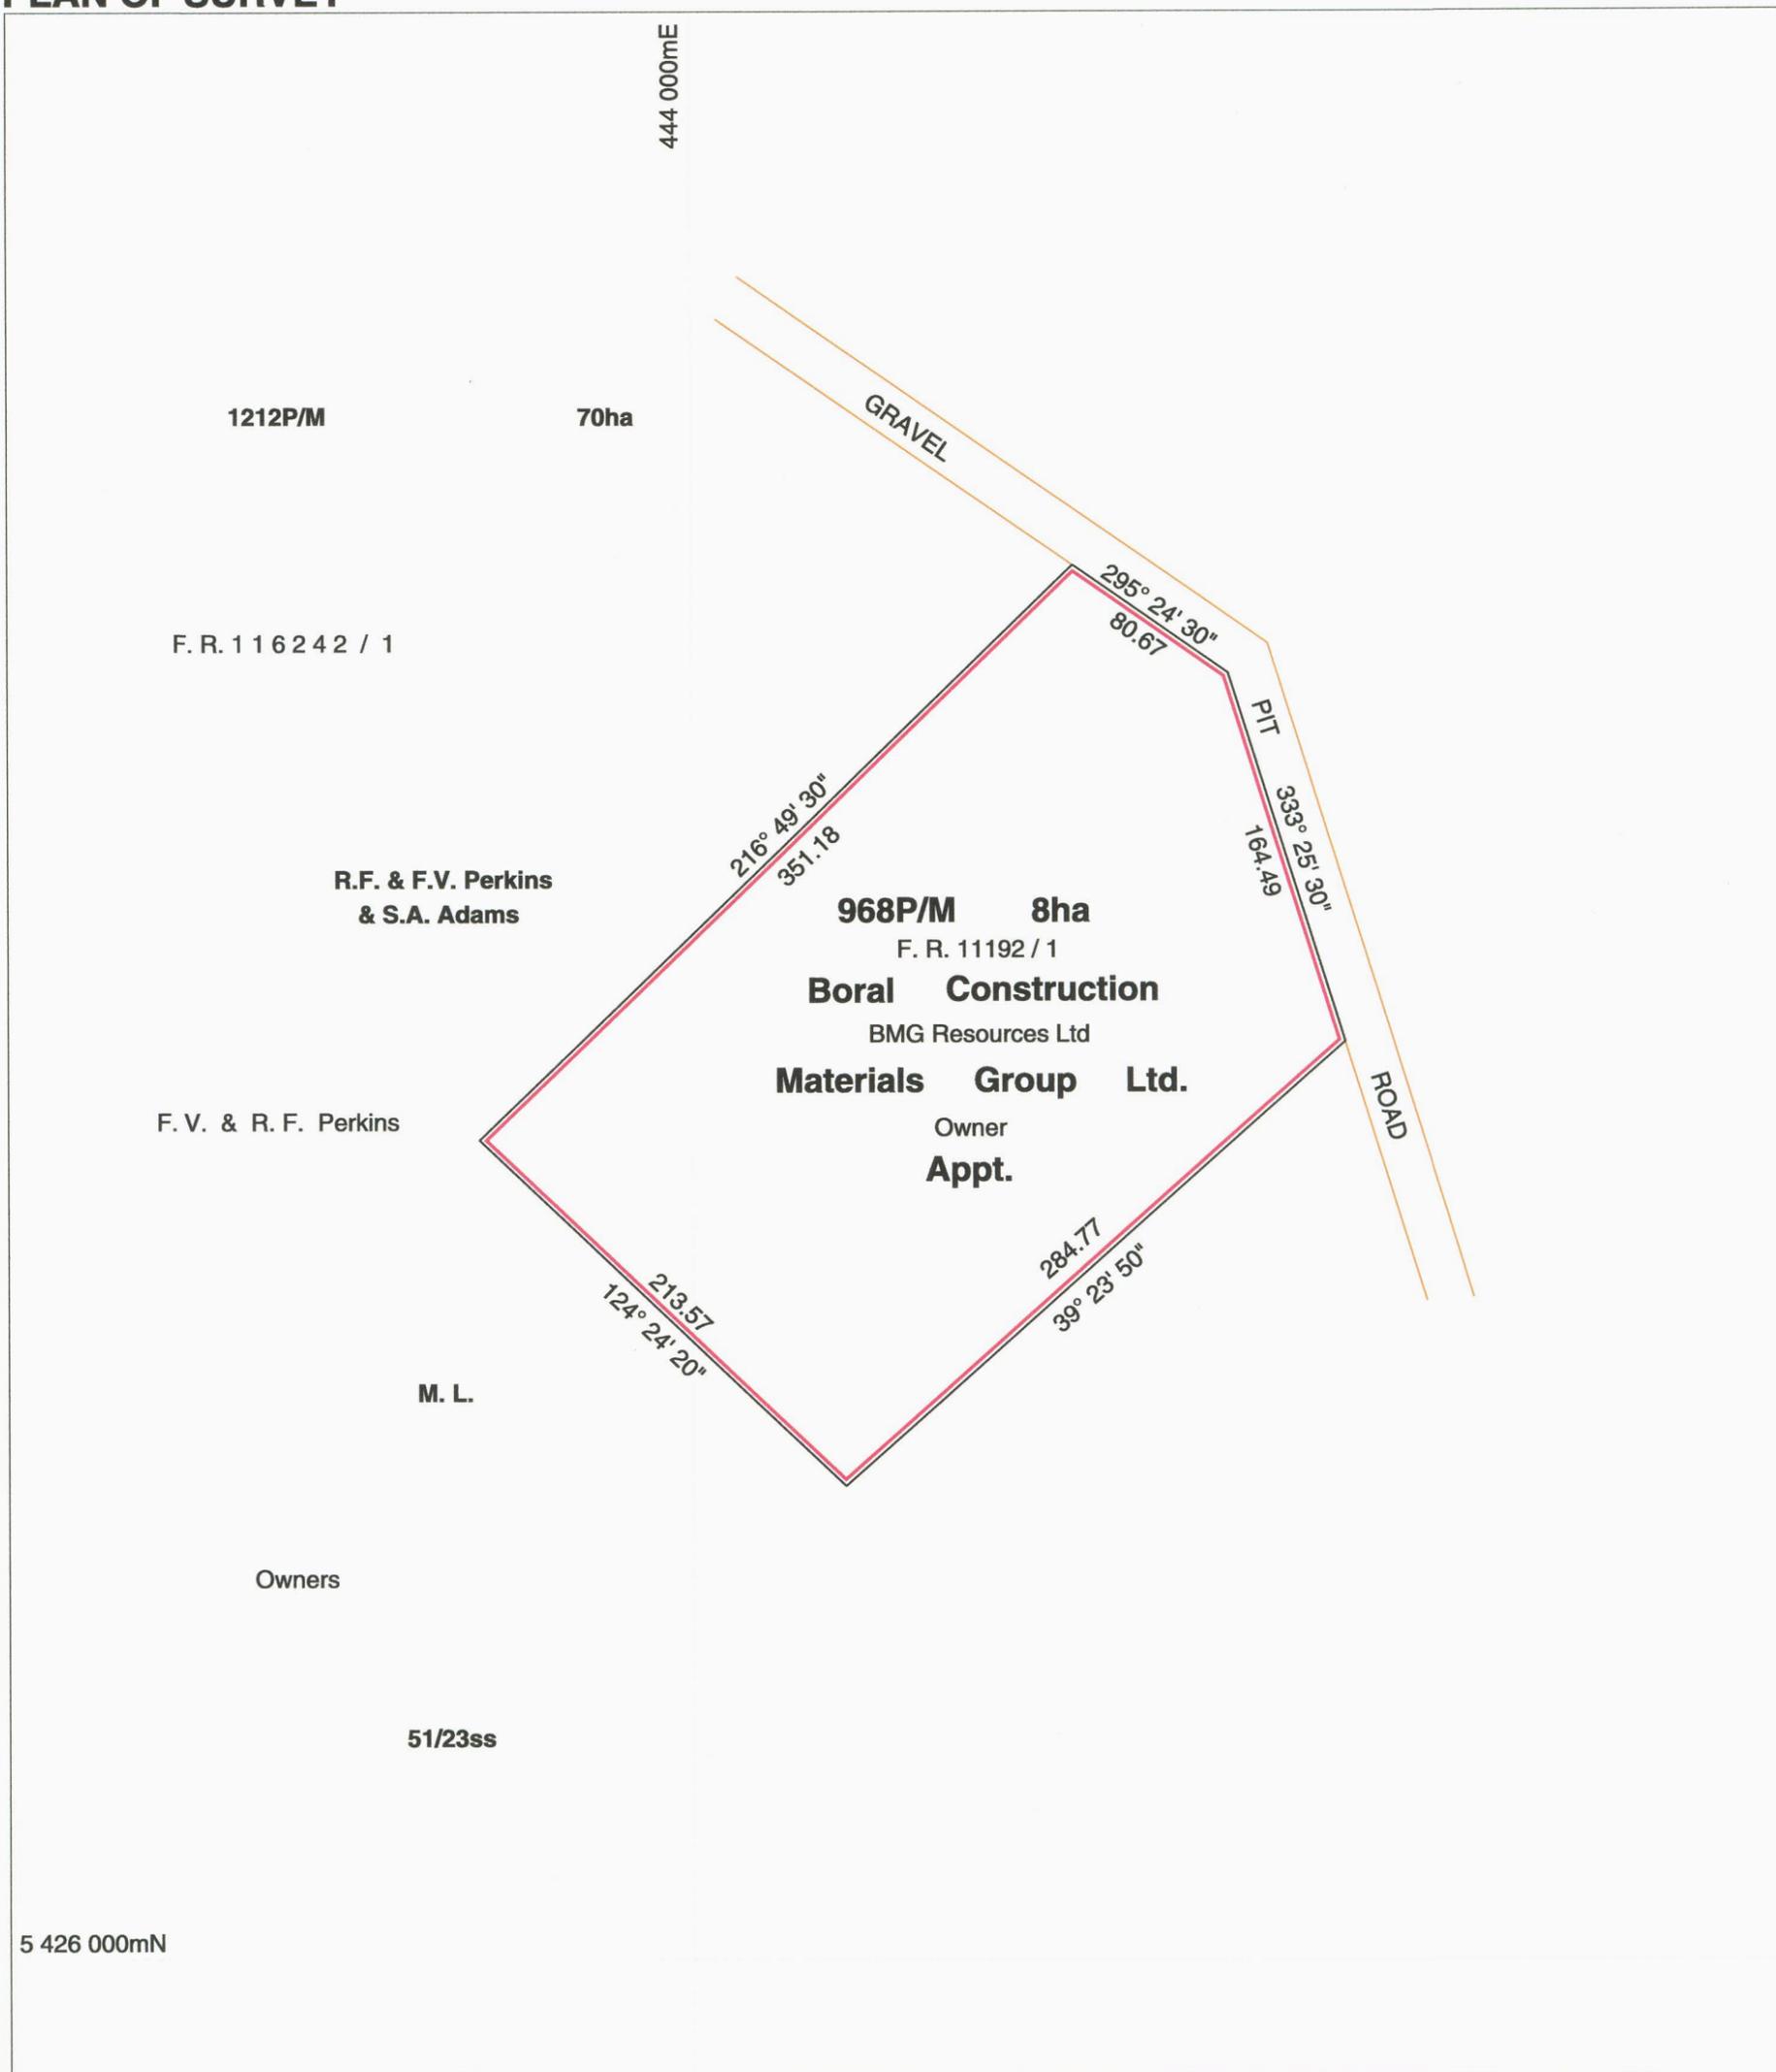


5 426 000mN

Coordinate datum - GDA94 MGA Zone 55

| | | | | | |
|-------------------|--------------------|----------|-----------------|----------|-------------------------------------|
| LAND DISTRICT | DEVON | VICINITY | NOOK | | |
| MUNICIPALITY | KENTISH | MAP | RAILTON 1:25000 | SCALE | 1 : 3000 |
| DRAWN | J.Meares | DATE | 16/12/2008 | EXAMINED | <i>A. Halliwell</i> DATE 18/12/2008 |
| COMPILED FROM: | SP 11192 LTO | | | Vol. | Folio |
| DIRECTOR OF MINES | <i>[Signature]</i> | DATE | 18 - 12 - 2008 | 265 | 18 |

PLAN OF SURVEY

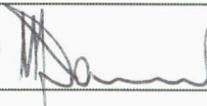

| | | | |
|---|--|---|------|
| LAND DISTRICT DEVON | VICINITY NOOK | MINERAL RESOURCES TASMANIA  Tasmania | |
| MUNICIPALITY KENTISH | MAP RAILTON 1:25000 | | |
| SCALE 1:3000 | | | |
| DRAWN A. Ploughman DATE 14/10/1998 | EXAMINED  DATE 5. 7. 2001 | | |
| COMPILED FROM: SP 11192 LTO | | | |
| APPROVED | DIRECTOR OF MINES | | DATE |
| MINERAL RESOURCES TASMANIA - DATA MANAGEMENT GROUP | | | |

MINERAL RESOURCES
TASMANIA


Tasmania

Vol. 265 Folio 18

