Tarleton Coal Mine. Tarleton.

No 2 Pit.

Scale 1" = 40'.

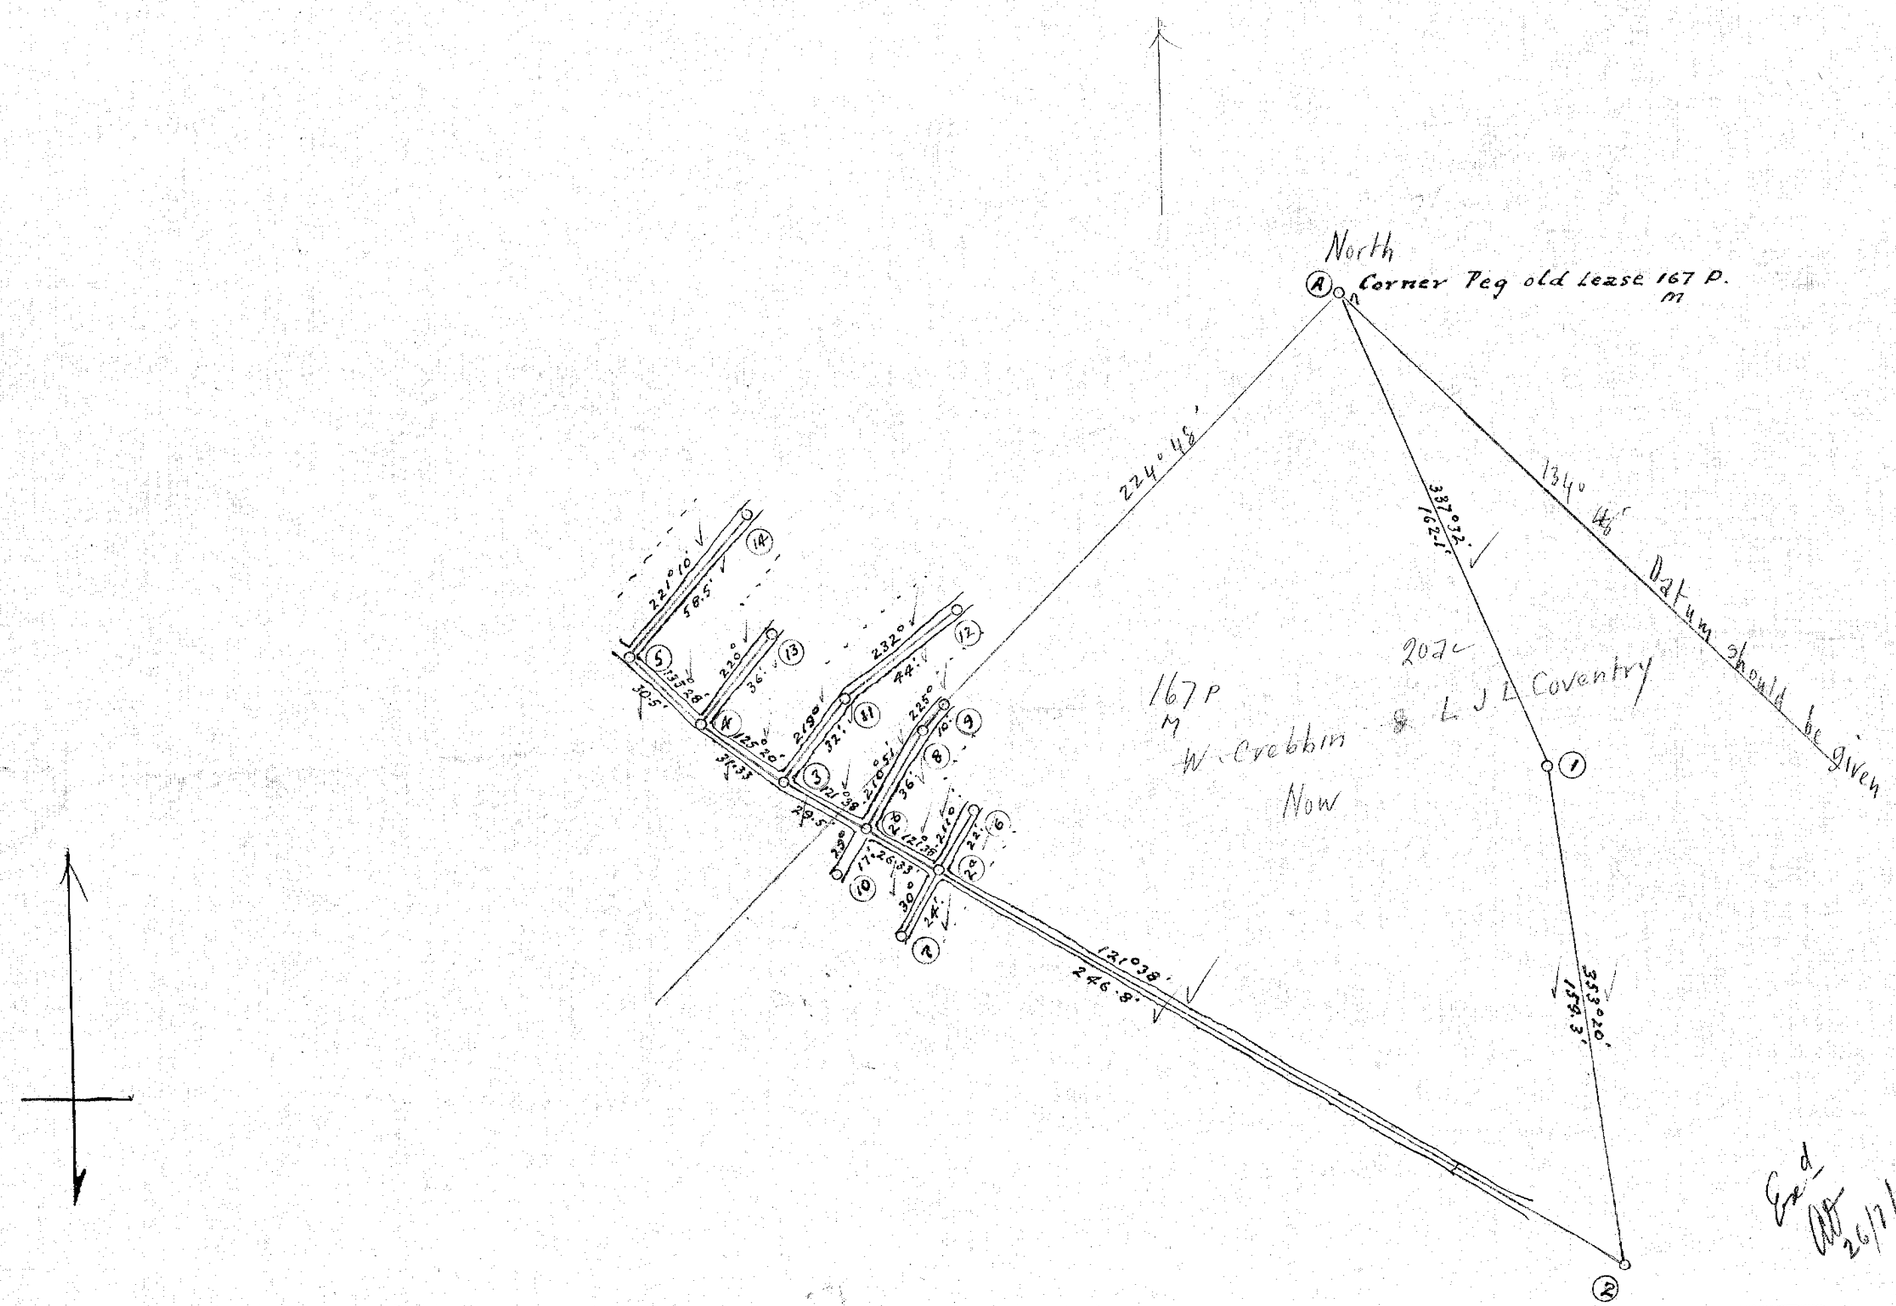

Ex'd
AP 26/7/40

To Nov 1939
A Vaudeau

01-01

5 cm