167 P
M

W. Crebbin & L.J.L Coventry 25/39

# TARLETON COAL MINE.

## TARLETON.

## COUNTY OF DEVON.

Scale 40' to 1".

5" Transit & 4" Compass Used.

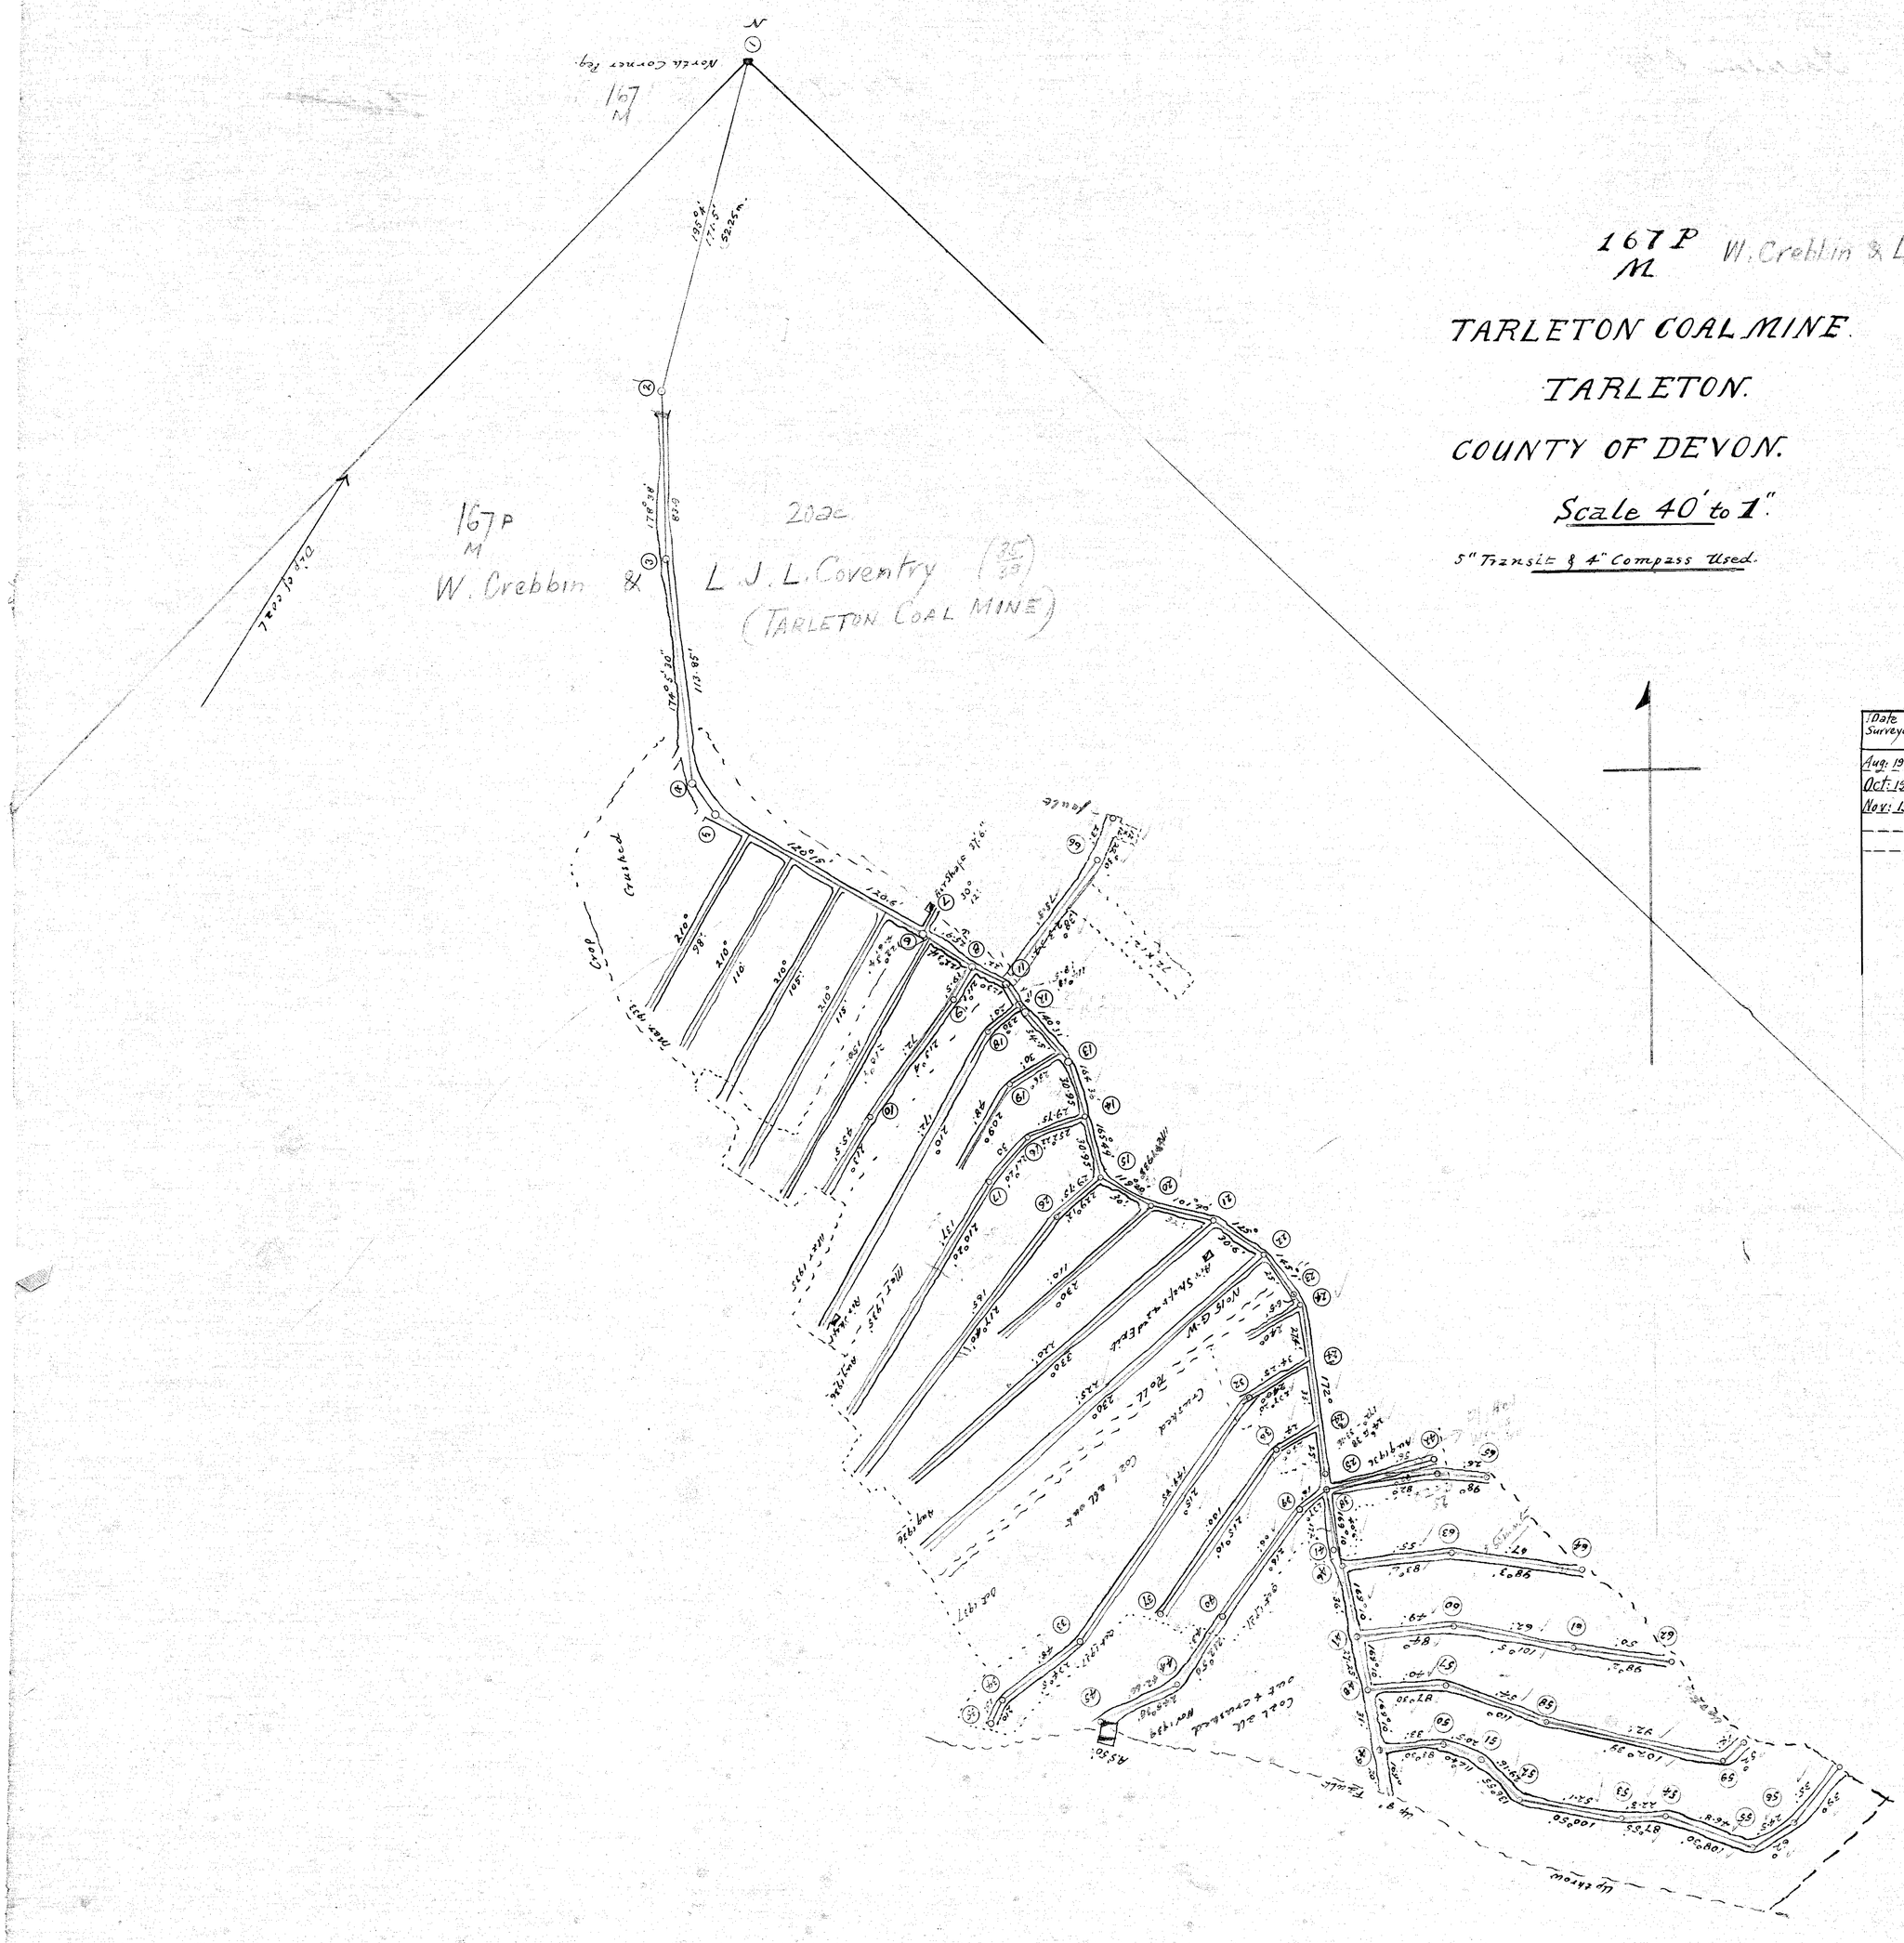


| Date Surveyed | Office Examination |
|---|---|
| Aug: 1936 | 11. 2. 1937 |
| Oct: 1937 | 28. 3. 1938 |
| Nov: 1939 | 24. 7. 1942 |
| | |
| | |

Appd up to Oct 1937
Tandeman
Upper Thurnie
Nov 1939
Appd

1-02