



5 cm

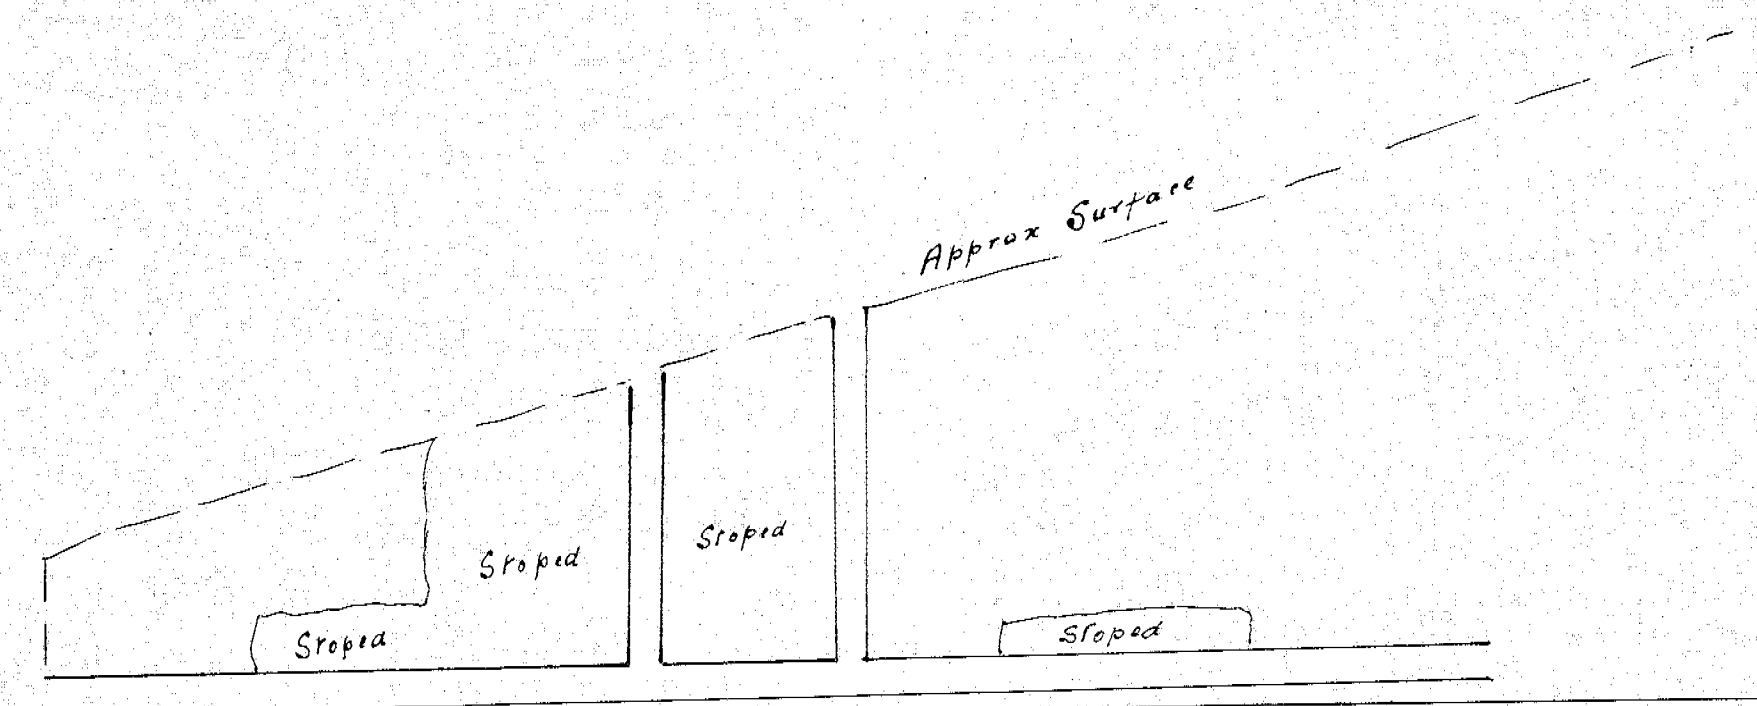

Long Section No 2 Drive

Squib Mine

Scale 40 Ft to 1 in

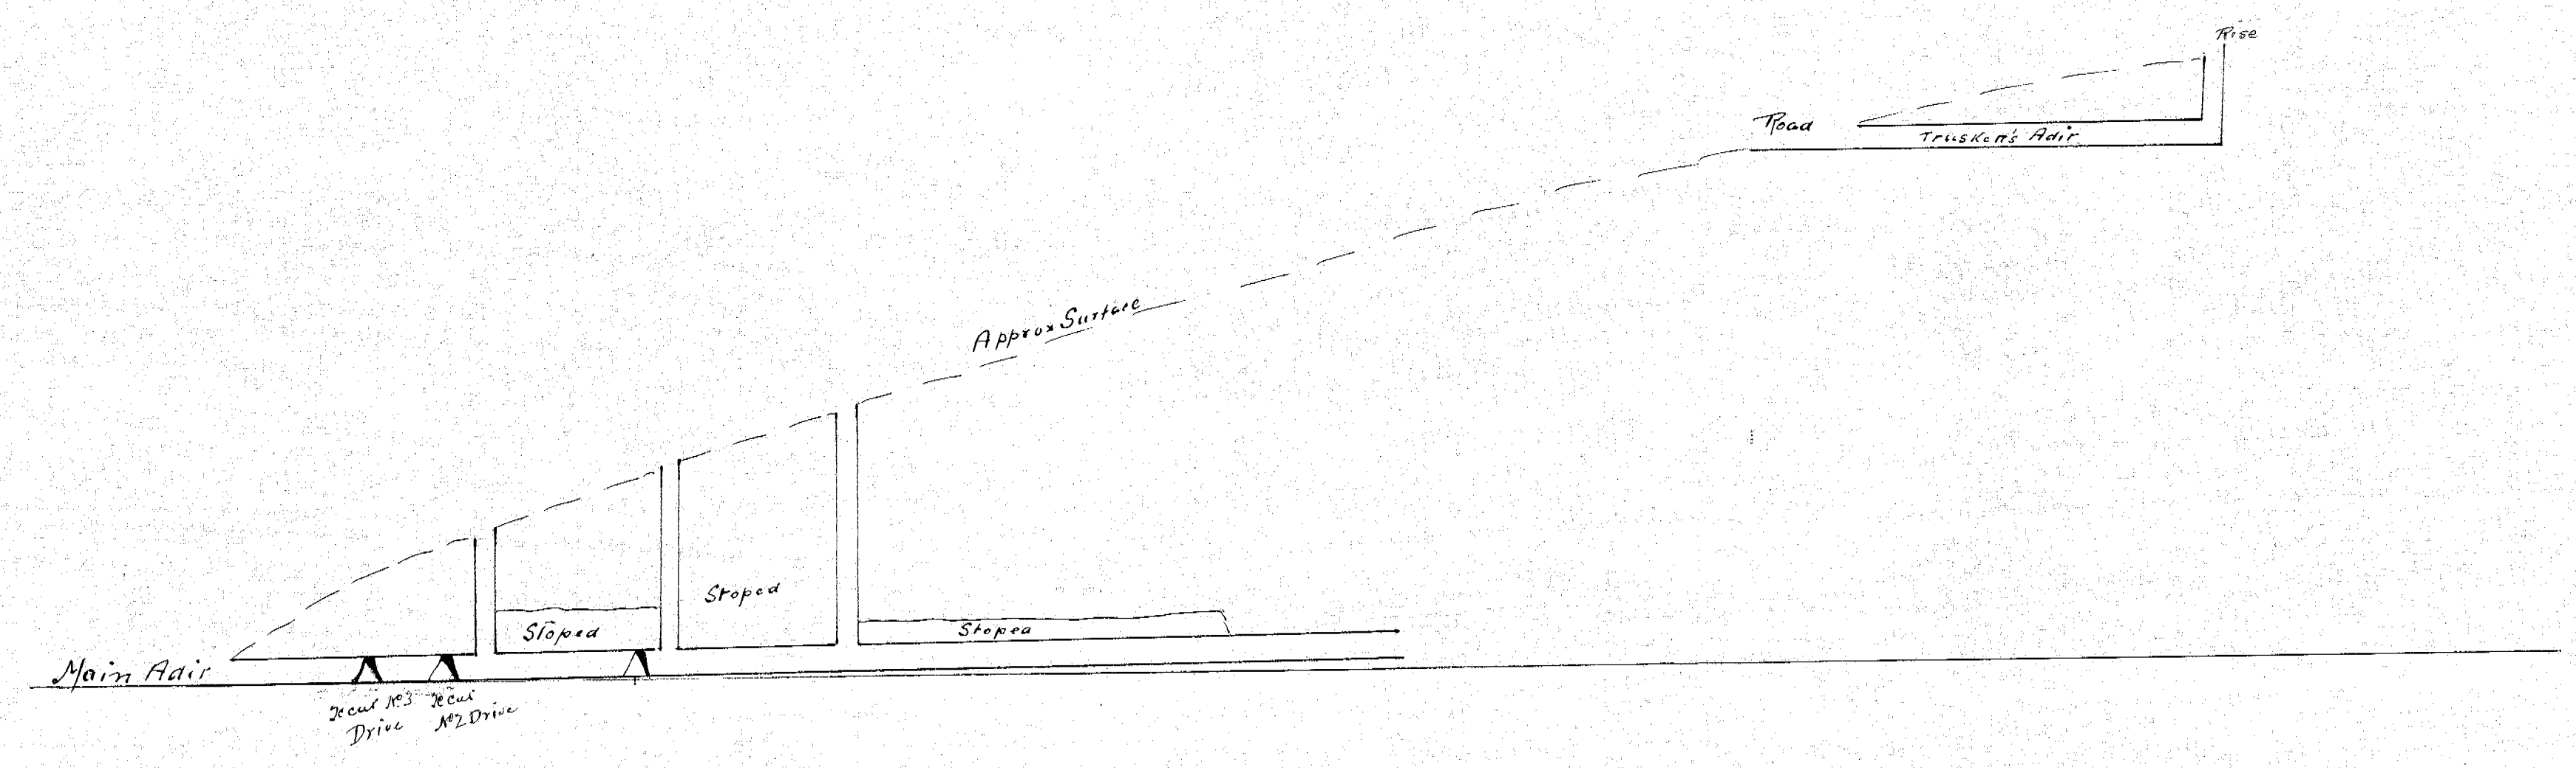

Long Section No 1 Drive

W. L. Huchins
19/8/18