194 P 51ac H. J. O'Neill
M

THE HARD-TO-GET COAL MINE.

DEVON.

NEW BED. Between RAILTON-DULVERTON.

Scale 1" = 40'.

5" Transit + 4" Compass used.

Date Surveyed	Office Examination
May 33	9 6 33 AP
March 34	17 4 34 AP
" 35	31 7 35 AP
Jan 37	5 1 37 AP

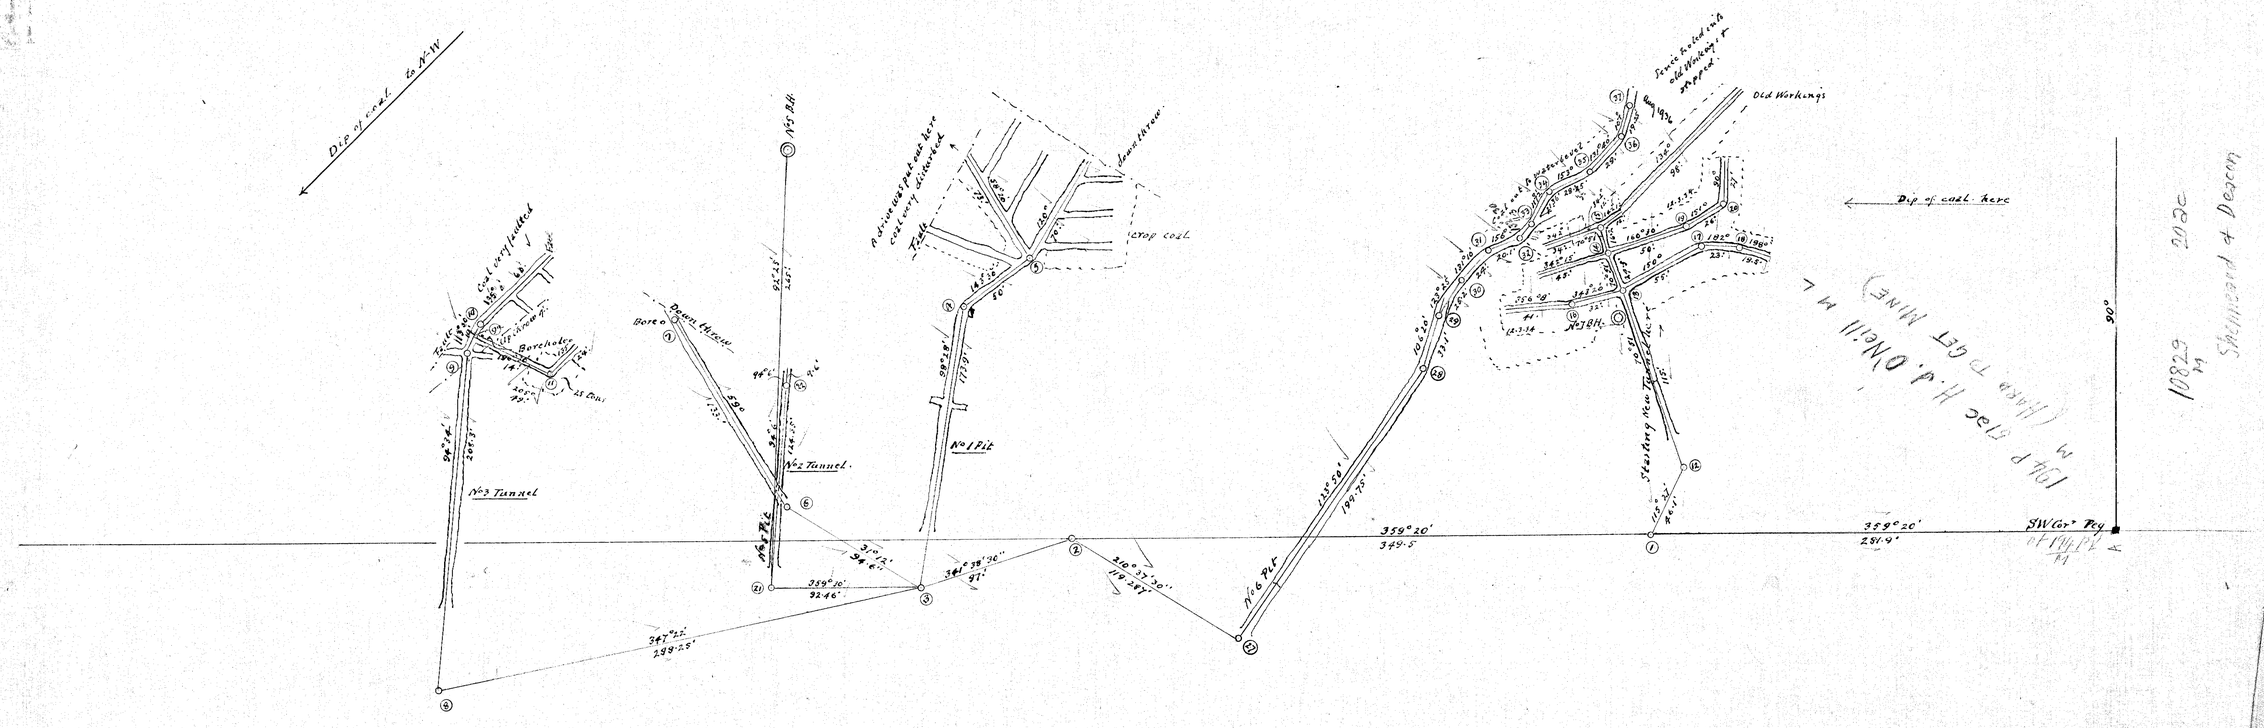

10829
M
2ac
Shepherd & Deacon

194 P 51ac H. J. O'Neill M.L.
M (Hard to Get Mine)

11-01