


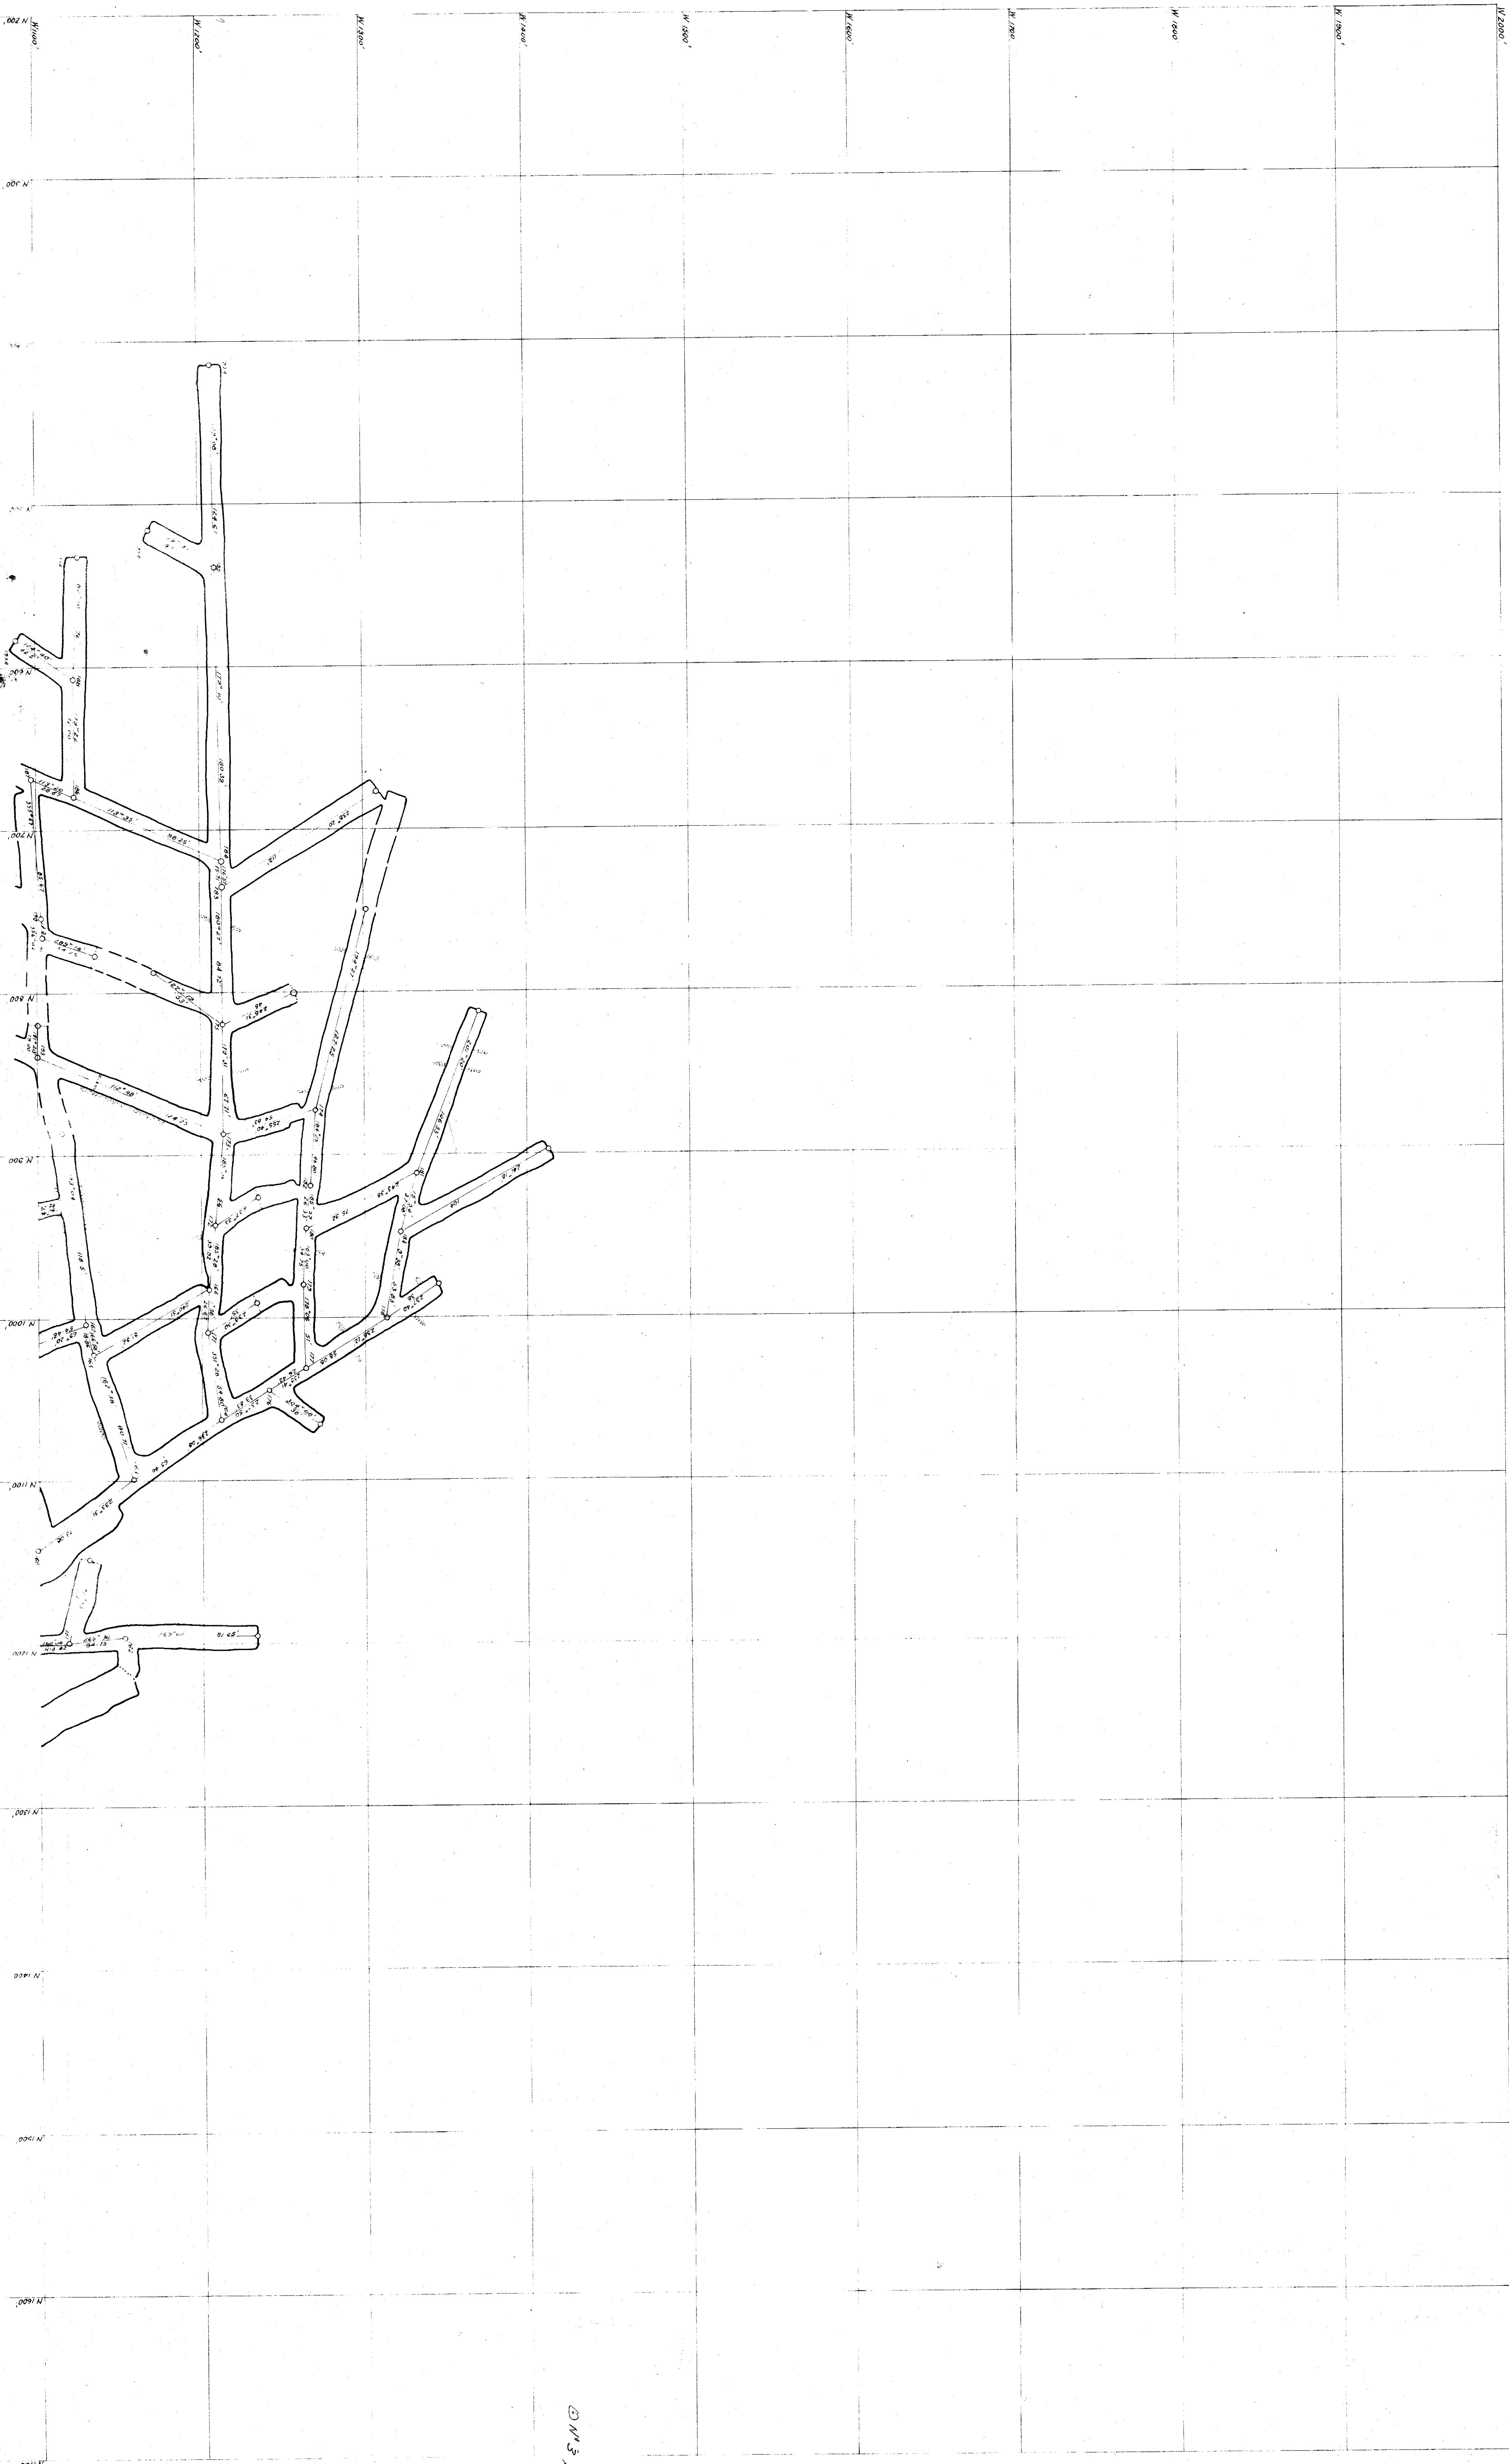

3113 A₂