SHORE'S SUCCESS GOLD MINING CO.

SCALE 40 FT TO 1 INCH

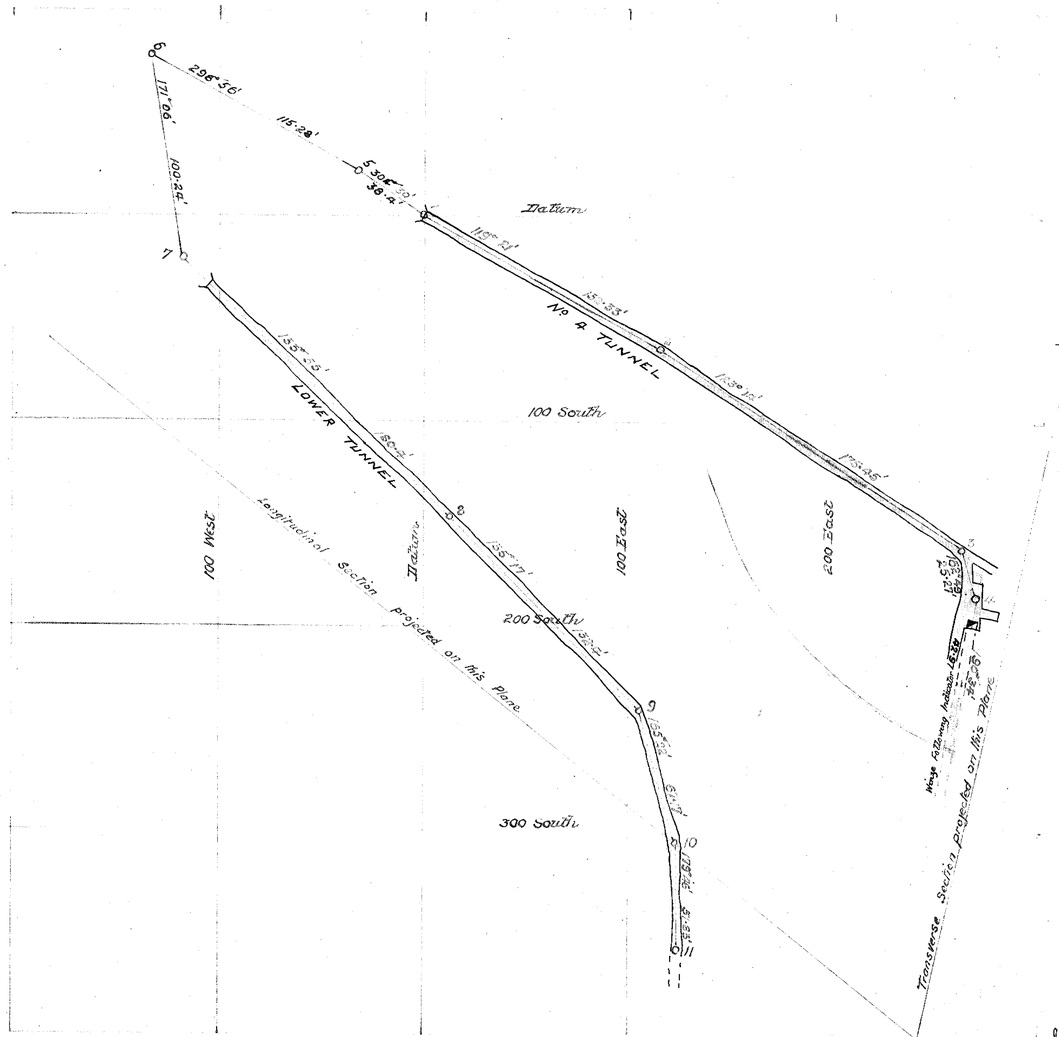

PLAN

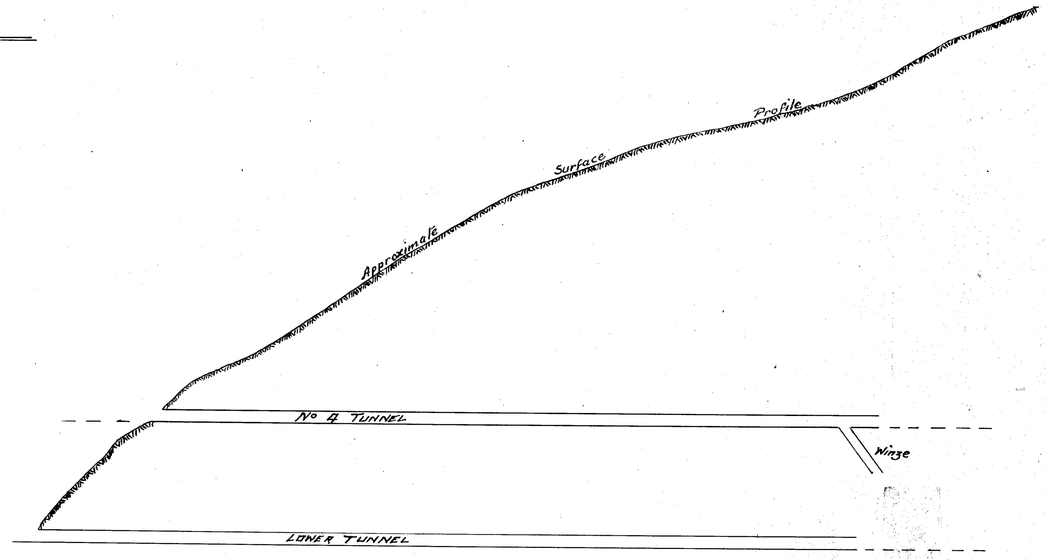

LONGITUDINAL SECTION

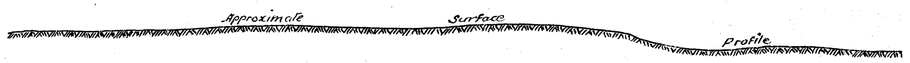

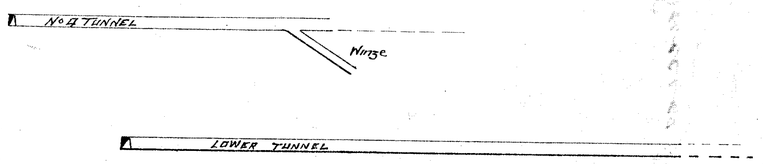

TRANSVERSE SECTION

H Somerville
Mining Surveyor
15-9-23.

14 - 01

14