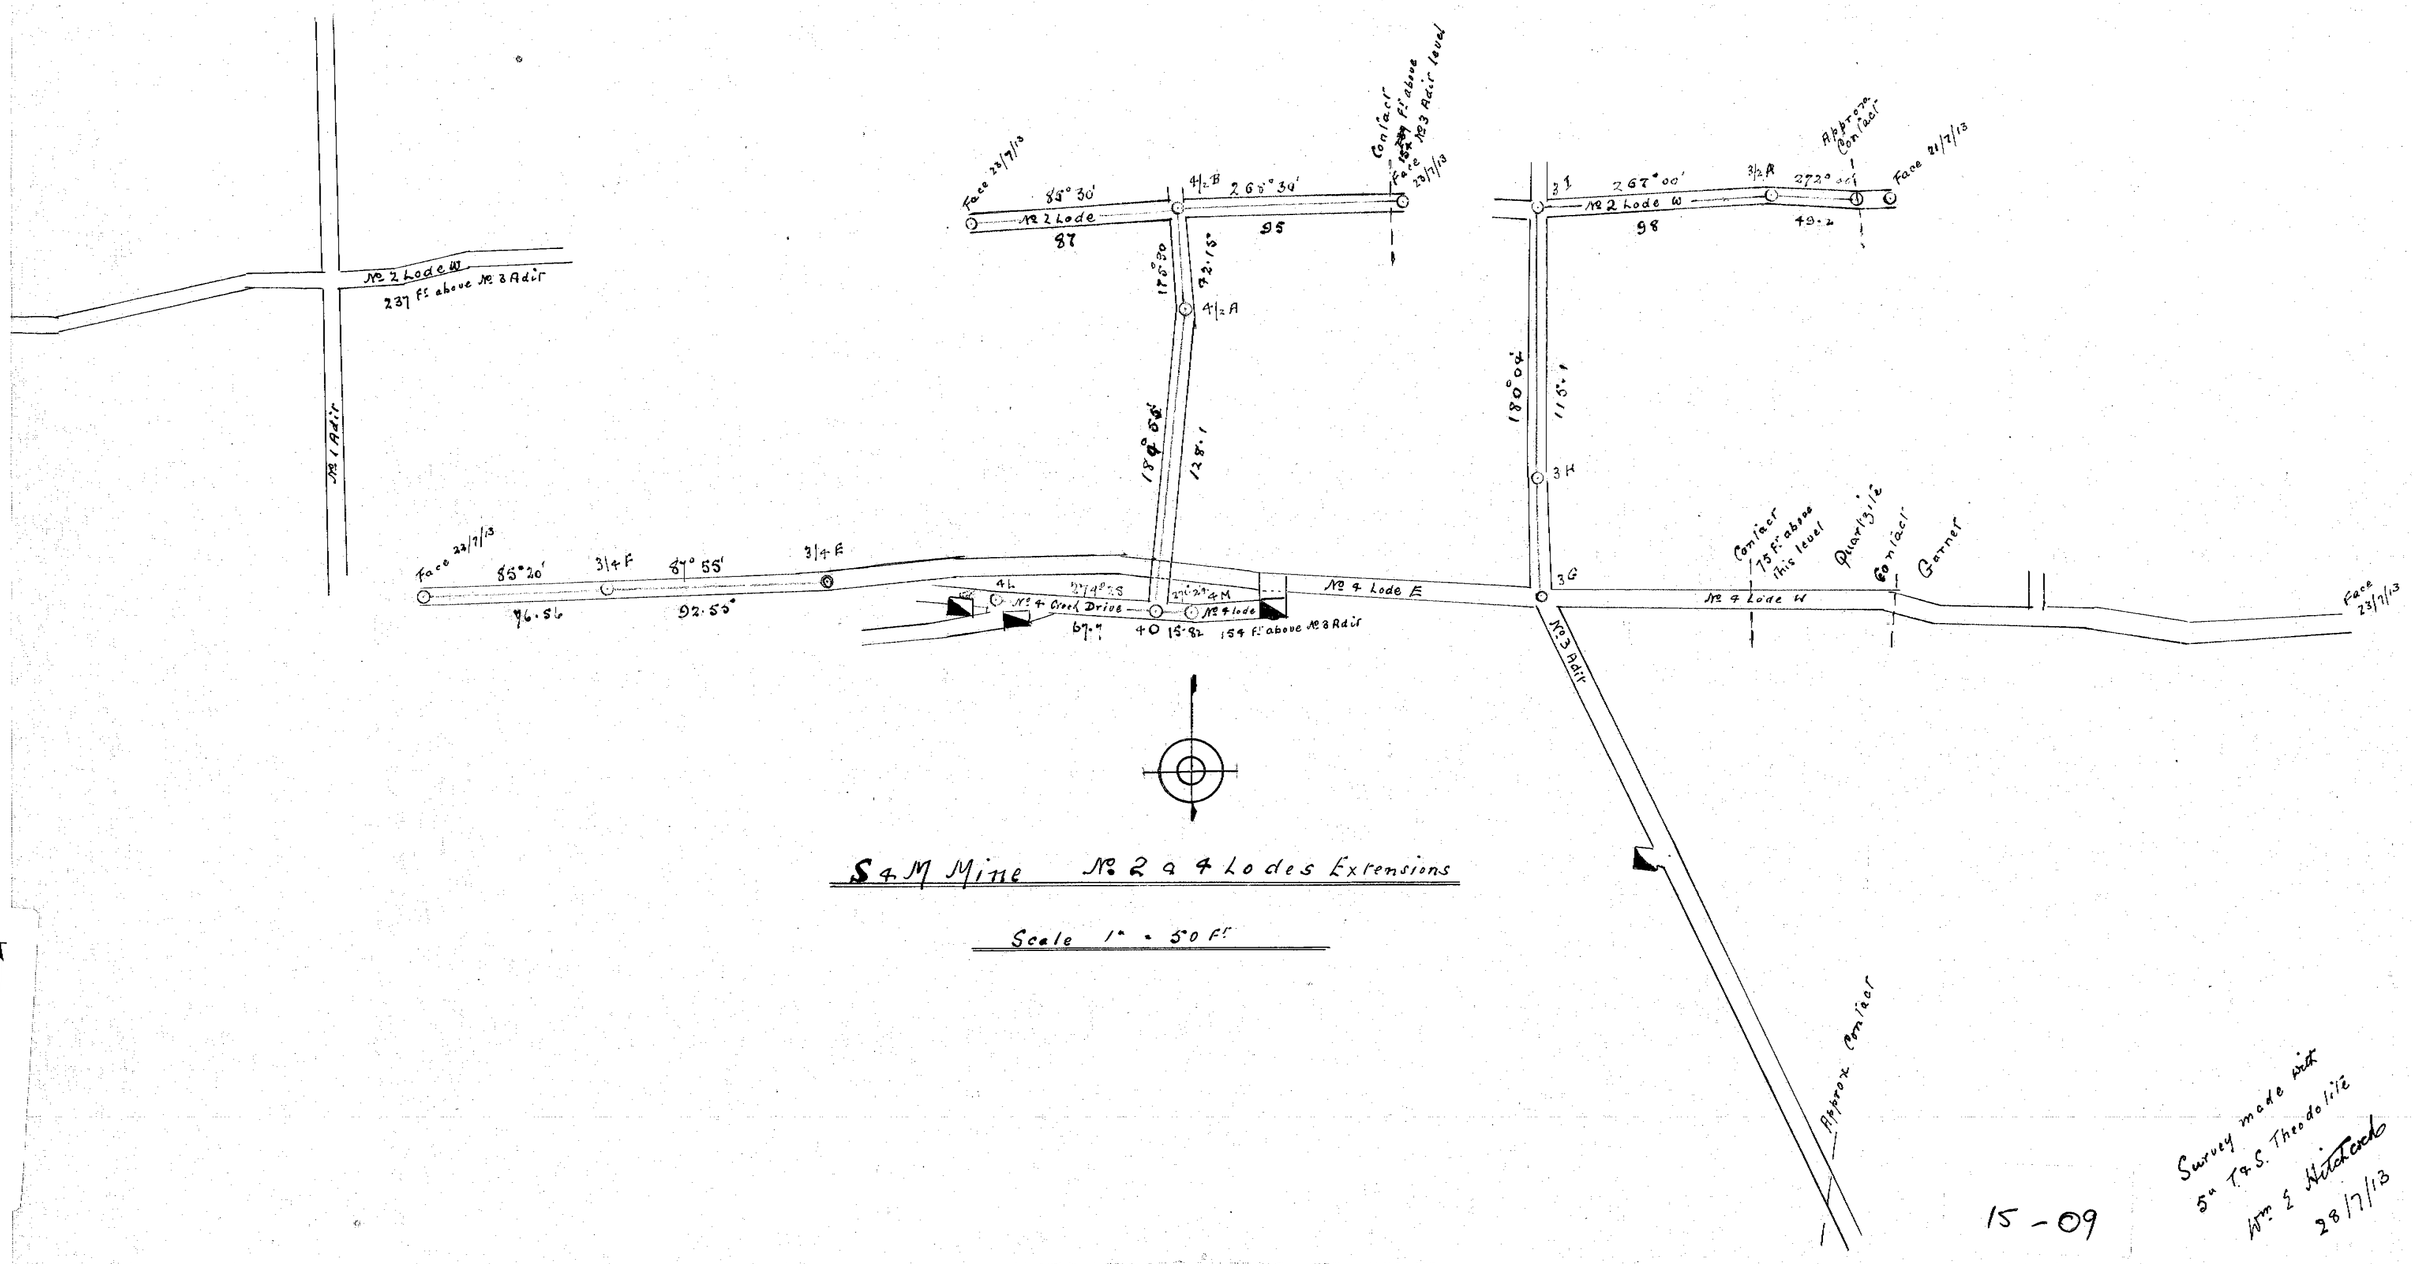
No 2 Lode W
237 ft above No 3 Adit
No 1 Adit
Face 22/7/13
85° 30'
No 2 Lode
87
4½B
265° 34'
95
Contact 237 ft above Face No 3 Adit level
178° 30'
72.15
4½A
178° 50'
128.1
Face 22/7/13
85° 20'
3/4 F
87° 55'
3/4 E
96.56
92.50
4L
No 4 Cross Cut
No 4 Cross Drive
No 4 Lode
No 4 Lode E
67.7
40
15.82
154 ft above No 3 Adir
3 I
267° 00'
3½A
272° 00'
Approx. Contact
Face 22/7/13
No 2 Lode W
98
49.2
180° 00'
115.1
3H
3G
Contact 15 ft above this level
Quartzite
Contact
Gerner
No 4 Lode W
Face 23/7/13
No 3 Adit
Approx. Contact
S & M Mine No 2 & 4 Lodes Extensions
Scale 1" = 50 ft
Survey made with 5" T & S. Theodolite
Wm. E. Hitchcock
28/7/13
15 - 09