S. & M. MINE

Stope Sections Showing Ore Reserves as 30/6/27

Scale 50ft is 1in

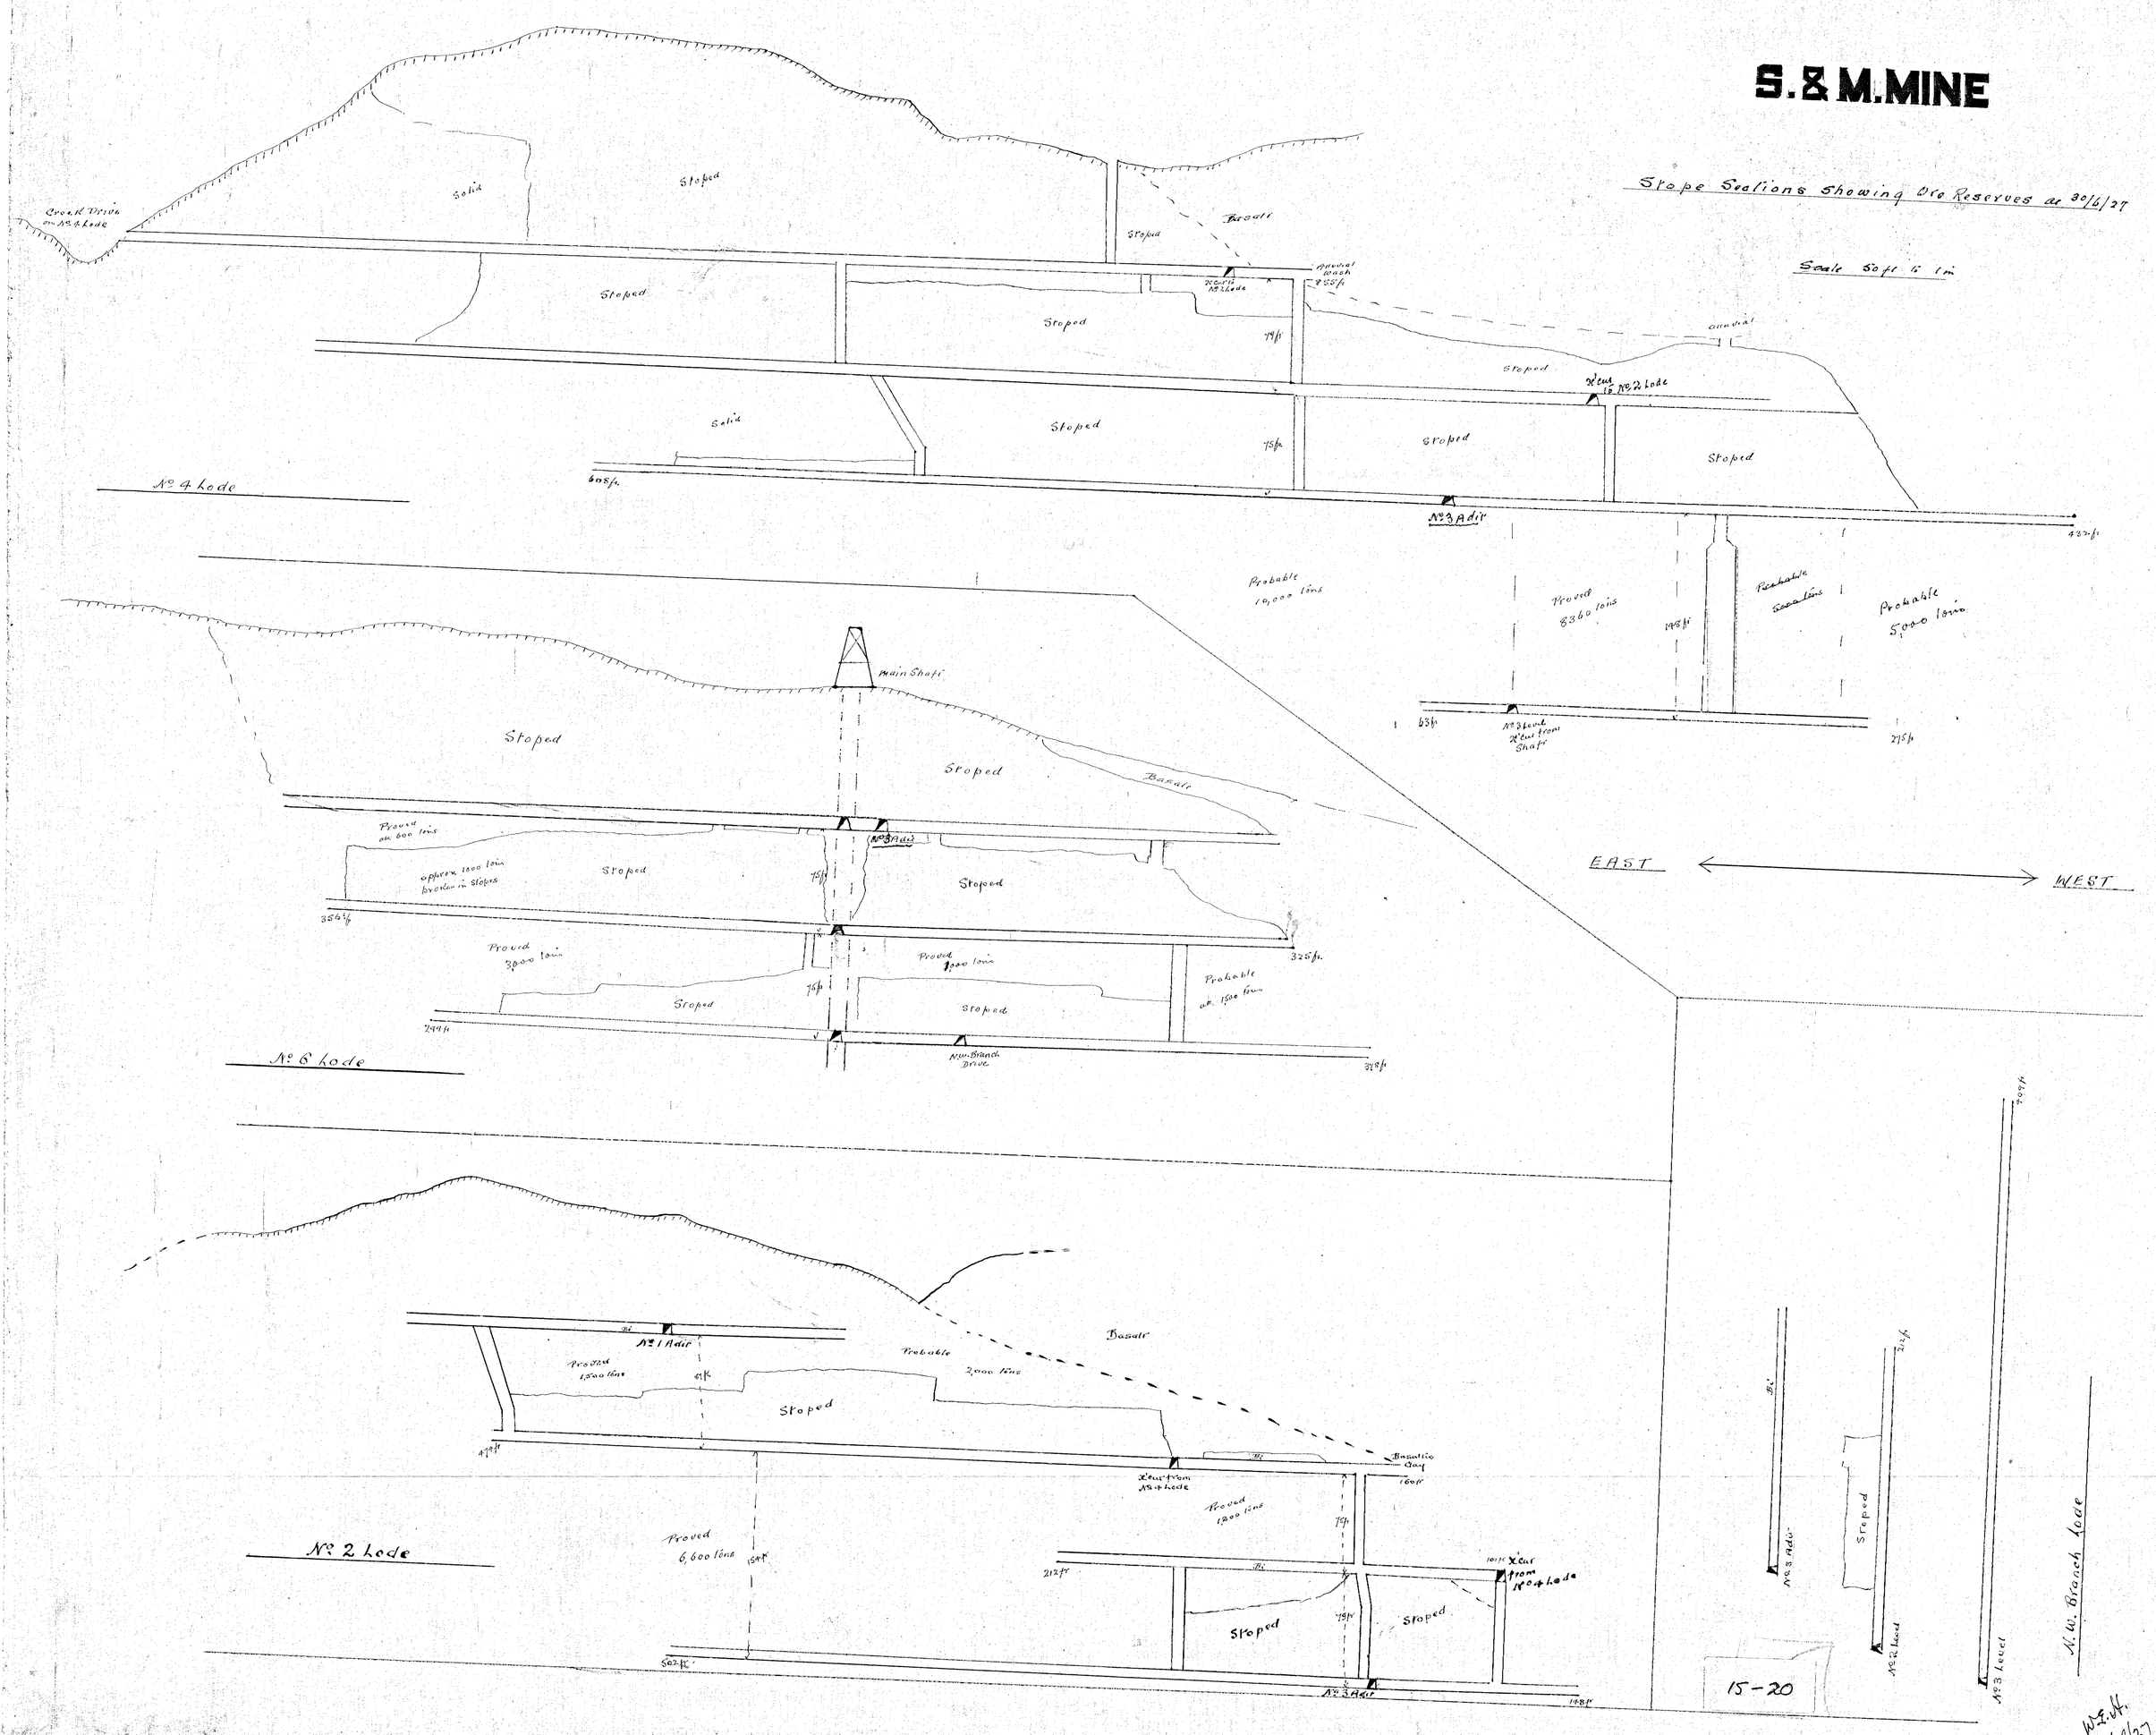

W.E.H.
25/7/27