
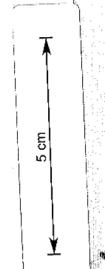


15-27 15-28

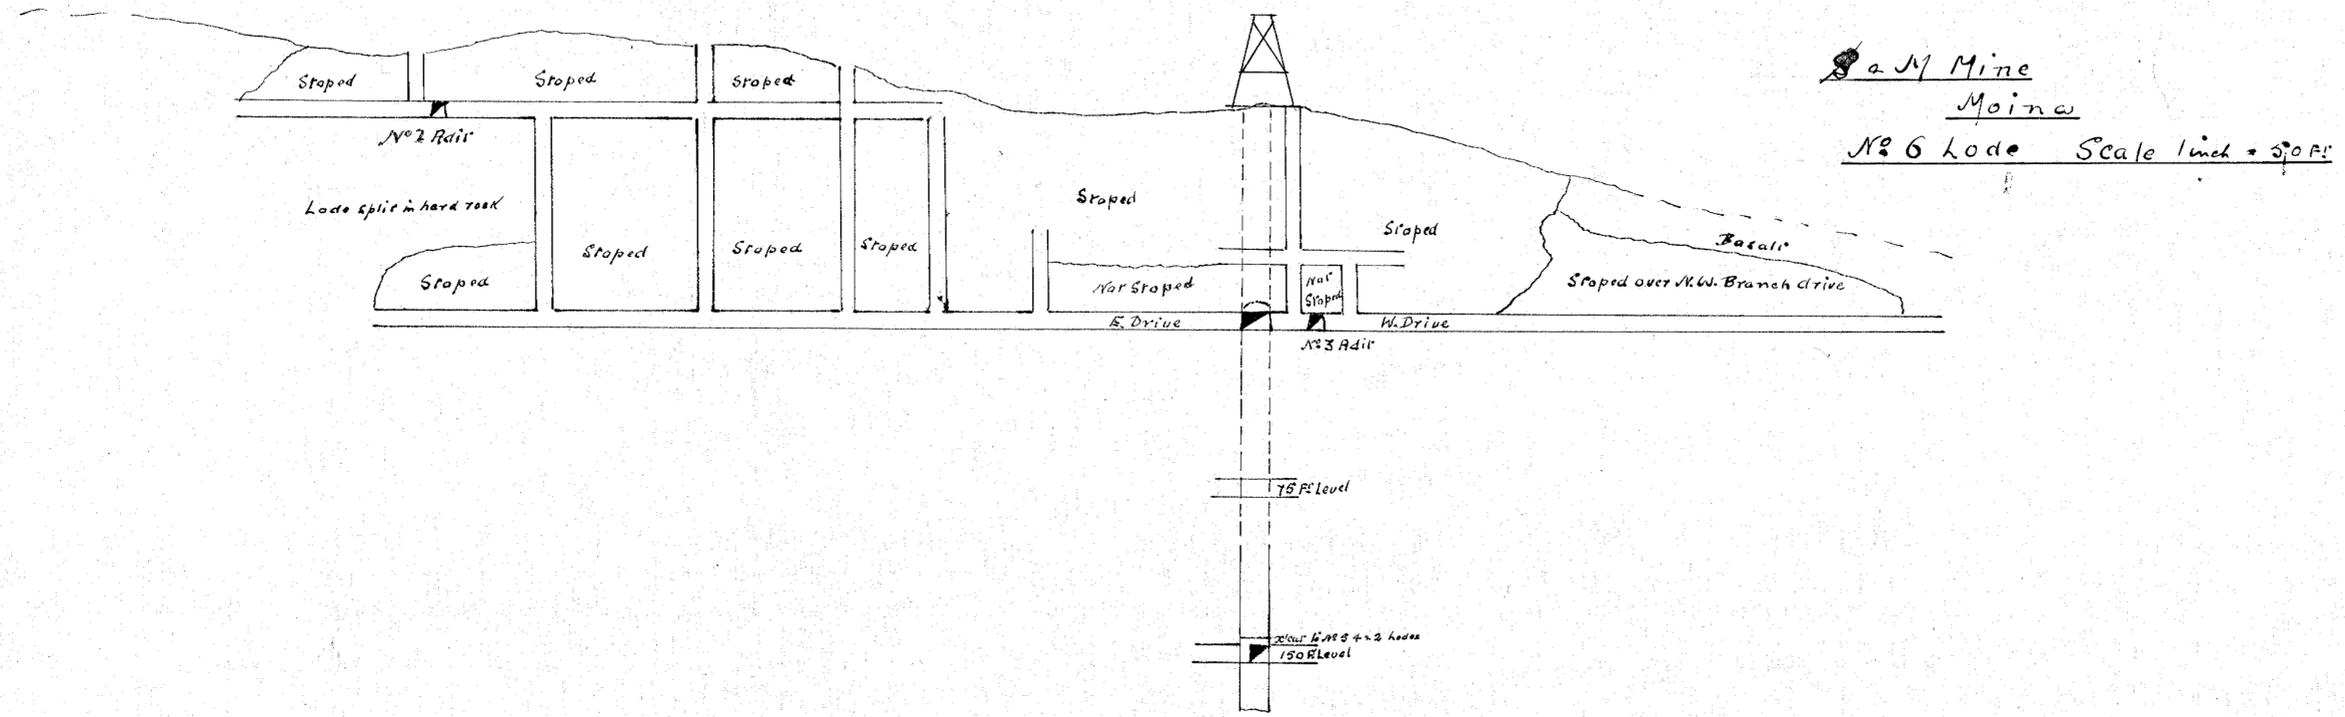

15-28

Wm S. Hatcher and
B. J. Wiley 1877