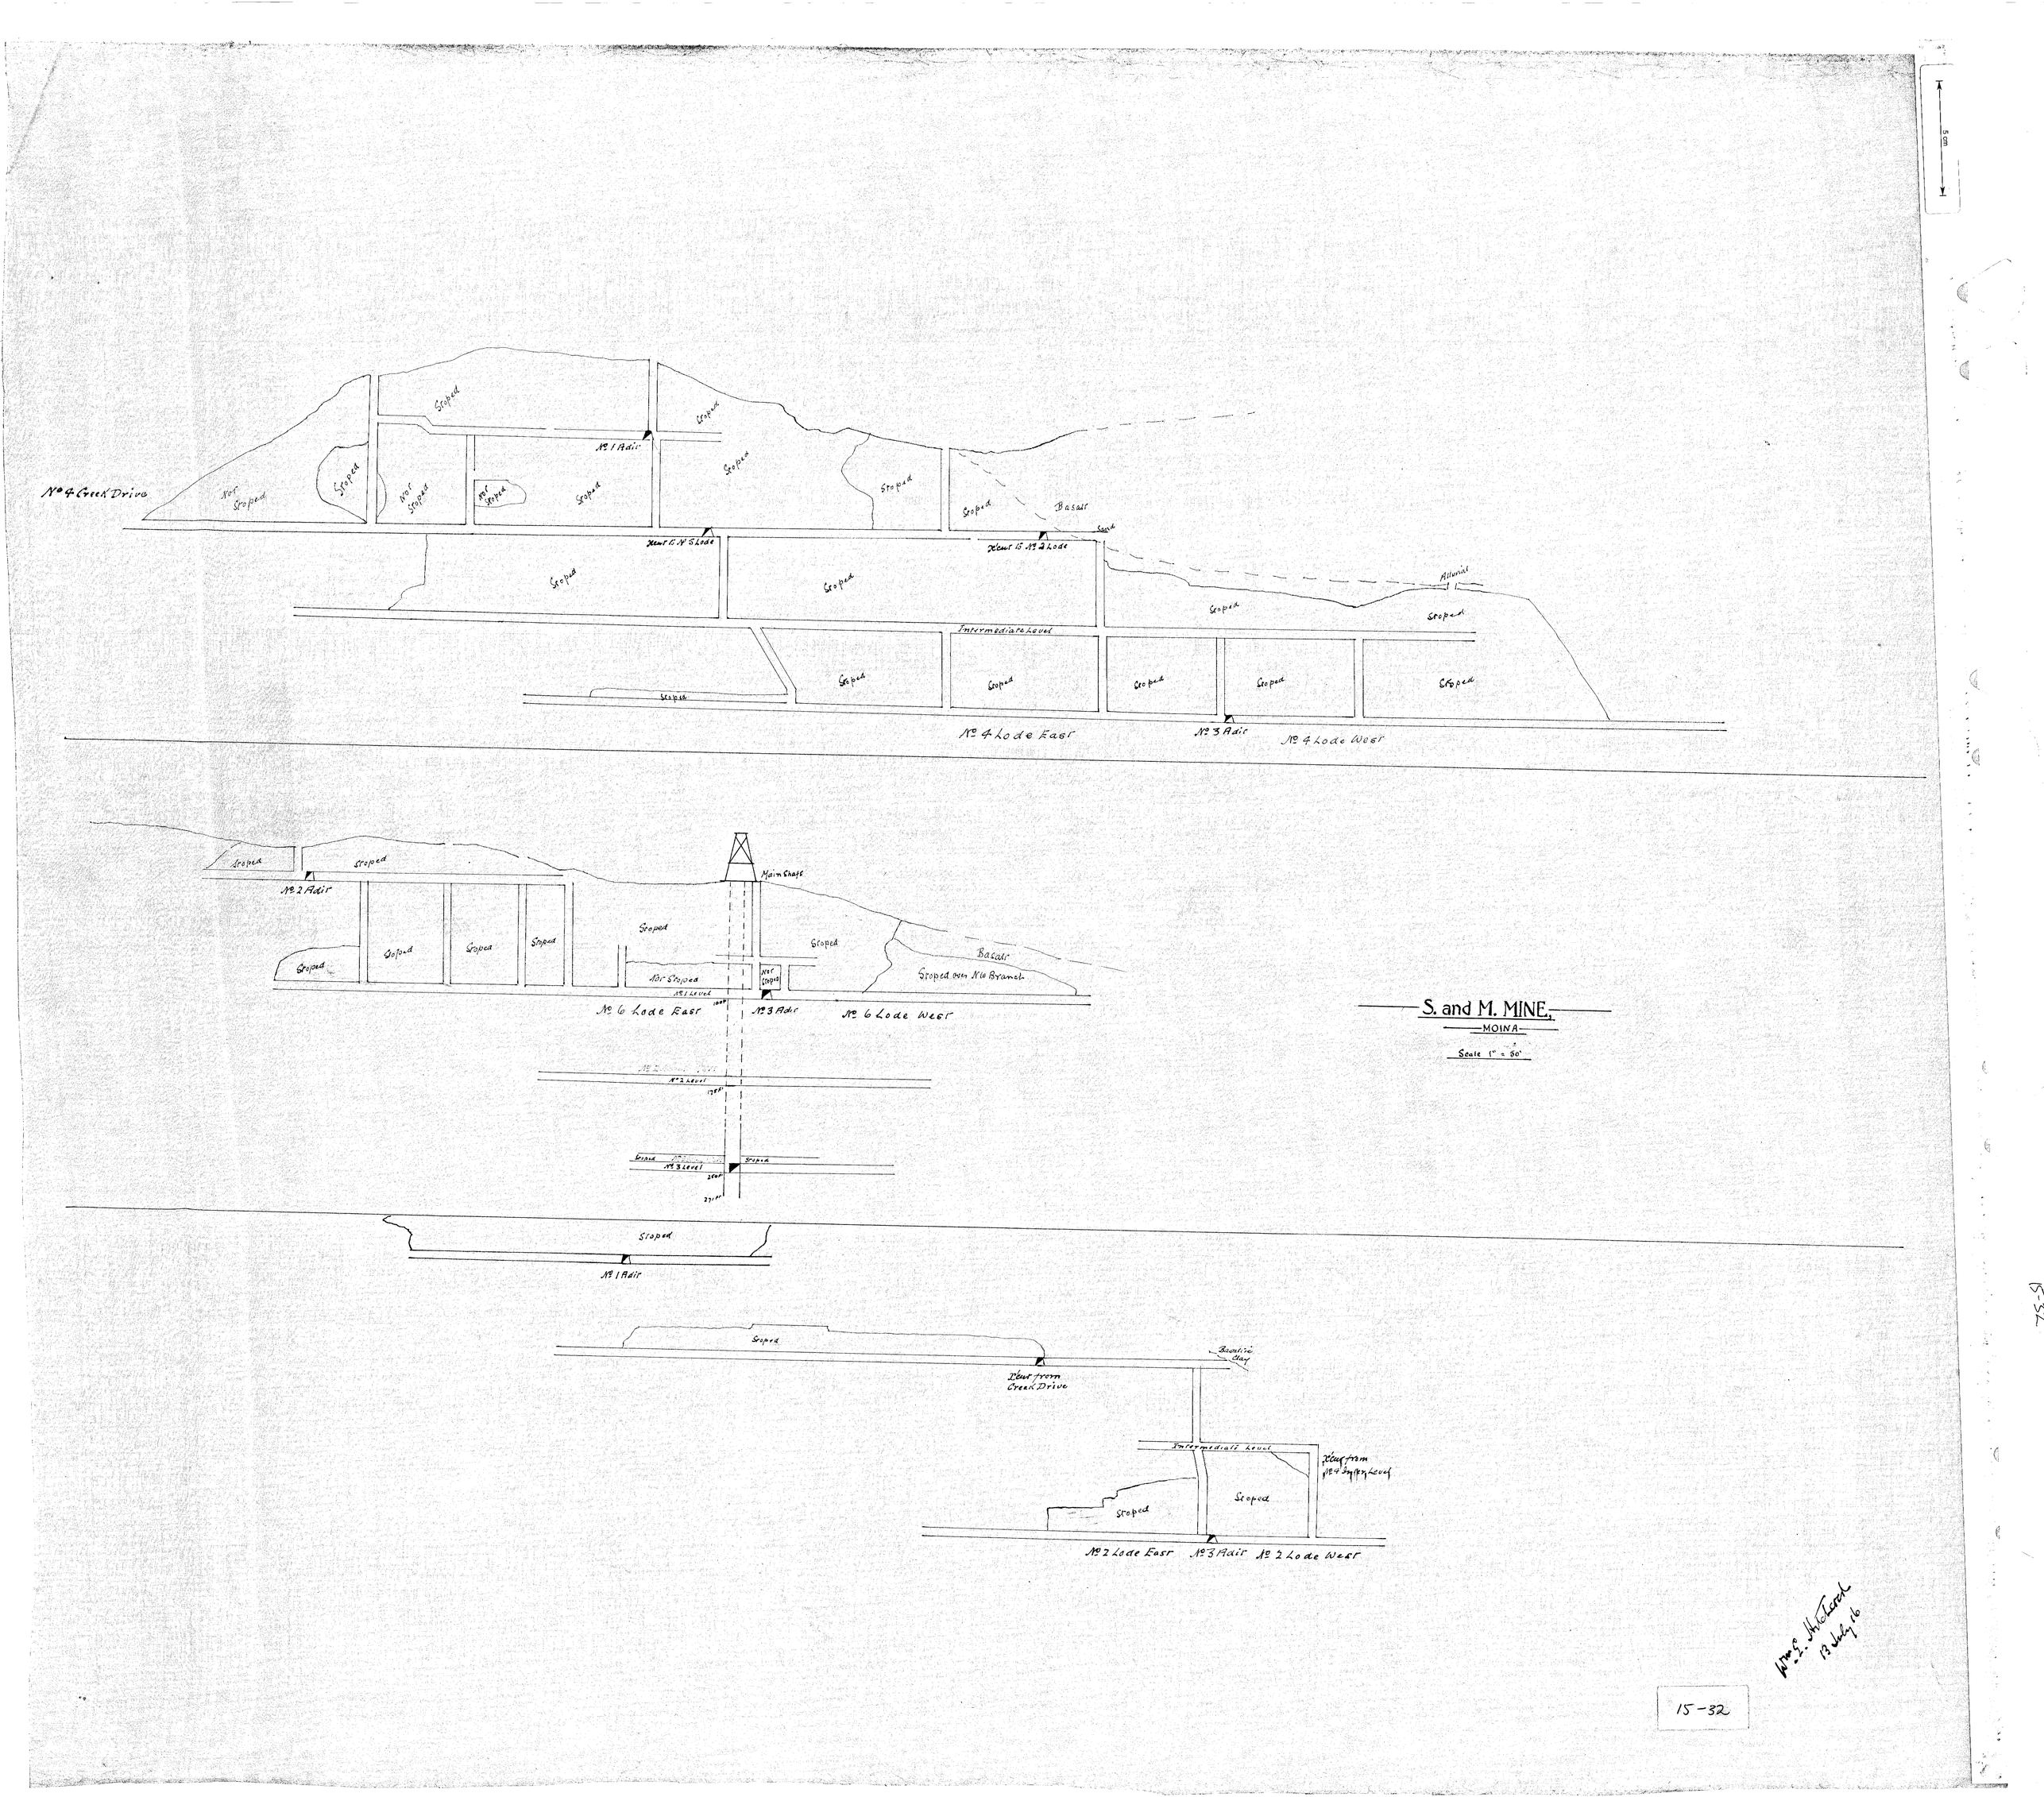
5m
No 4 Creek Drive
Not Stoped
Stoped
No 1 Adit
Heut to No 5 Lode
Heut to No 4 Lode
Basalt
Sand
Alluvial
Intermediate Level
Stope
No 4 Lode East
No 3 Adit
No 4 Lode West
No 2 Adit
Main Shaft
Air Stoped
No 1 Level
No 6 Lode East
No 3 Adit
No 6 Lode West
Stoped over No 6 Branch
No 2 Level
No 3 Level
No 1 Adit
Heut from Creek Drive
Basalt Clay
Intermediate Level
Heut from No 4 Inclined Level
No 2 Lode East
No 3 Adit
No 2 Lode West
S. and M. MINE,
MOINA
Scale 1" = 50'

15-32