





5m



D. & M. Syndicate, Ltd.

Sections on Lodes — Looking South

Scale 50 ft = one inch

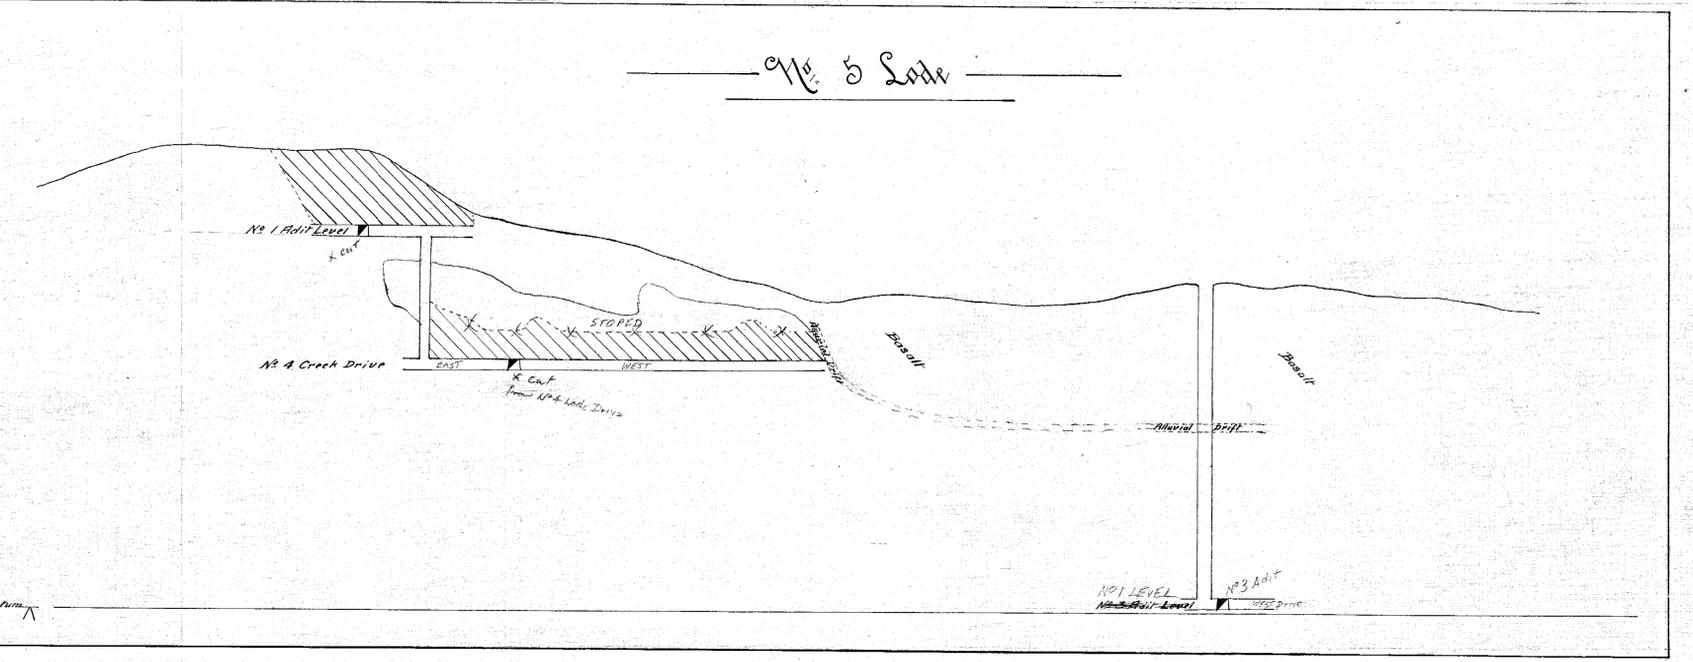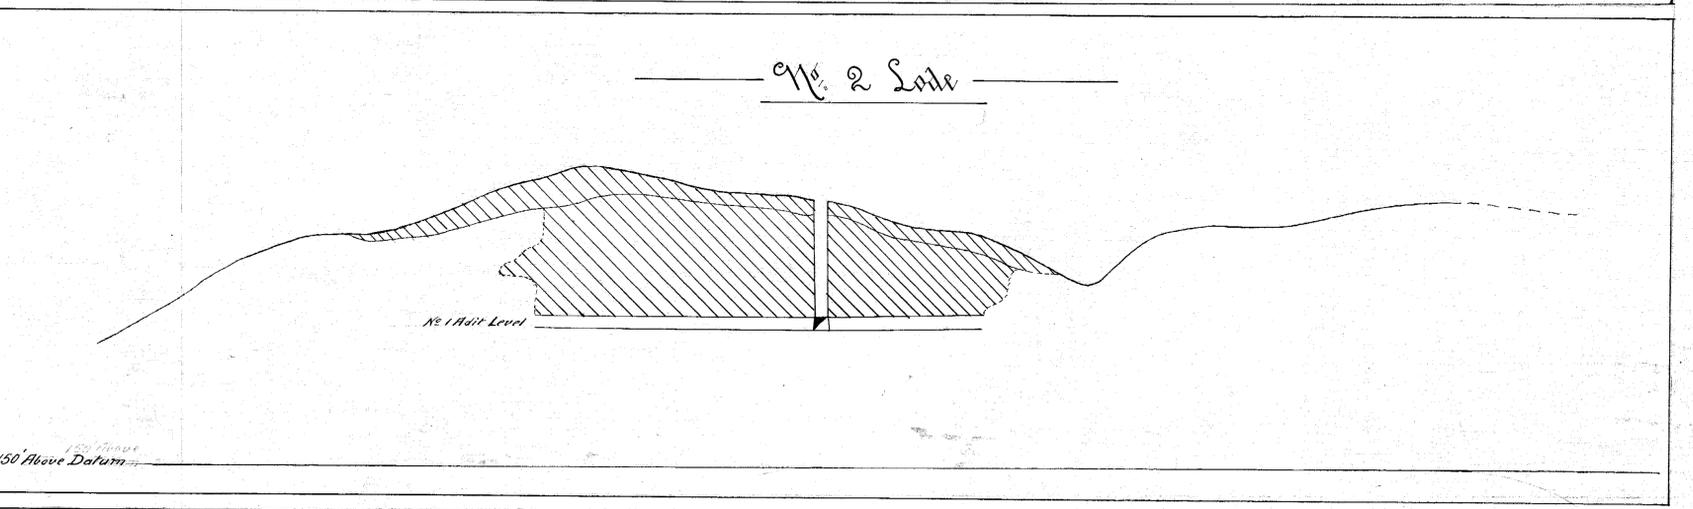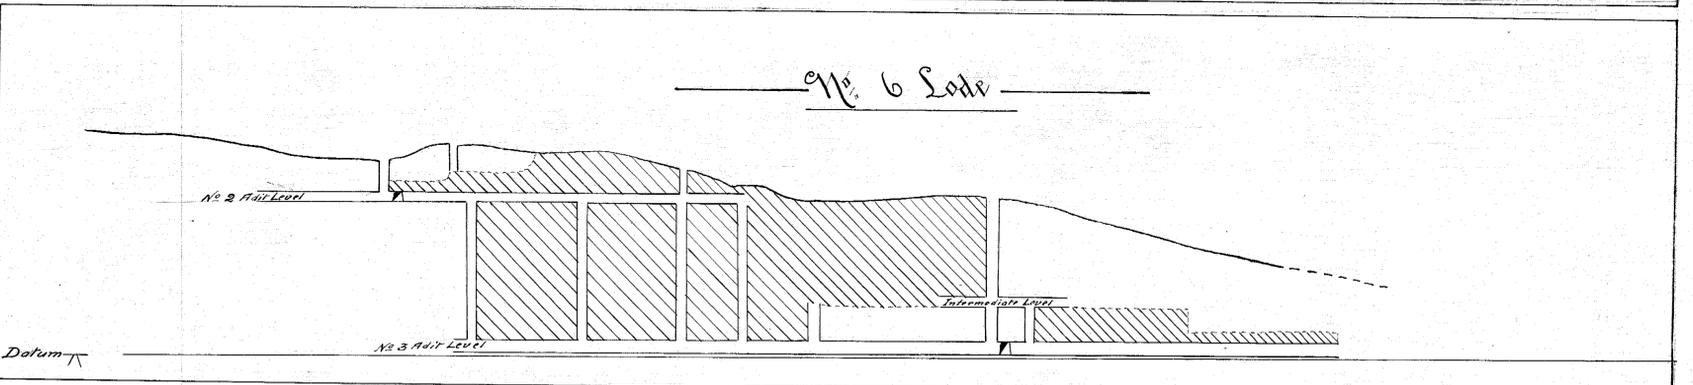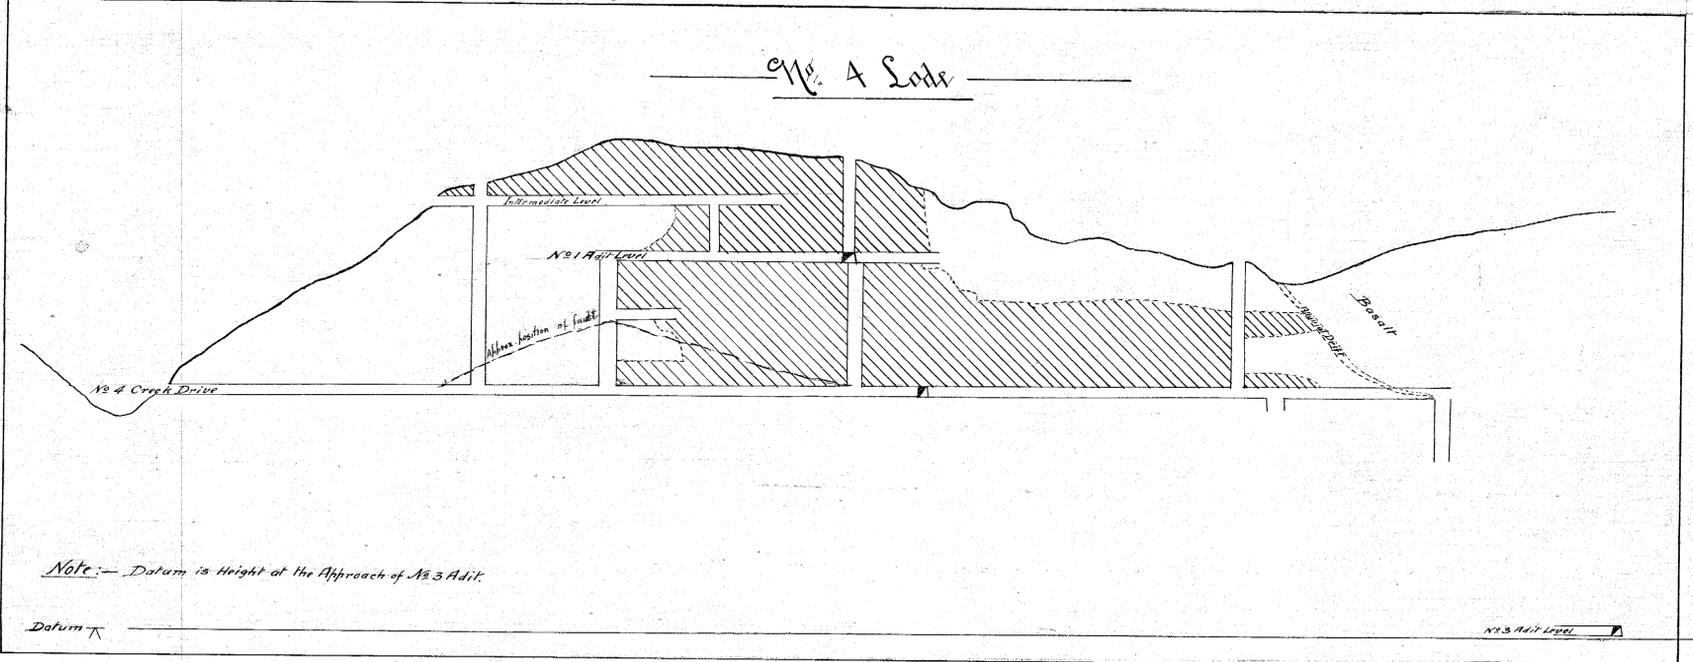

Wm E. Hitchcock
1898