



Scale 40 ft to 1 inch

5 cm

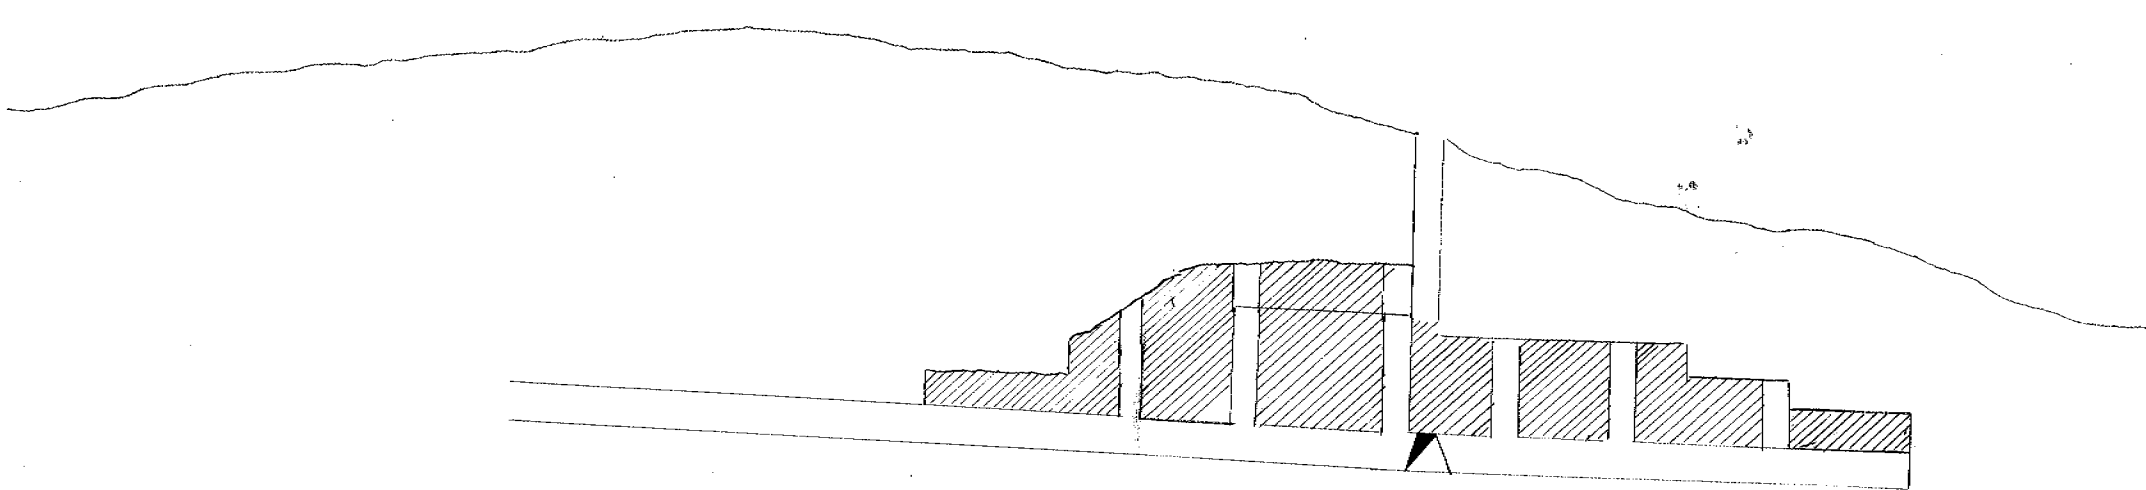


Section No 1 adi
No 2 lode
Scale 40 ft to 1 inch

Wm E. Hitchcock
14 May 08

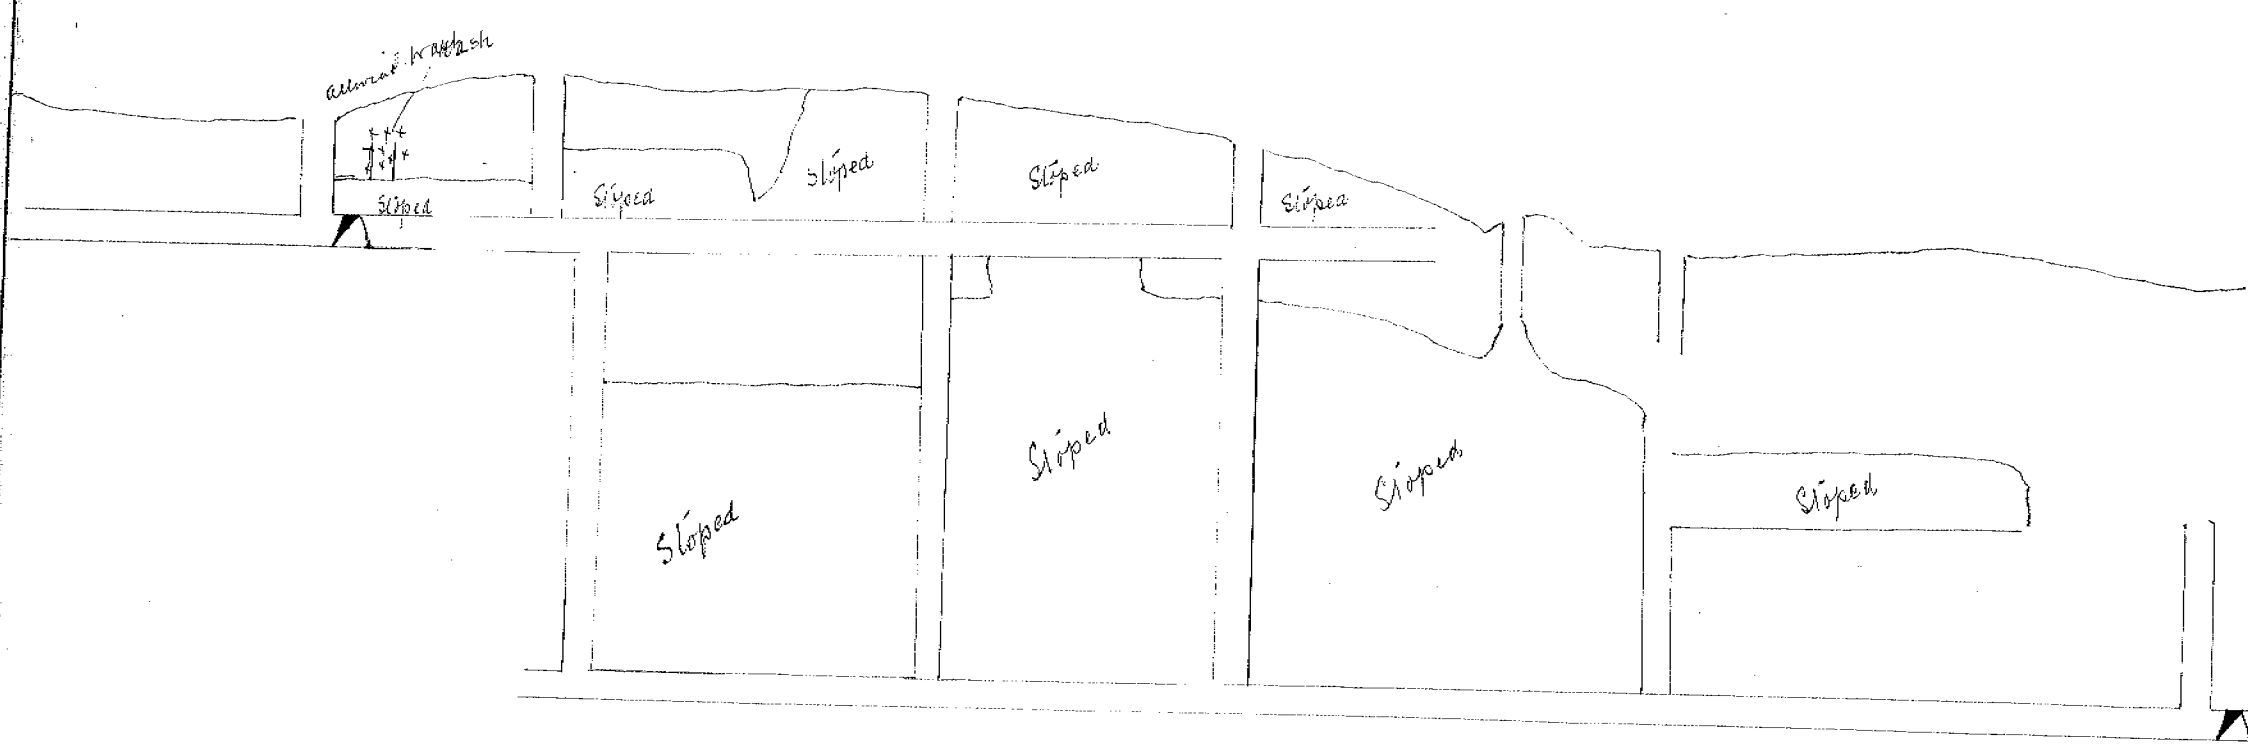

Section No 3 adi
No 6 lode
Scale 40 ft to 1 inch

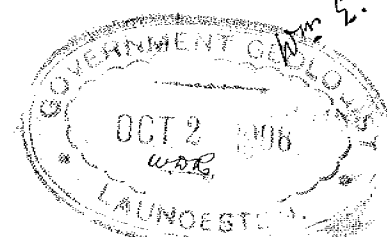

15-42a

Wm E. Hitchcock
14 May 08