TEASDALE'S COLLIERY

DULVERTON

Scale 25 ft to 1 inch

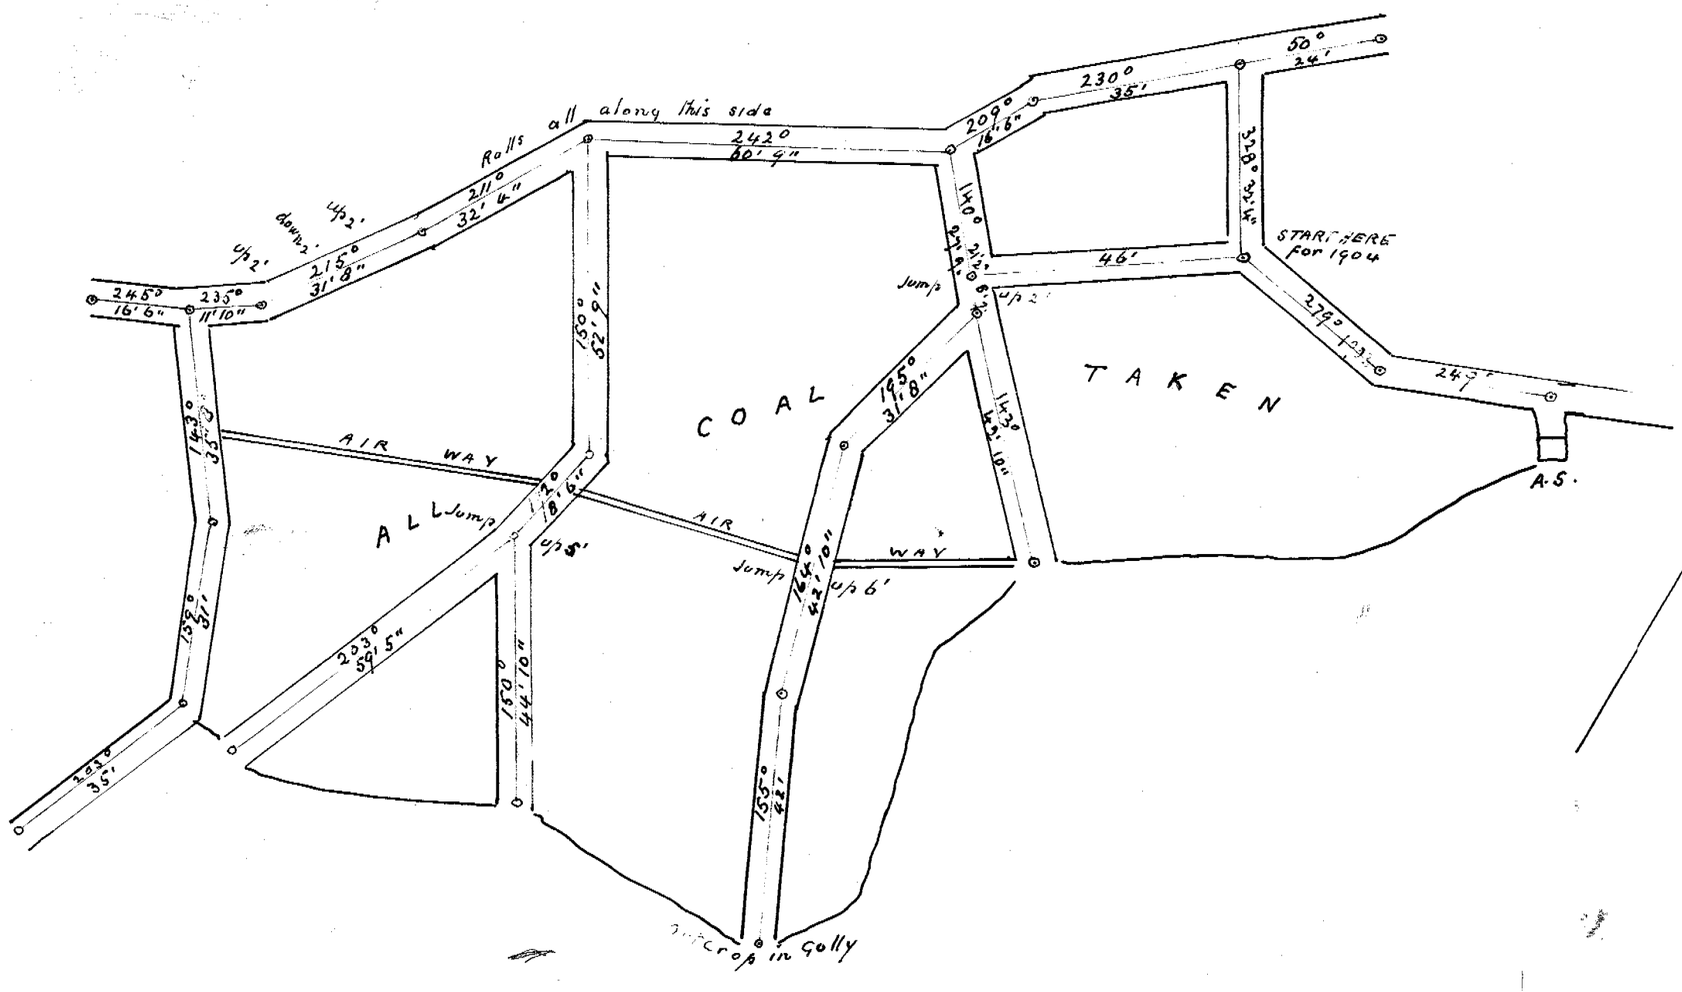

Certified correct copy of plan of work done during 1904

C. Bright Watchorn.

Gov't Surveyor

20/1/05

20 Jan 1905

17-04