SECTIONS

ABERFOYLE TIN N.L.
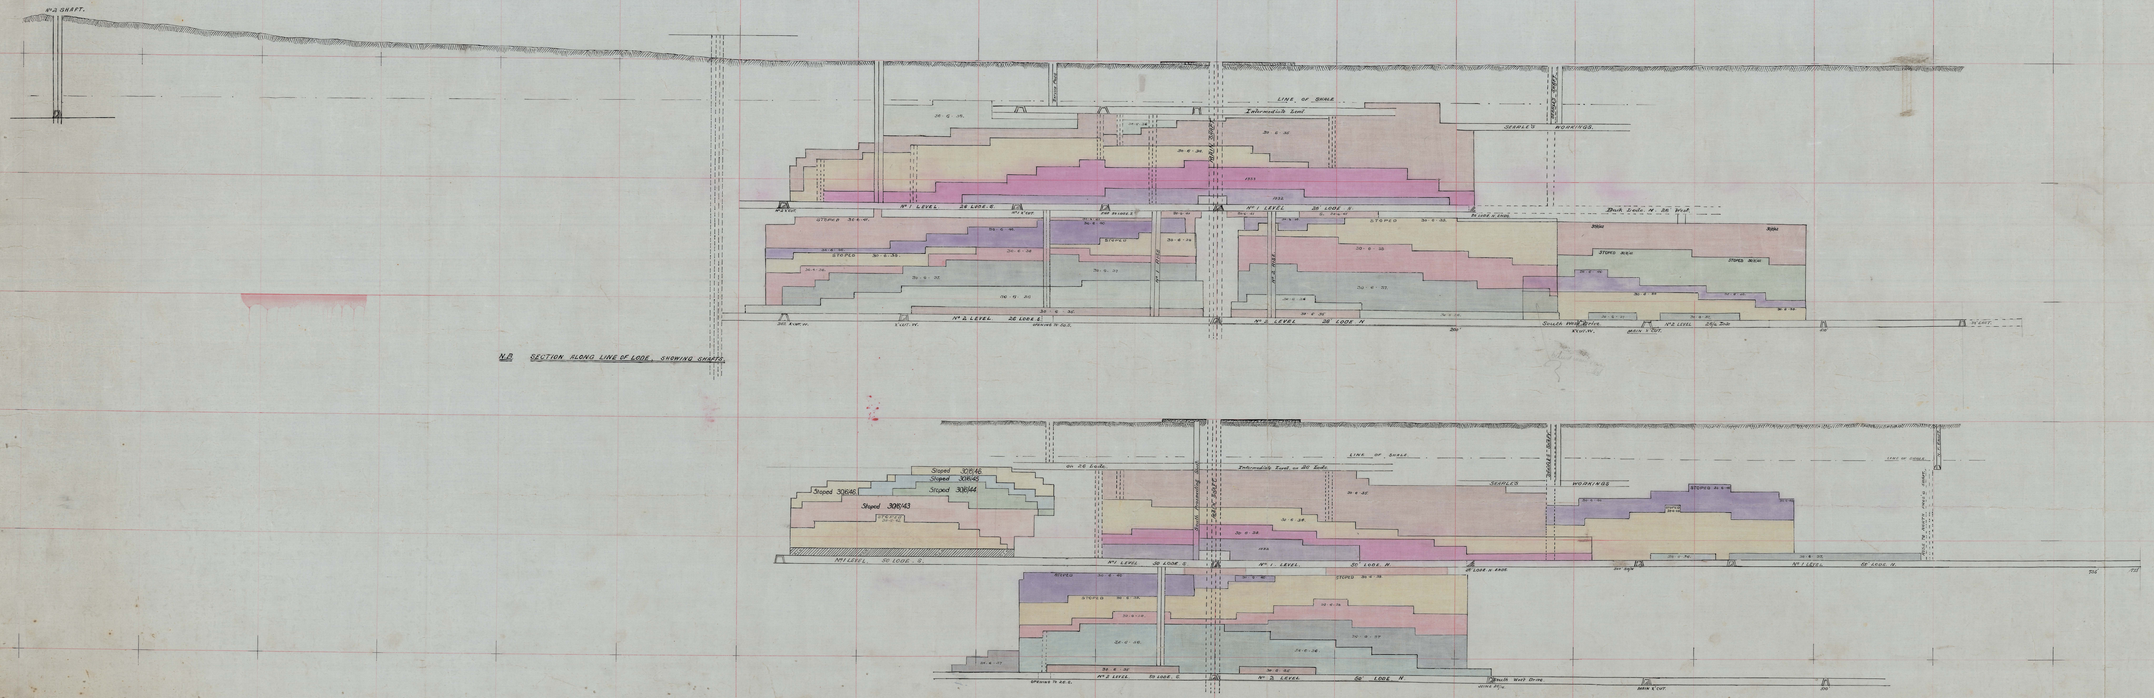
Scale 50'=1"