


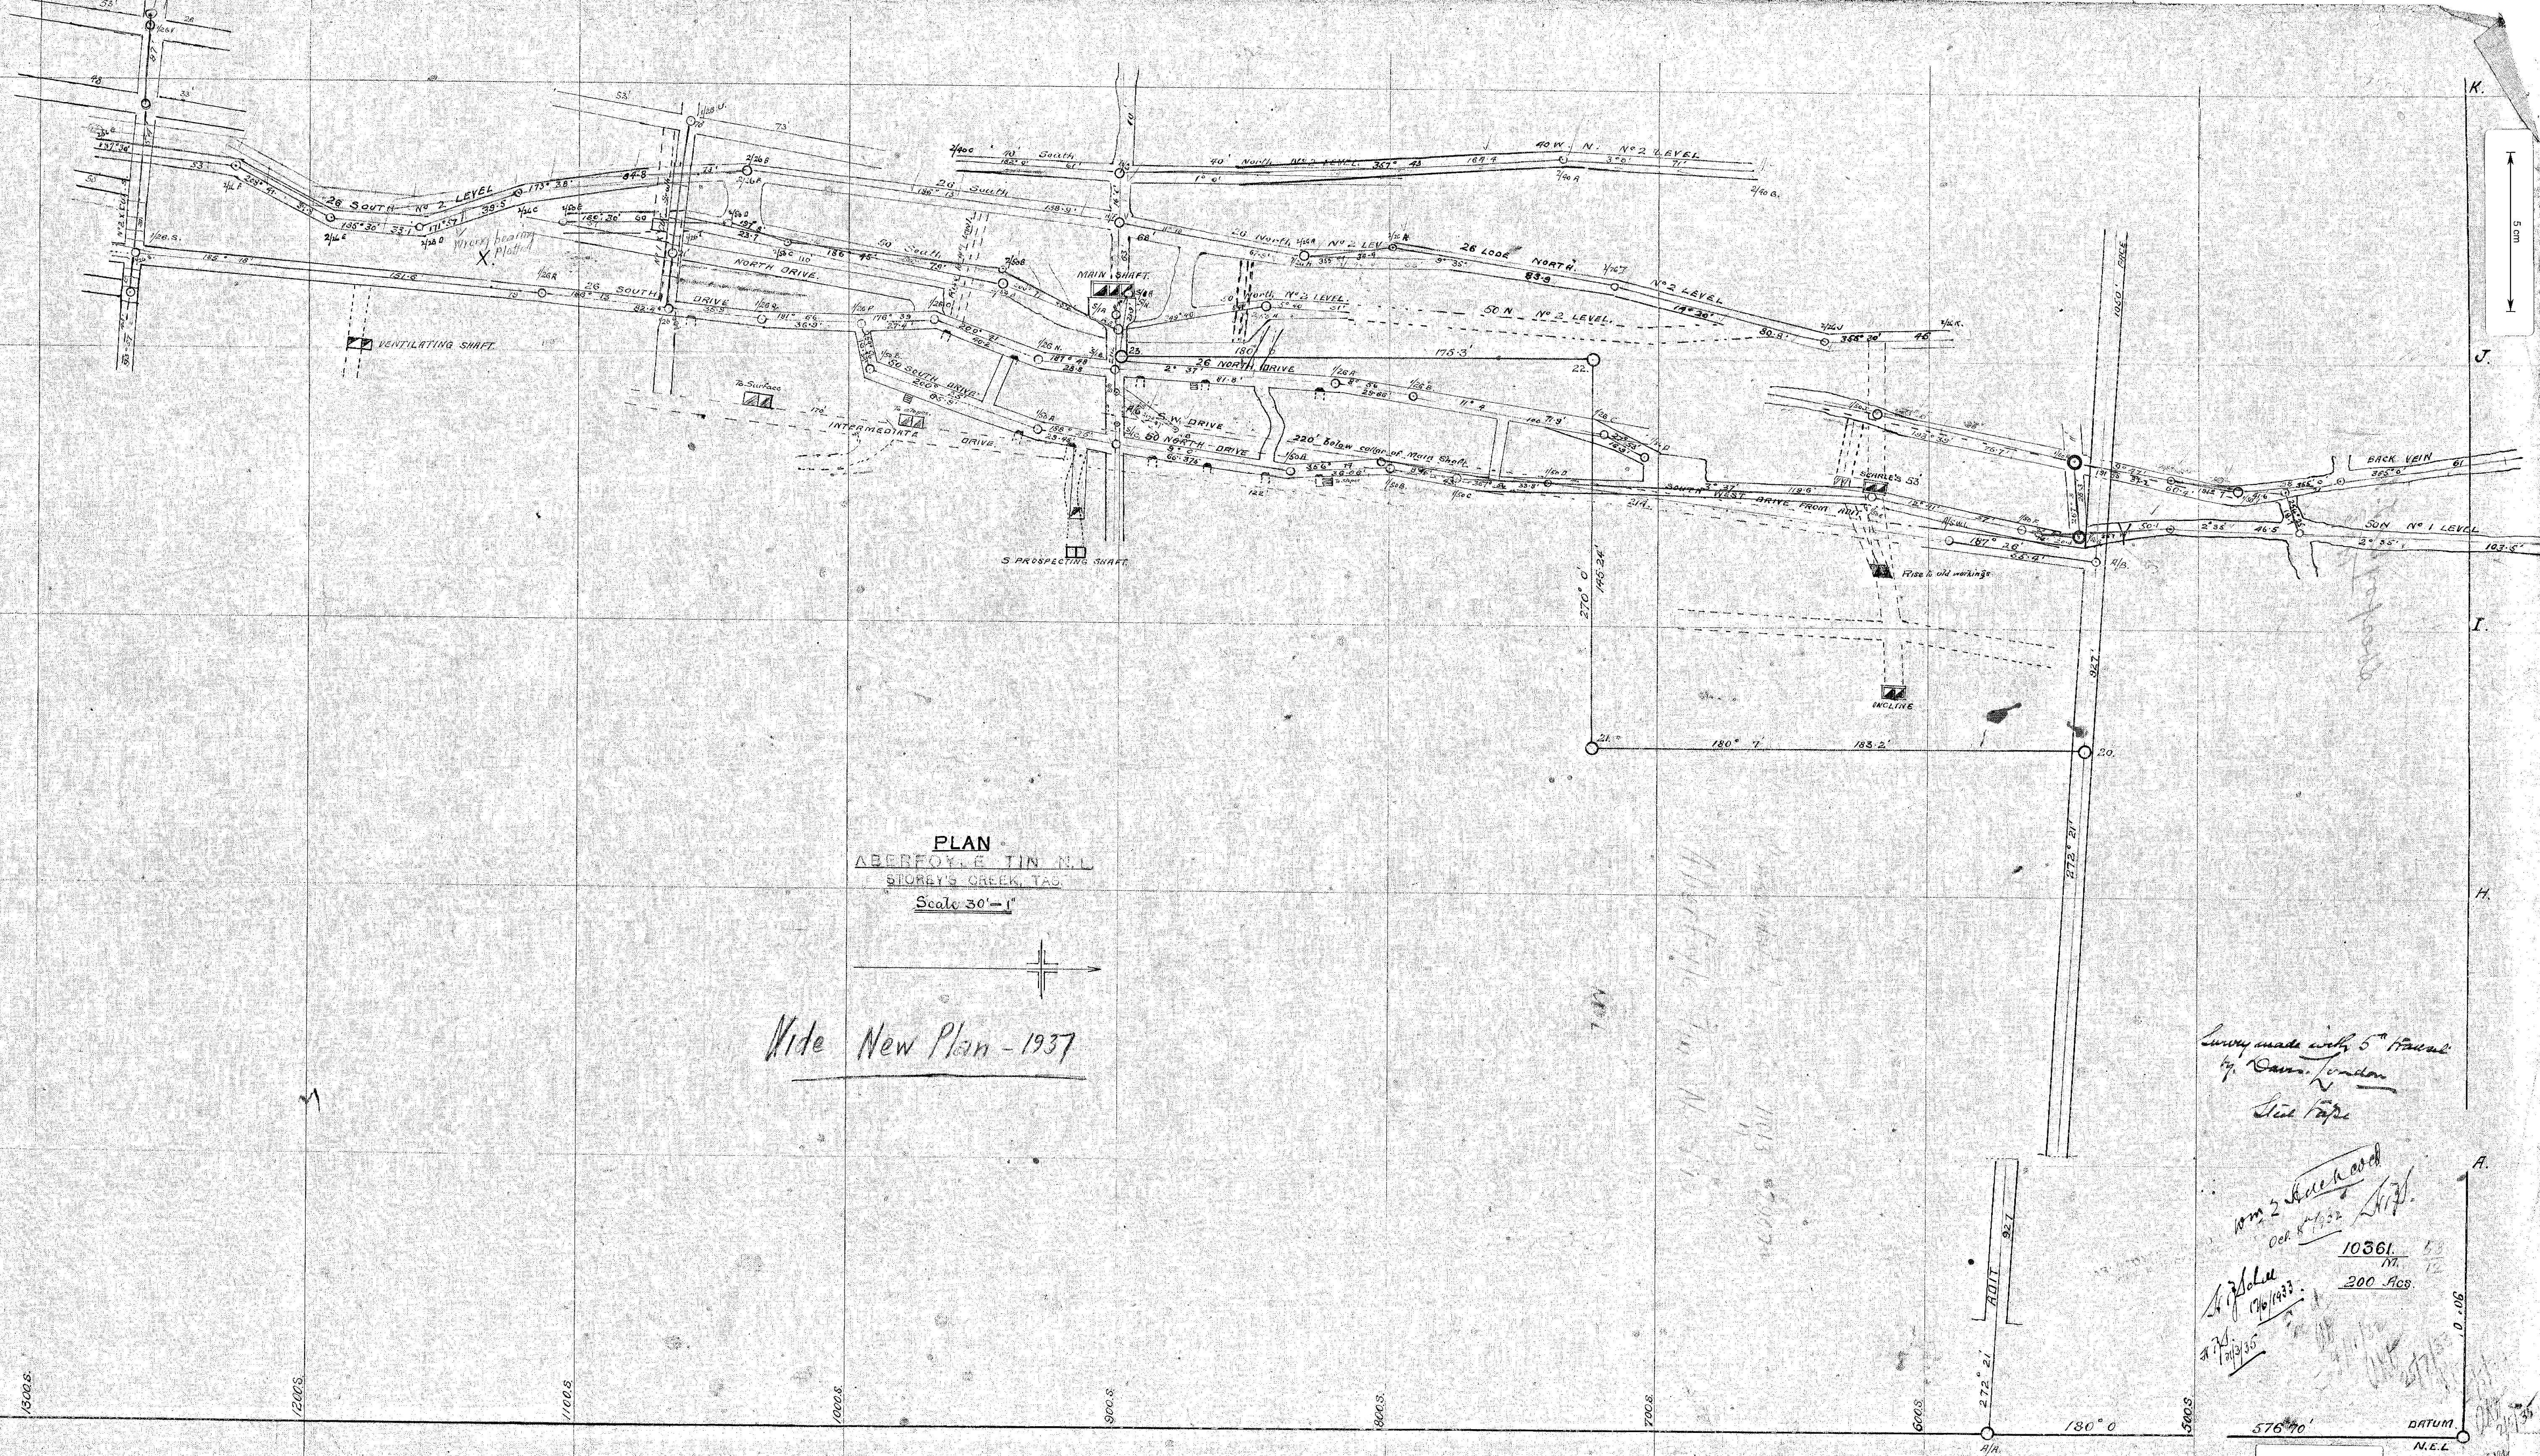

PLAN
ABERFOYLE TIN N.L.
Scale 30' = 1"

Vide New Plan - 1937

*Survey made with 5" Transit
See Page*

*10m 2 inch each
Oct 1933
10361
200 fcs*