


1-2

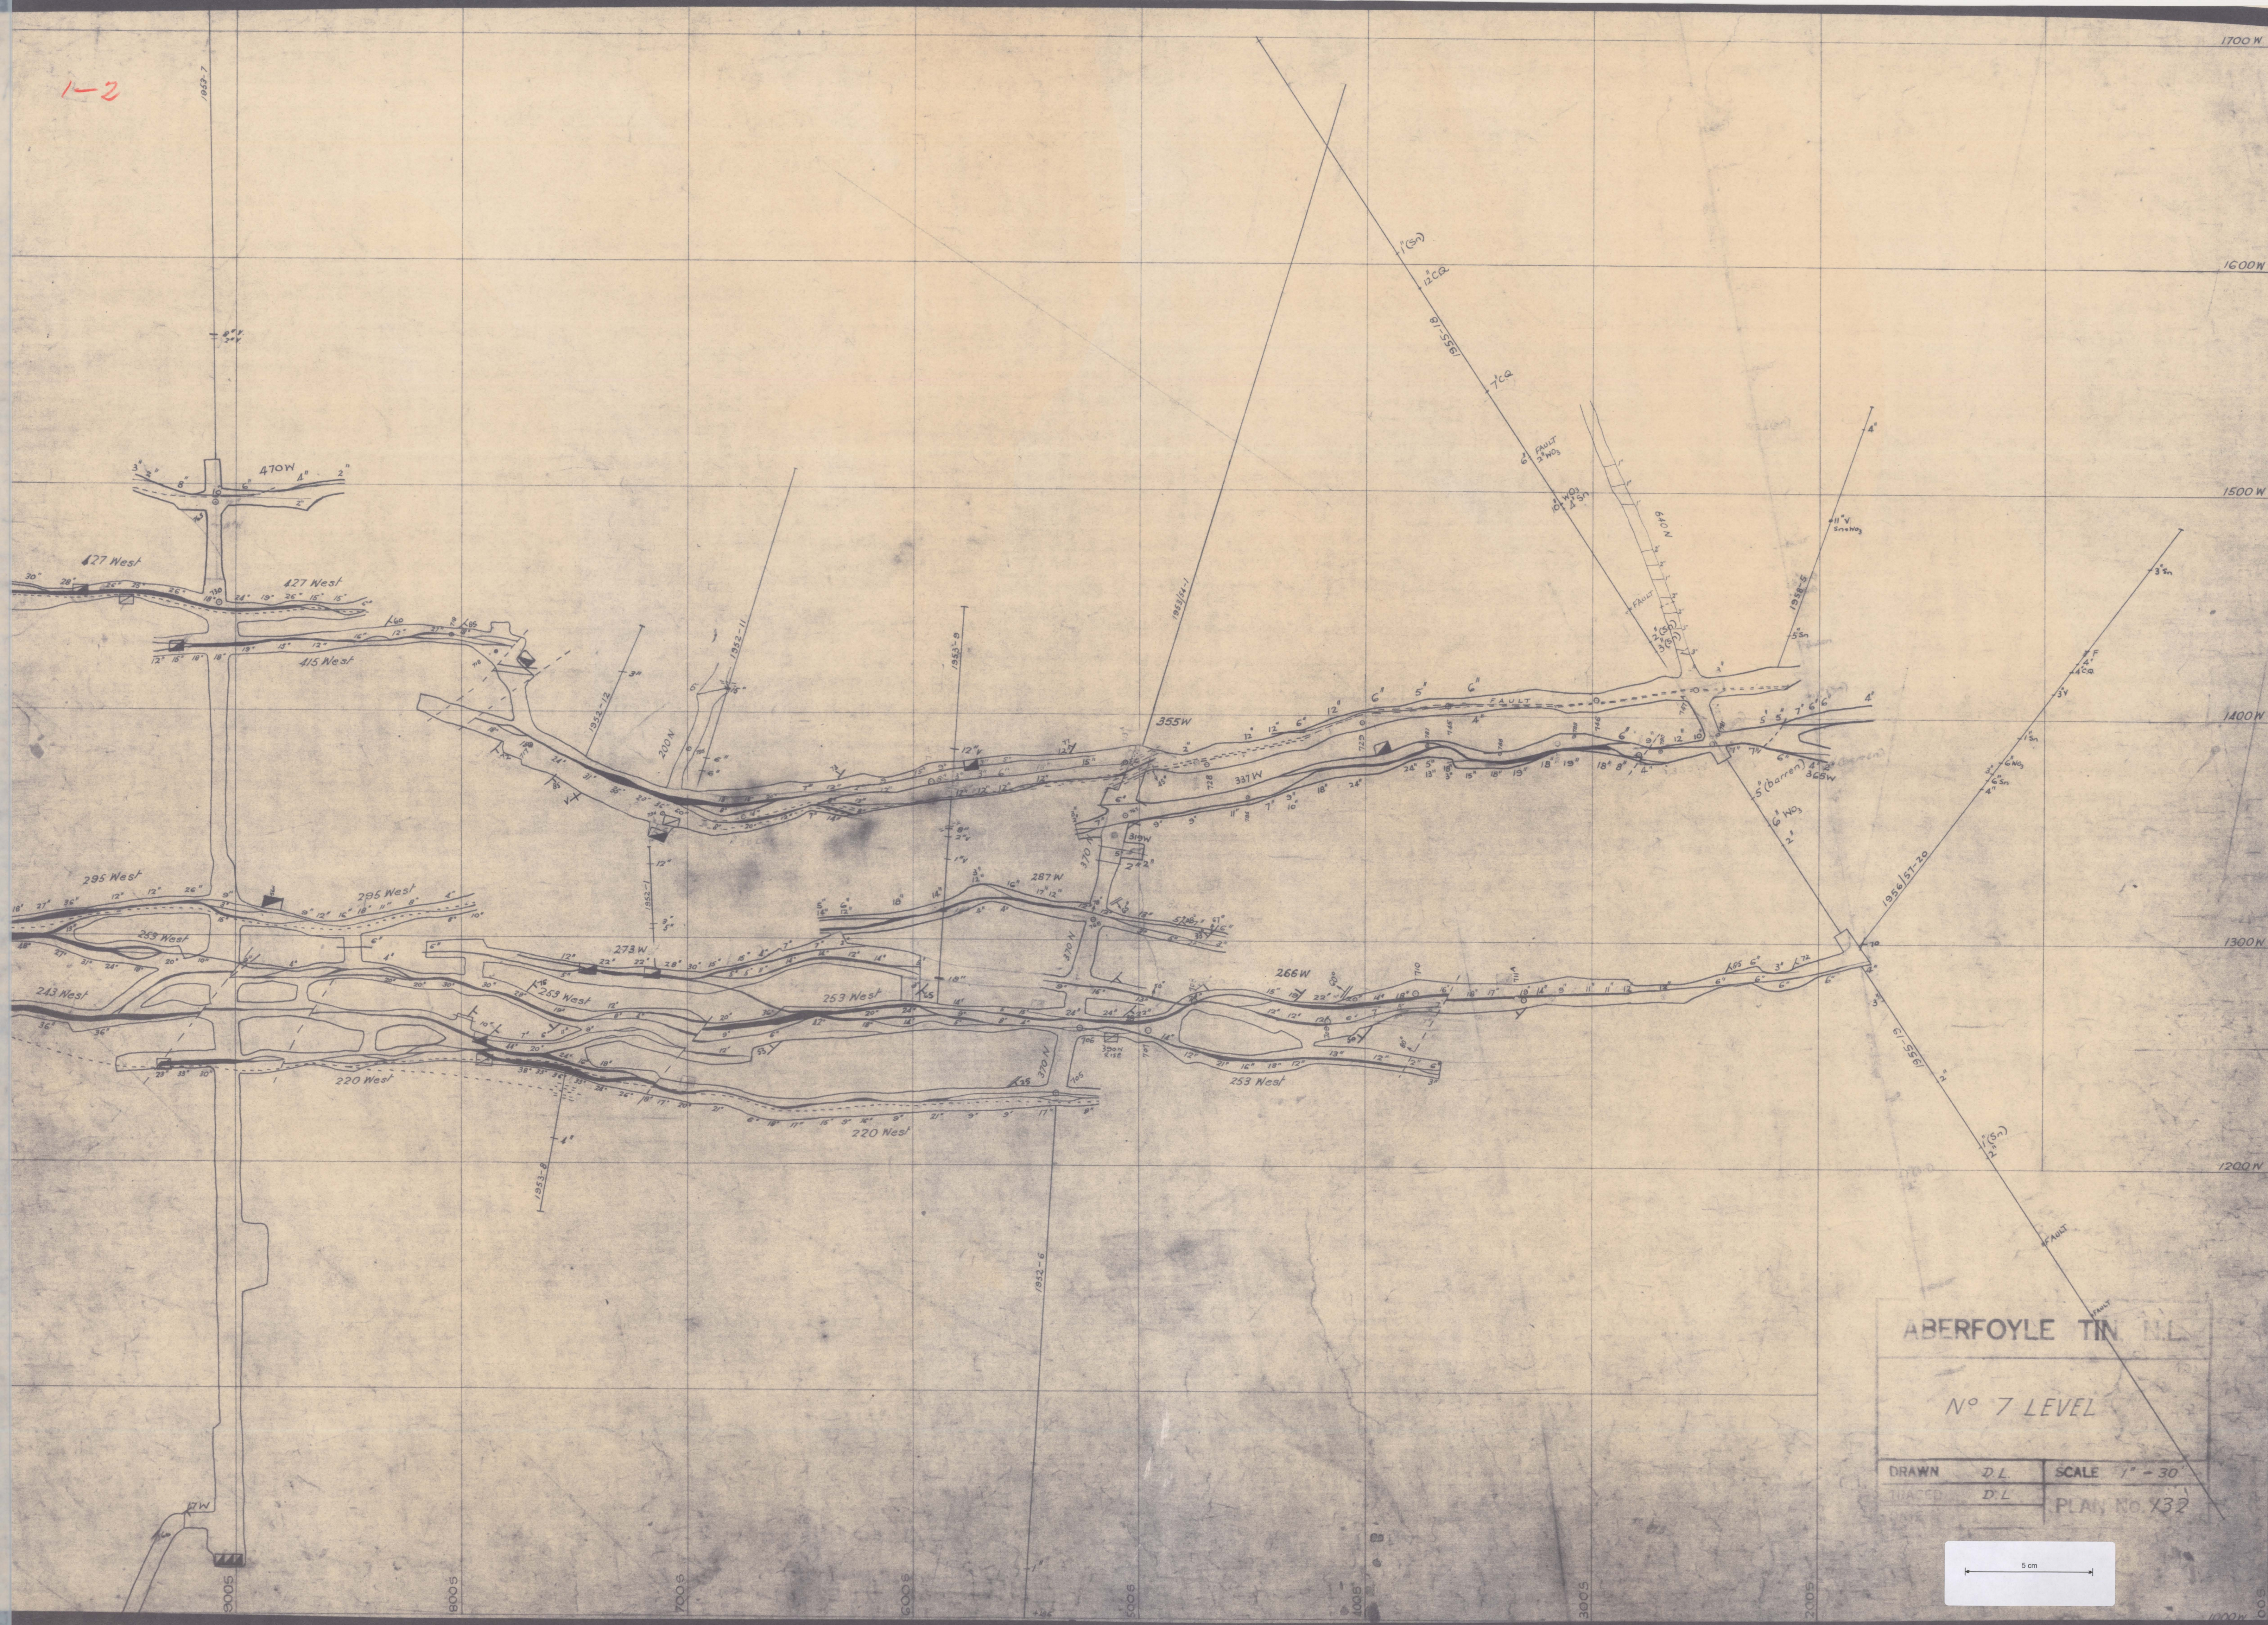

ABERFOYLE TIN MINE

No 7 LEVEL

DRAWN	D.L.	SCALE	1" = 30'
TRACED	D.L.	PLAN No	X32

