


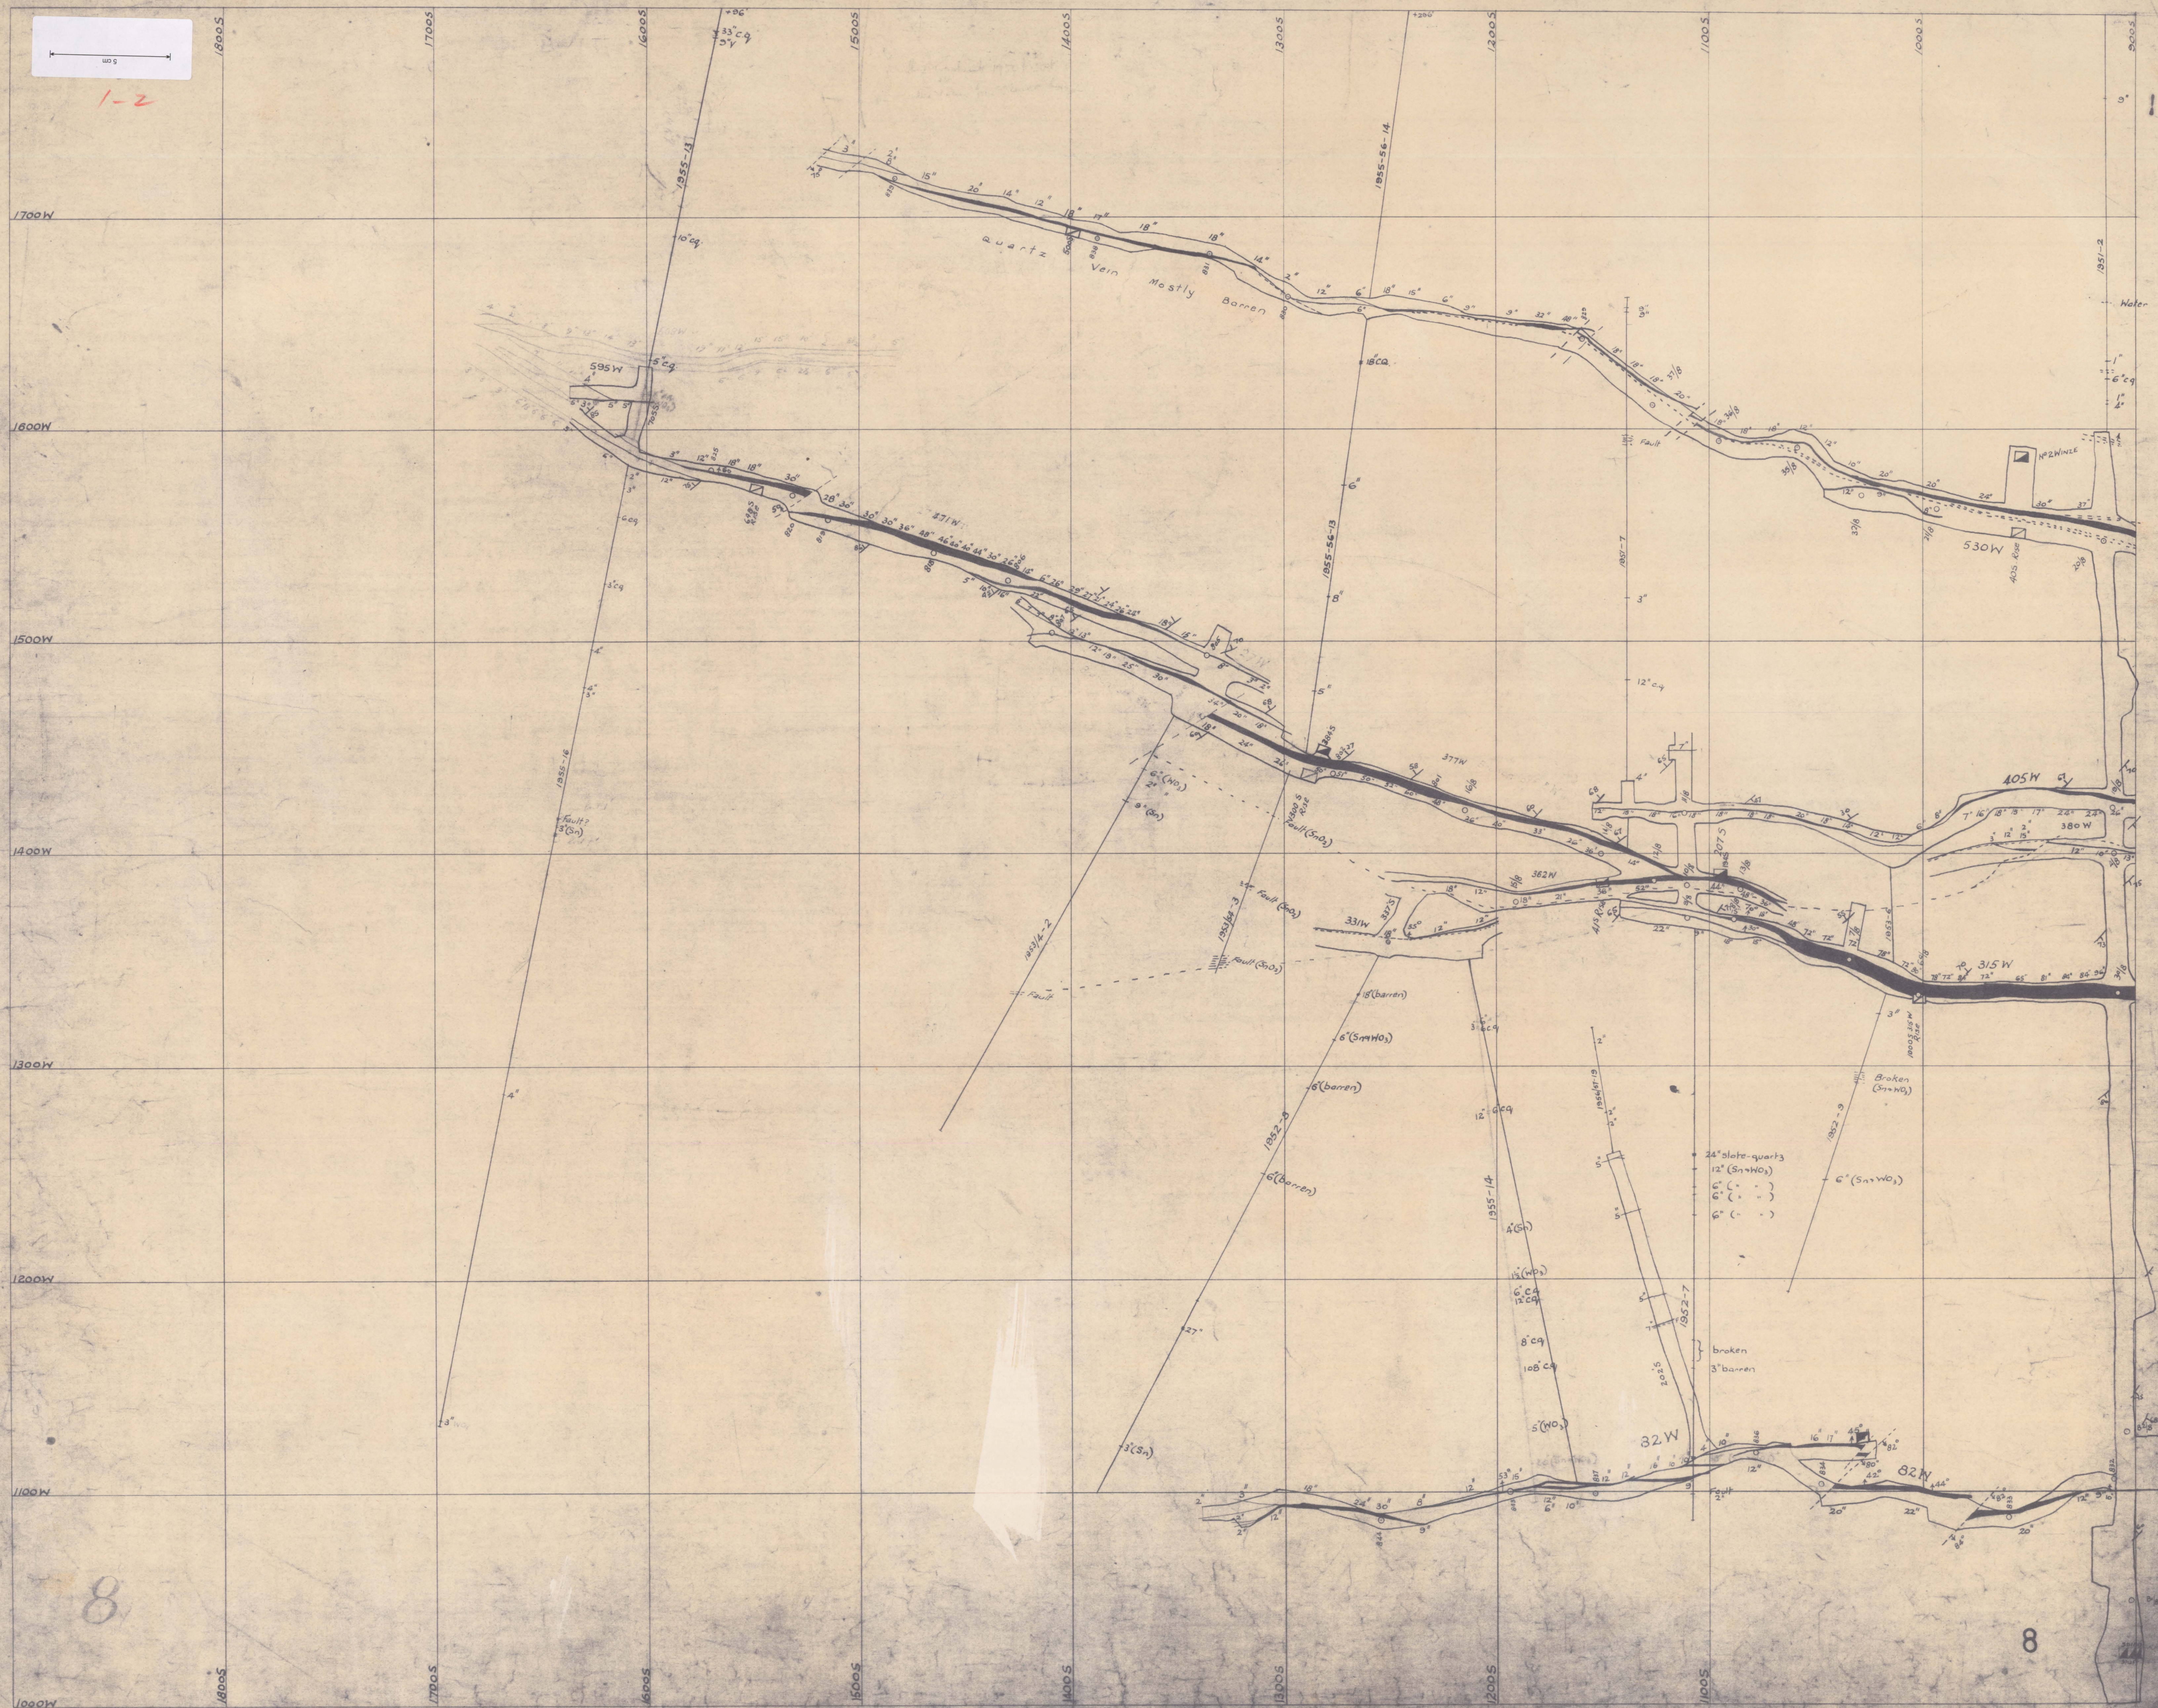

0023-034