


0023-052

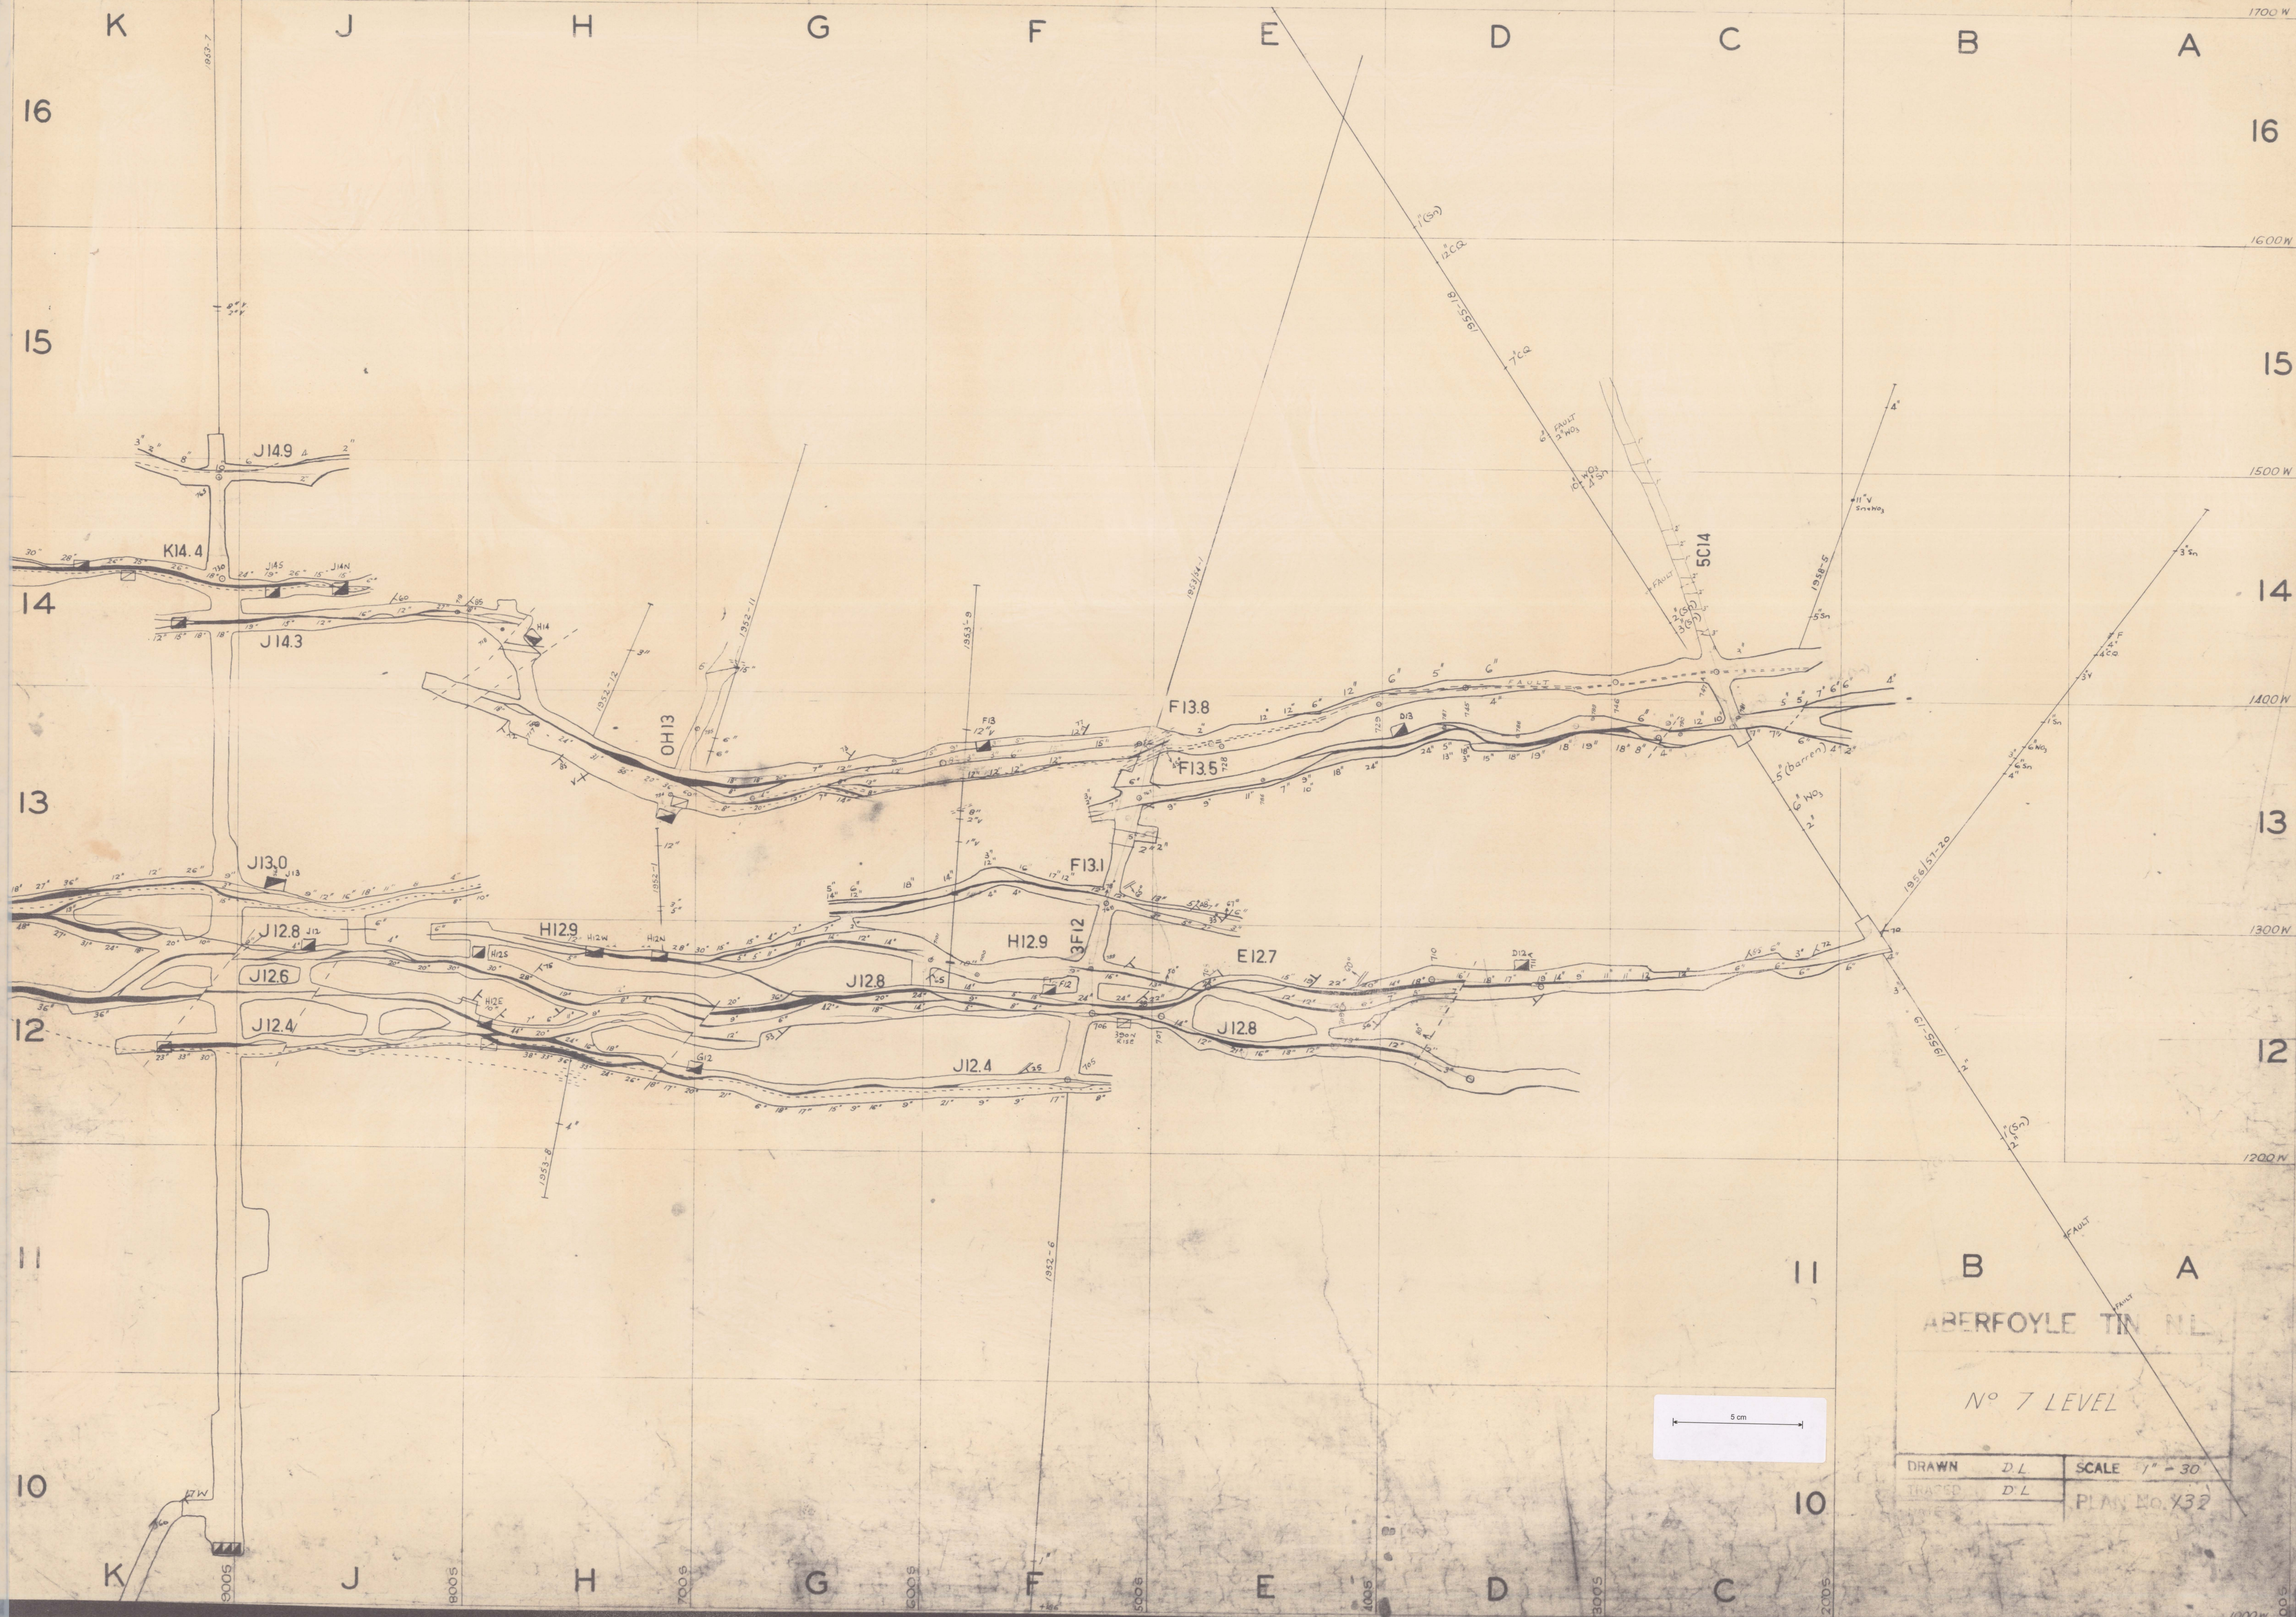

ABERFOYLE TIN MINE

No. 7 LEVEL

DRAWN	D.L.	SCALE	1" = 30'
TRACED	D.L.	PLAN No. X32	