


0023-056

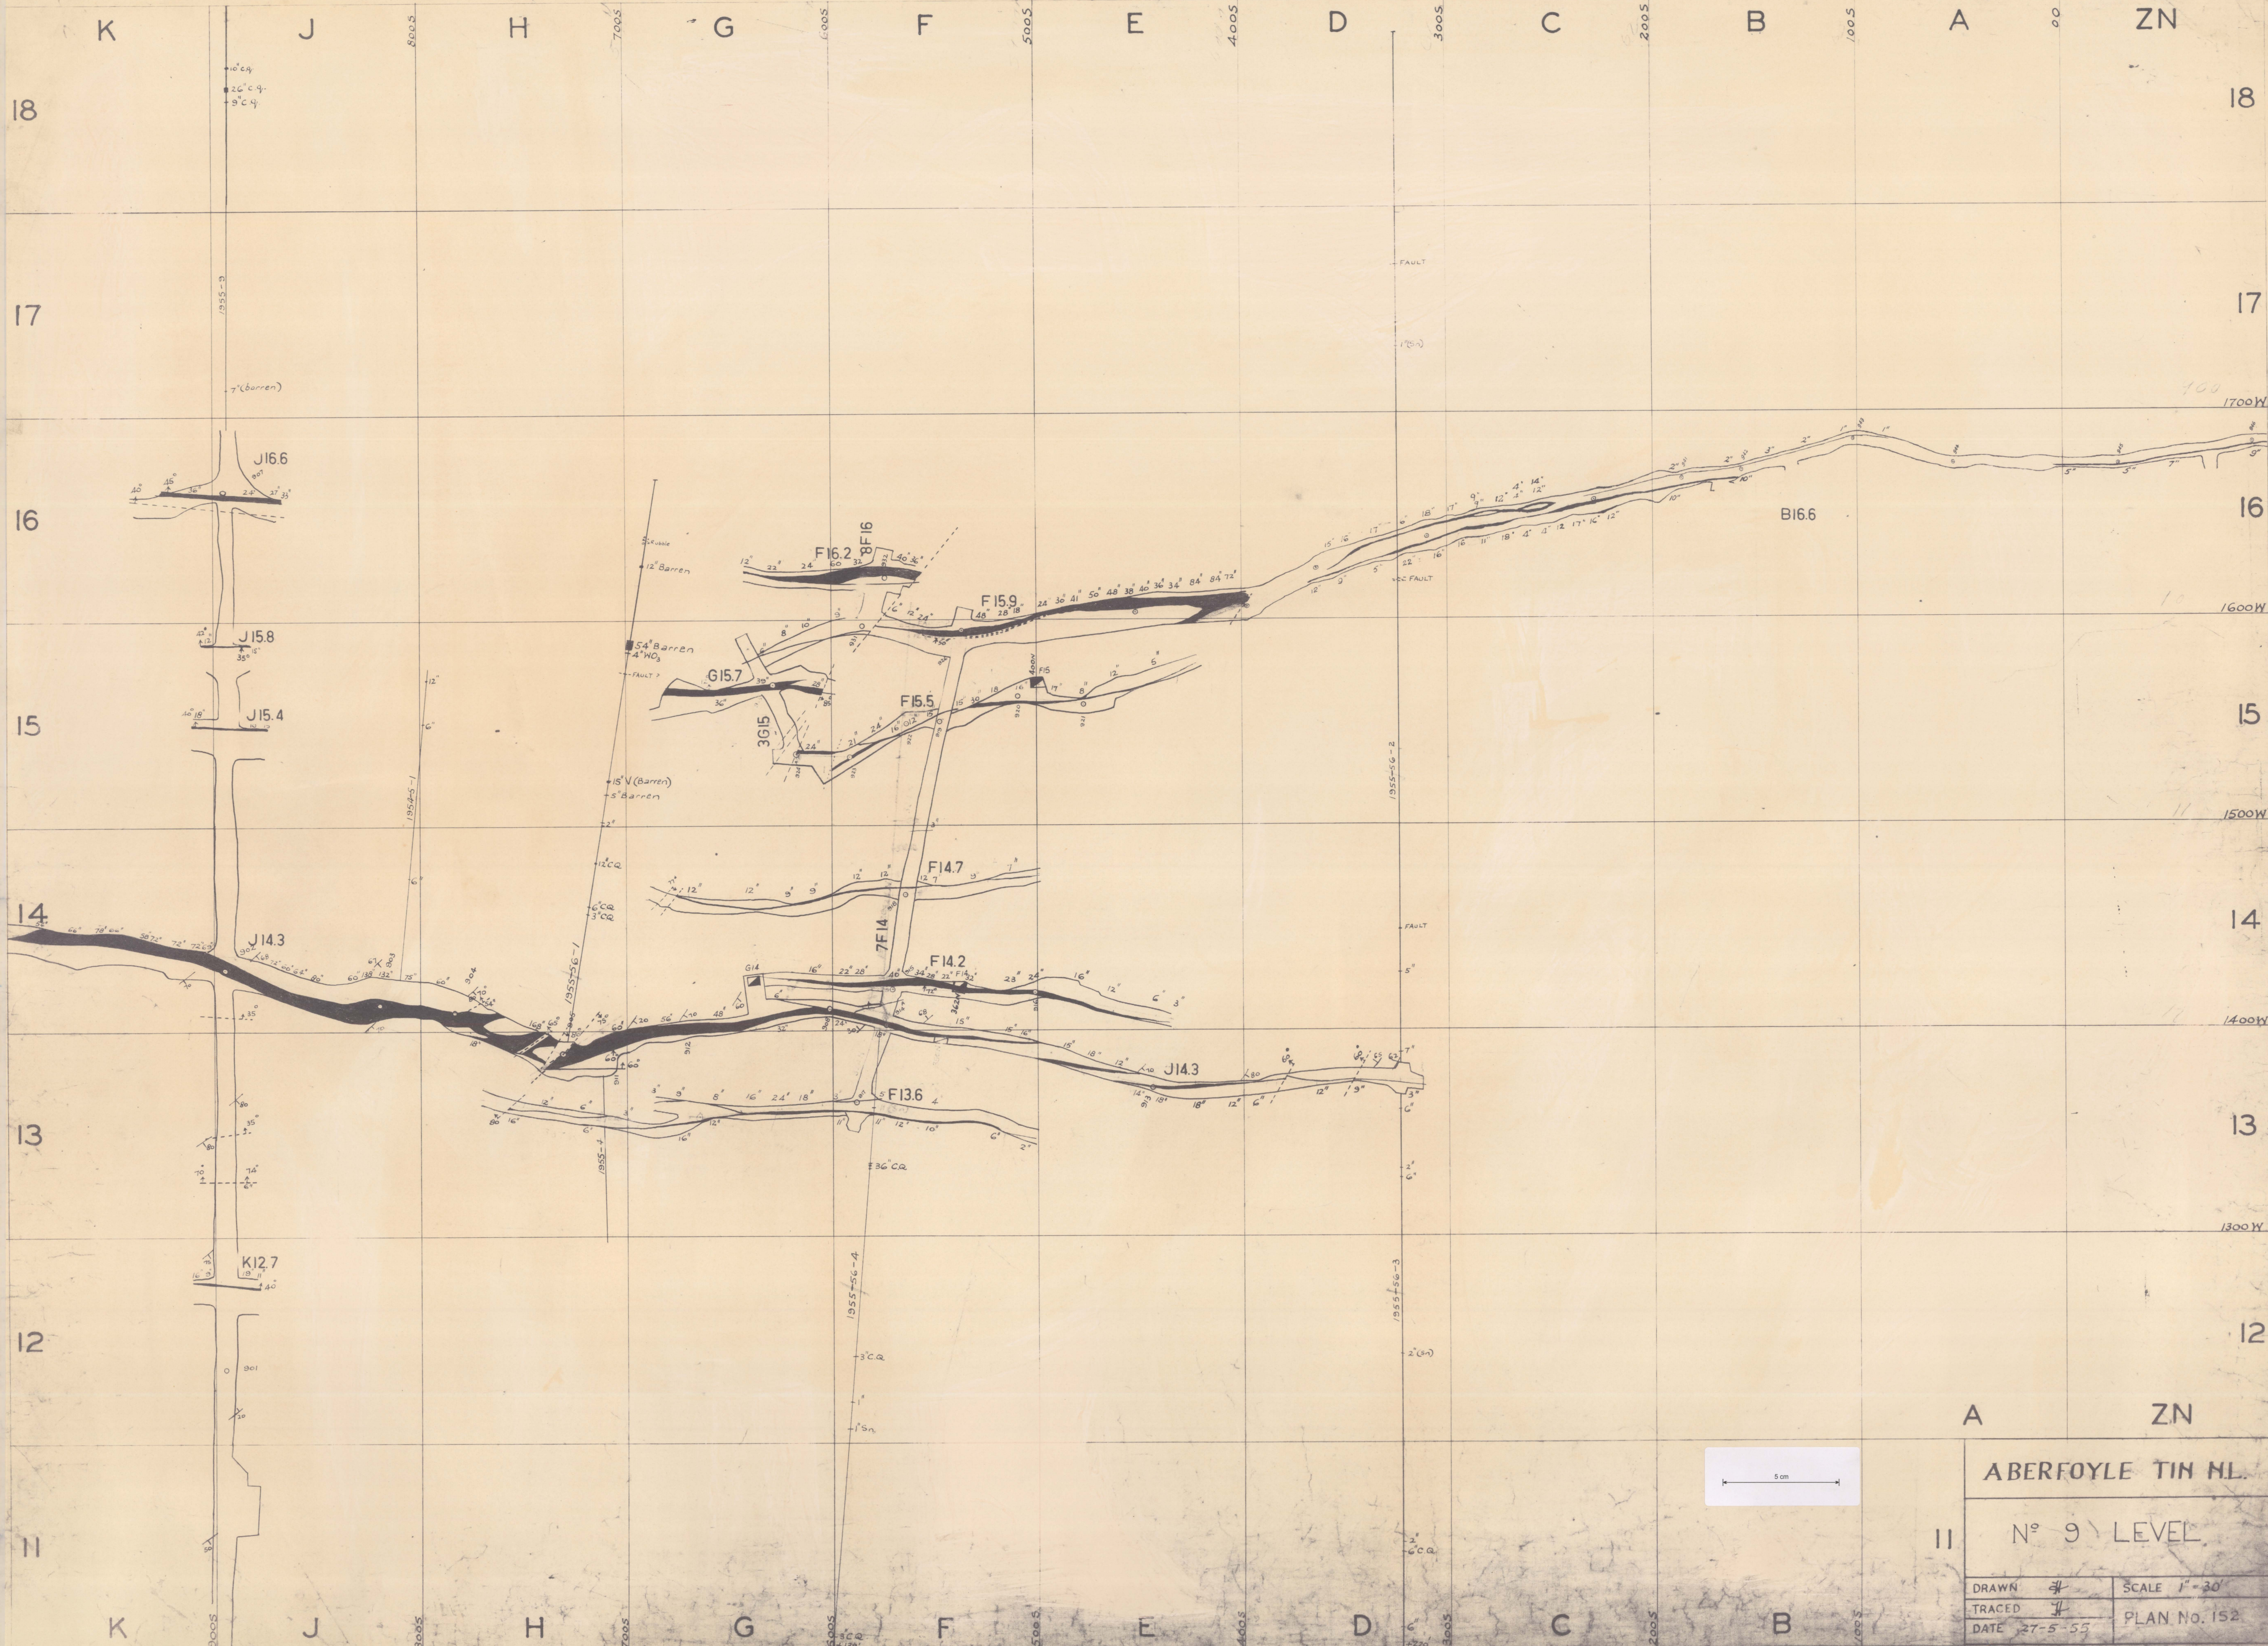

II		ABERFOYLE TIN NL.	
		N° 9 LEVEL	
DRAWN	#	SCALE	1" = 30'
TRACED	#	PLAN No. 152	
DATE	27-5-55		